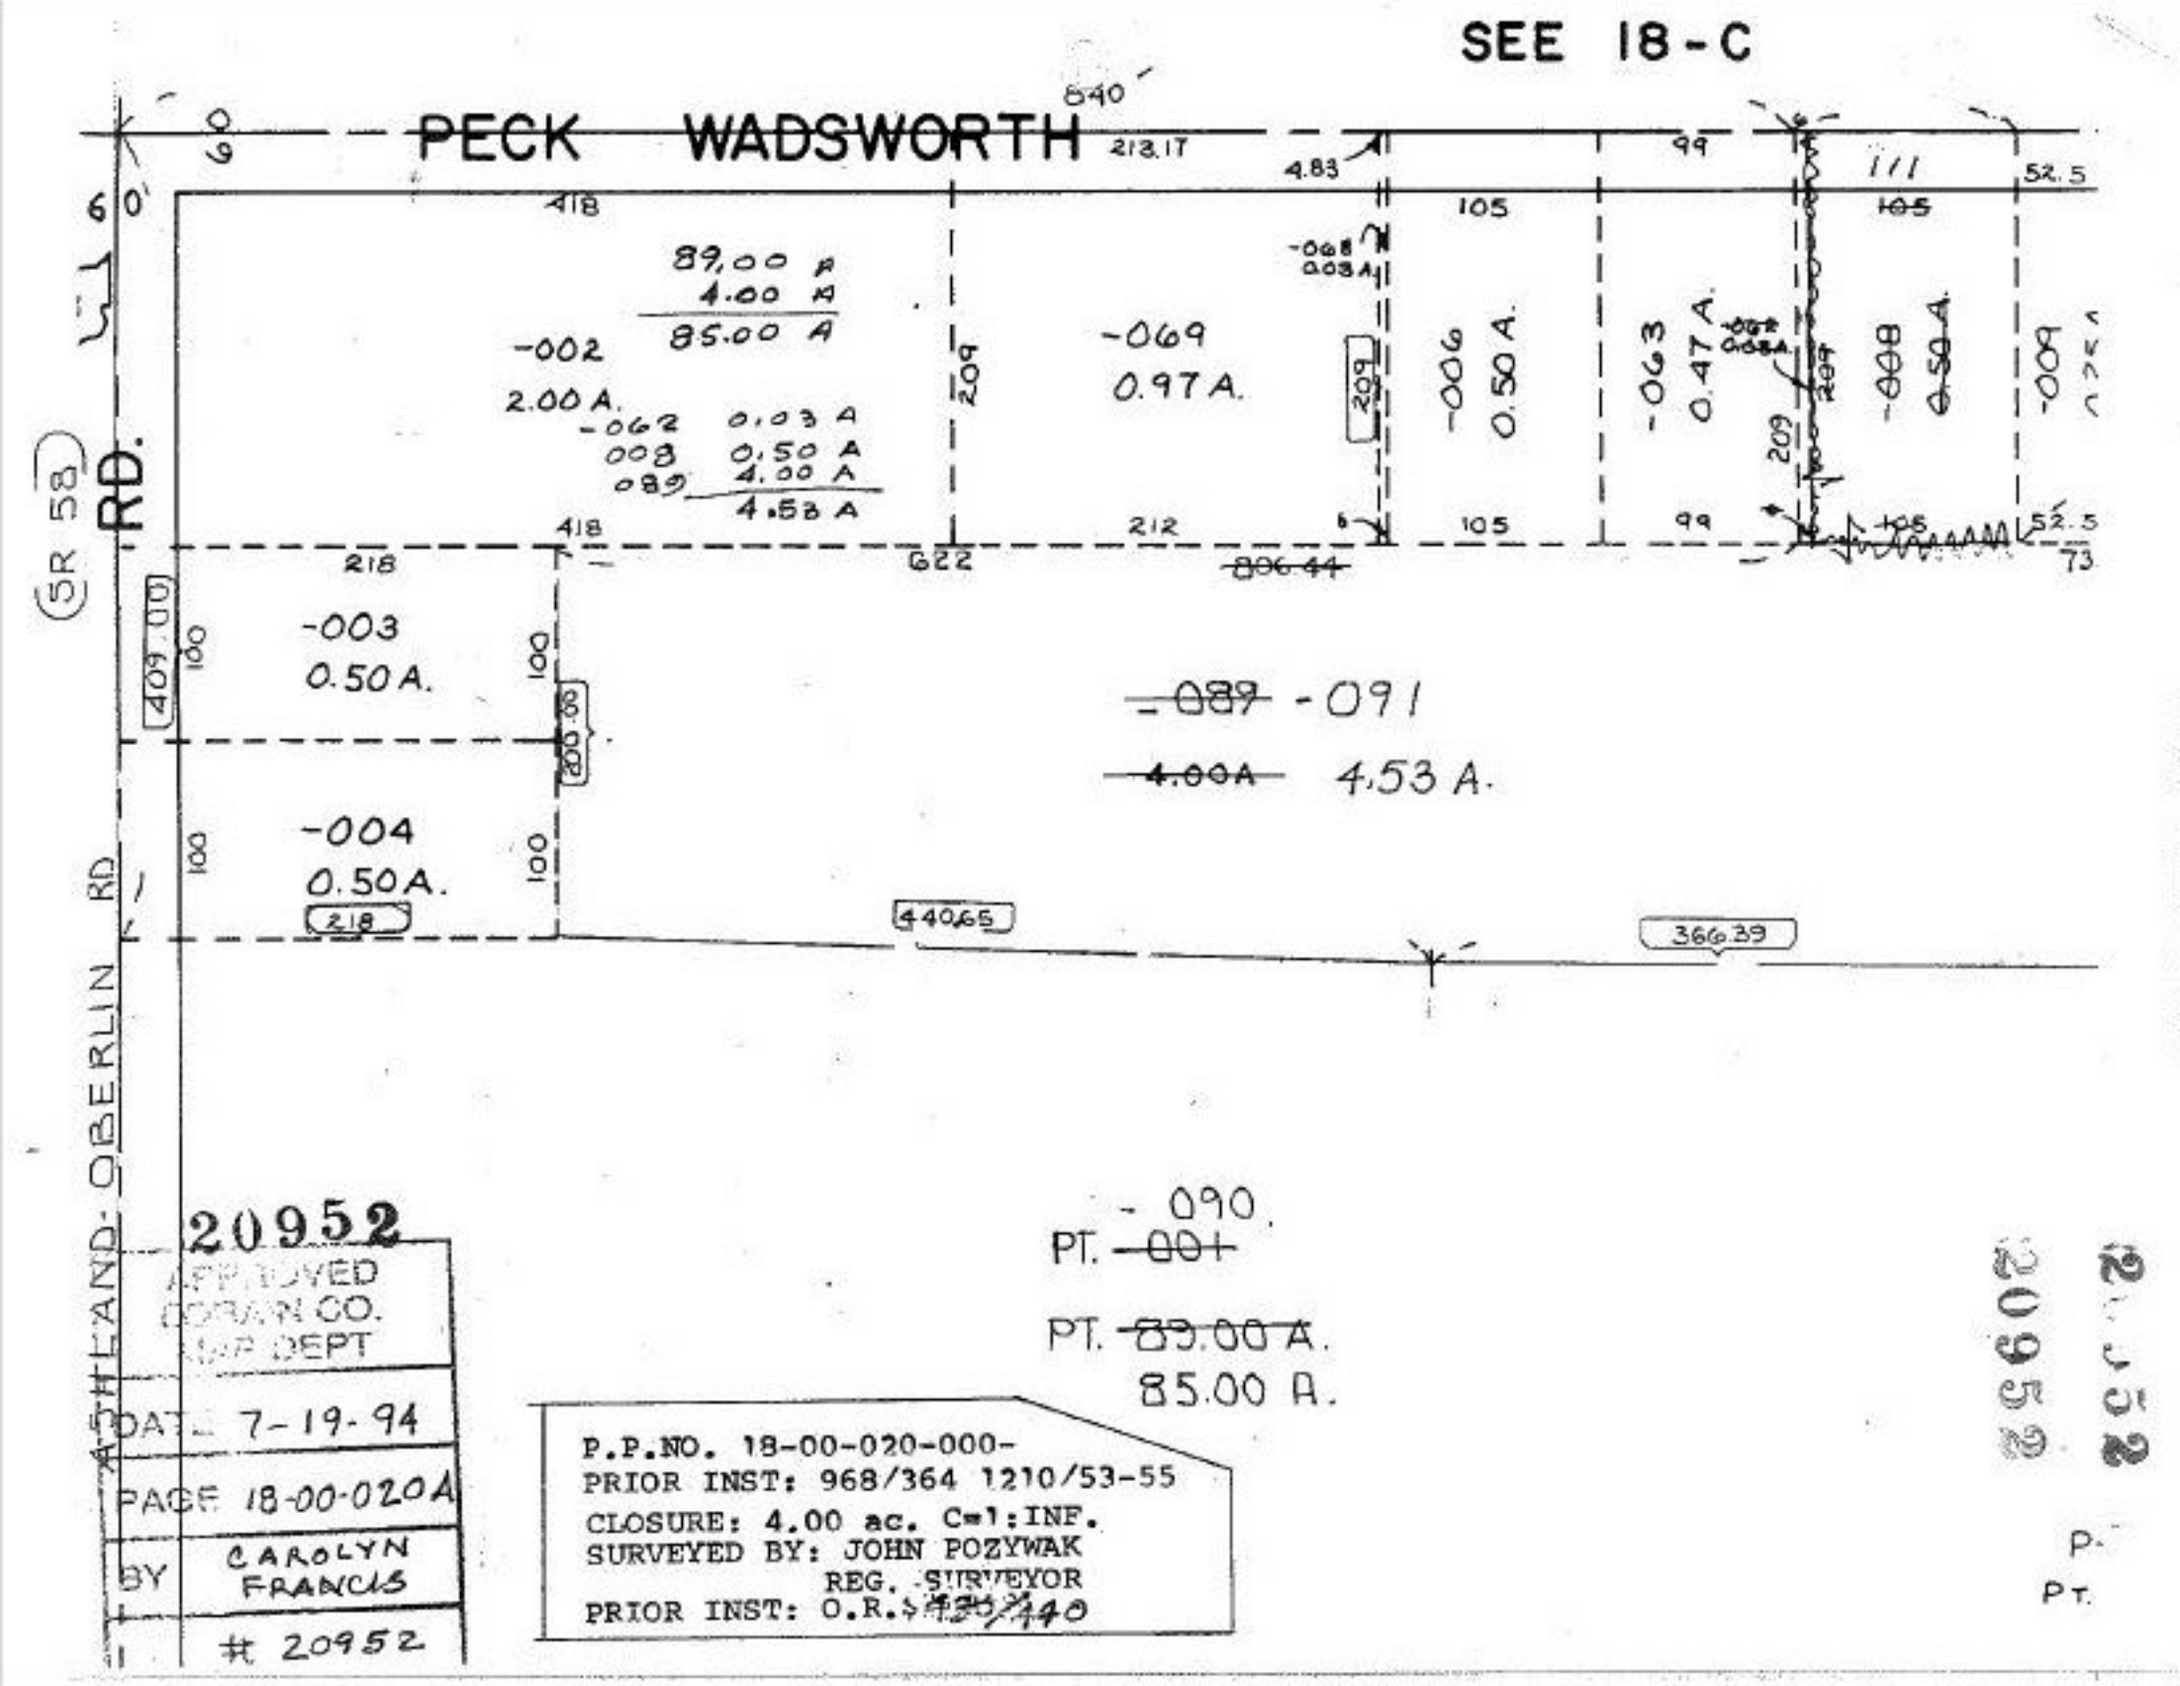
SEE 18-C
PECK
WADSWORTH
640'
213.17
4.83
99
111
52.5
105
418
89.00 A
4.00 A
85.00 A
-002
2.00 A.
-062 0.03 A
008 0.50 A
089 4.00 A
4.53 A
209
-069
0.97 A.
-006
0.50 A.
-063
0.47 A.
-008
0.50 A.
-009
212
622
806.44
73
(SR 58)
RD.
218
409.00
100
-003
0.50 A.
200.00
-004
0.50 A.
218
-089 -091
4.00A 4.53 A.
440.65
366.39
ASHLAND-OBERLIN RD
20952
APPROVED
DORAN CO.
MAP DEPT
DATE 7-19-94
PAGE 18-00-020A
BY CAROLYN FRANCIS
20952
P.P.NO. 18-00-020-000-
PRIOR INST: 968/364 1210/53-55
CLOSURE: 4.00 ac. C=1:INF.
SURVEYED BY: JOHN POZYWAK
REG. SURVEYOR
PRIOR INST: O.R. 430/440
- 090.
PT. -001
PT. 89.00 A.
85.00 A.
20952
PT.