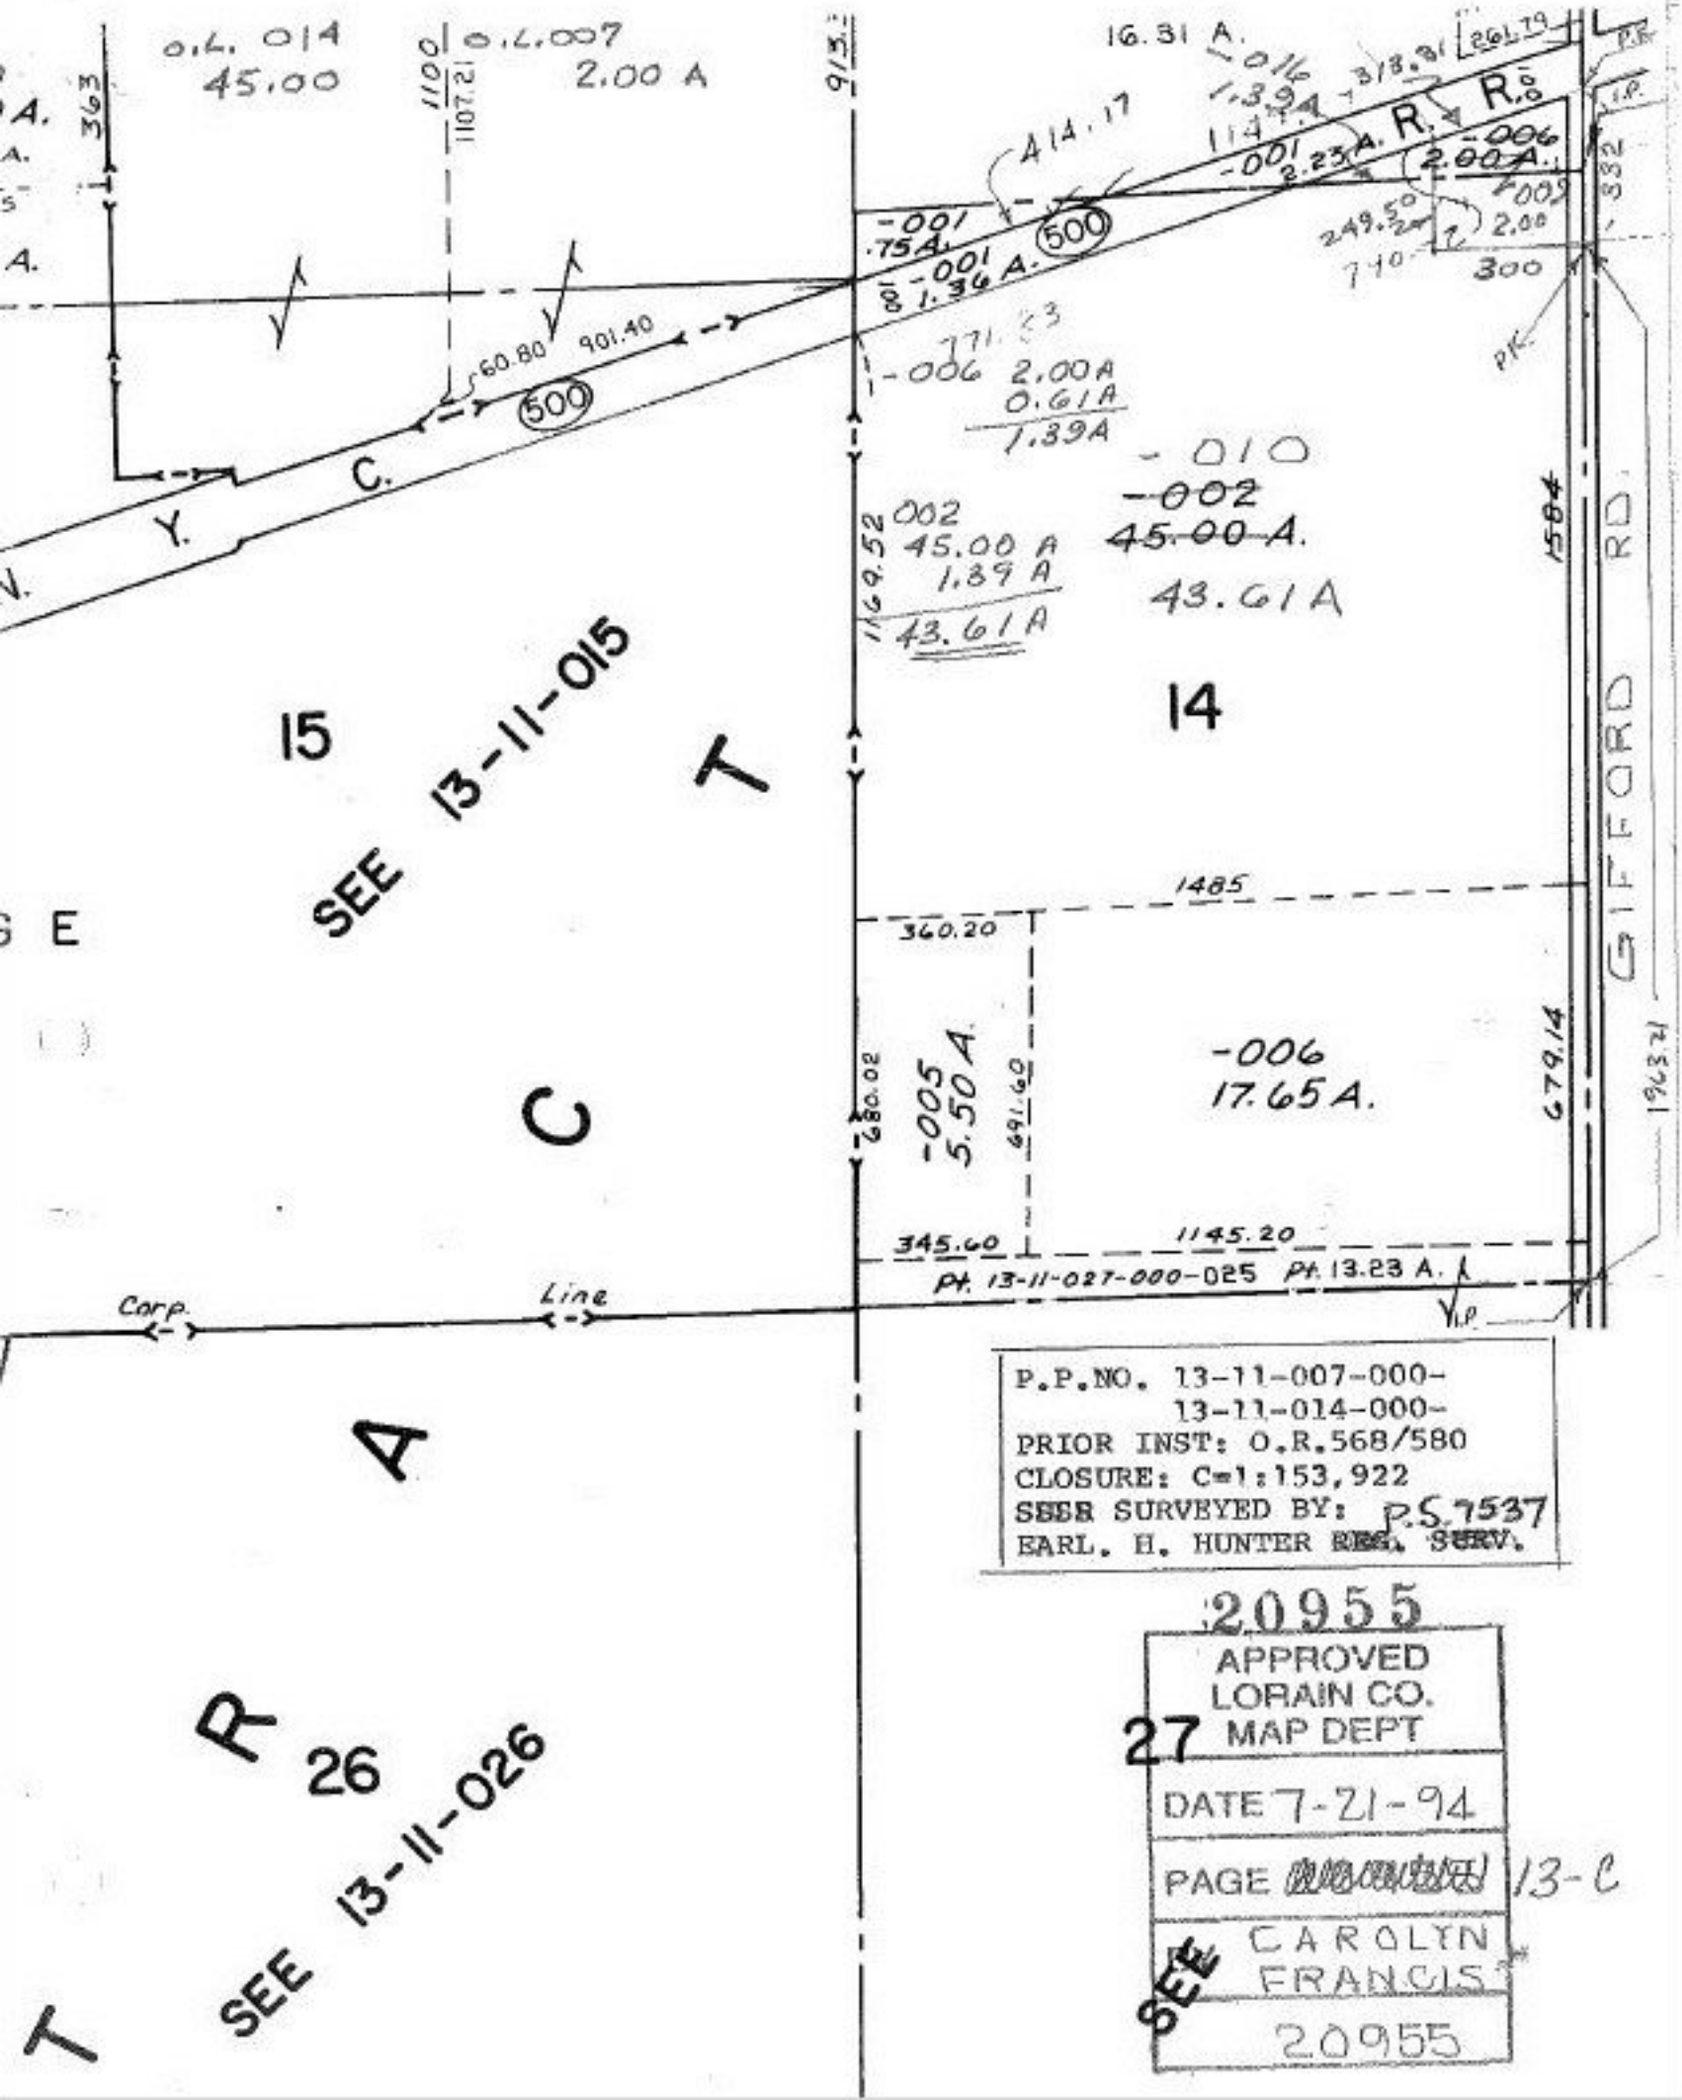
O.L. 014
45.00
O.L. 007
2.00 A
16.31 A.
-016
1.39 A.
-001
2.23 A.
-006
2.00 A.
-009
2.00
-001
.75 A.
-001
1.36 A.
500
-006 2.00A
0.61A
1.39A
-010
-002
45.00 A.
43.61A
002
45.00 A
1.39 A
43.61A
15
14
SEE 13-11-015
SEE 13-11-026
C
A
R
T
-005
5.50 A.
-006
17.65 A.
1485
360.20
345.60
1145.20
679.14
1584
680.02
691.60
1169.52
771.63
901.40
60.80
1100
1107.21
363
913.3
A14.17
318.81
261.79
249.50
710
300
332
1963.71
GIFFORD RD.
Corp. Line
Pt. 13-11-027-000-025 Pt. 13.23 A.
P.P.NO. 13-11-007-000-
13-11-014-000-
PRIOR INST: O.R.568/580
CLOSURE: C=1:153,922
SURVEYED BY: P.S.7537
EARL. H. HUNTER REG. SURV.
20955
APPROVED
LORAIN CO.
MAP DEPT
DATE 7-21-94
PAGE 13-C
CAROLYN FRANCIS
20955
SEE
27