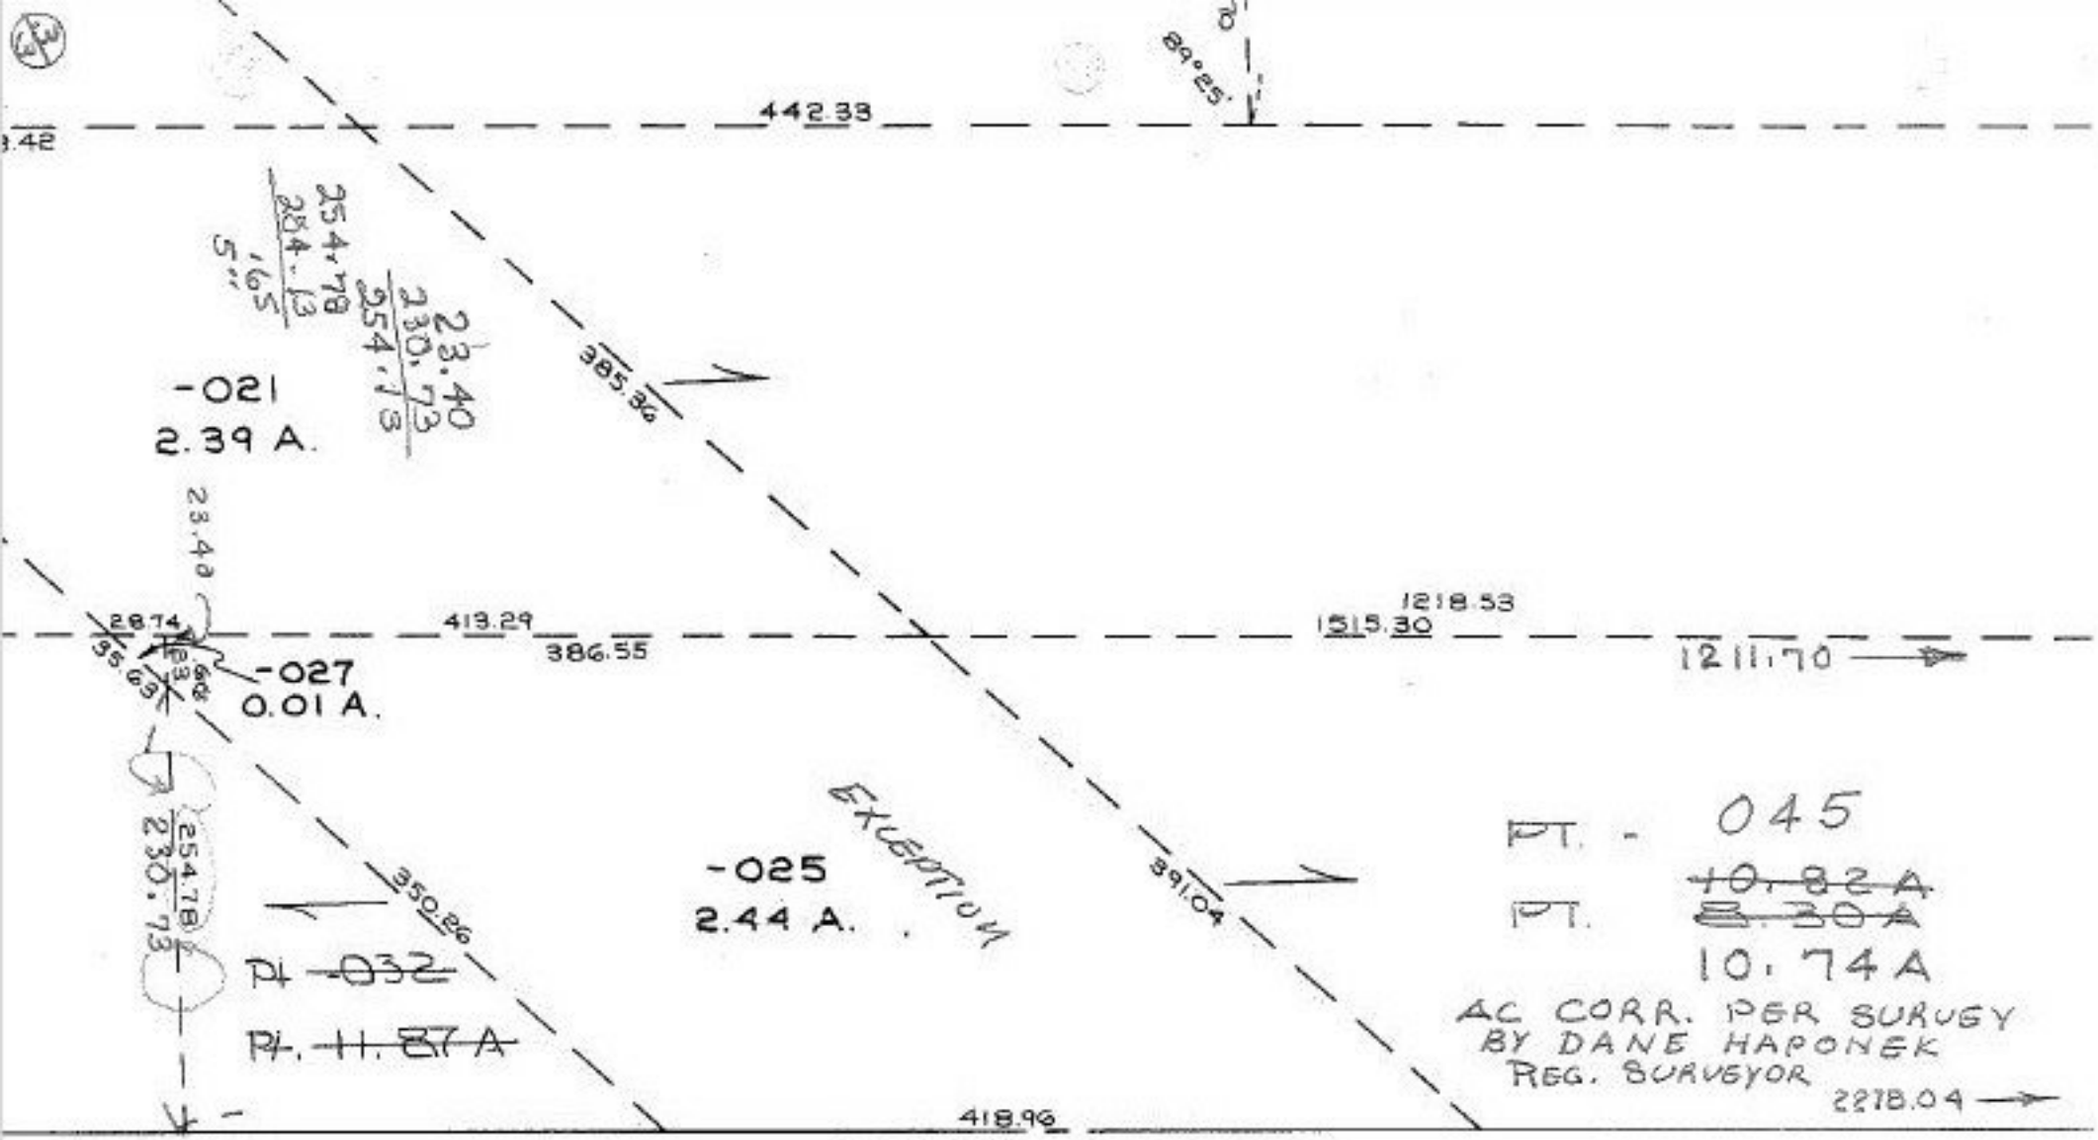

PT ~~-032~~
PT. ~~11.87 A~~

SEE 7-

P.P.NO. 07-00-023-102-
PRIOR INST: O.R.788/374

S-12-95
20956
APPROVED
LORAIN CO.
MAP DEPT
DATE 7-20-94
PAGE 7-00-023-D
BY CAROLYN FRANCIS
20956