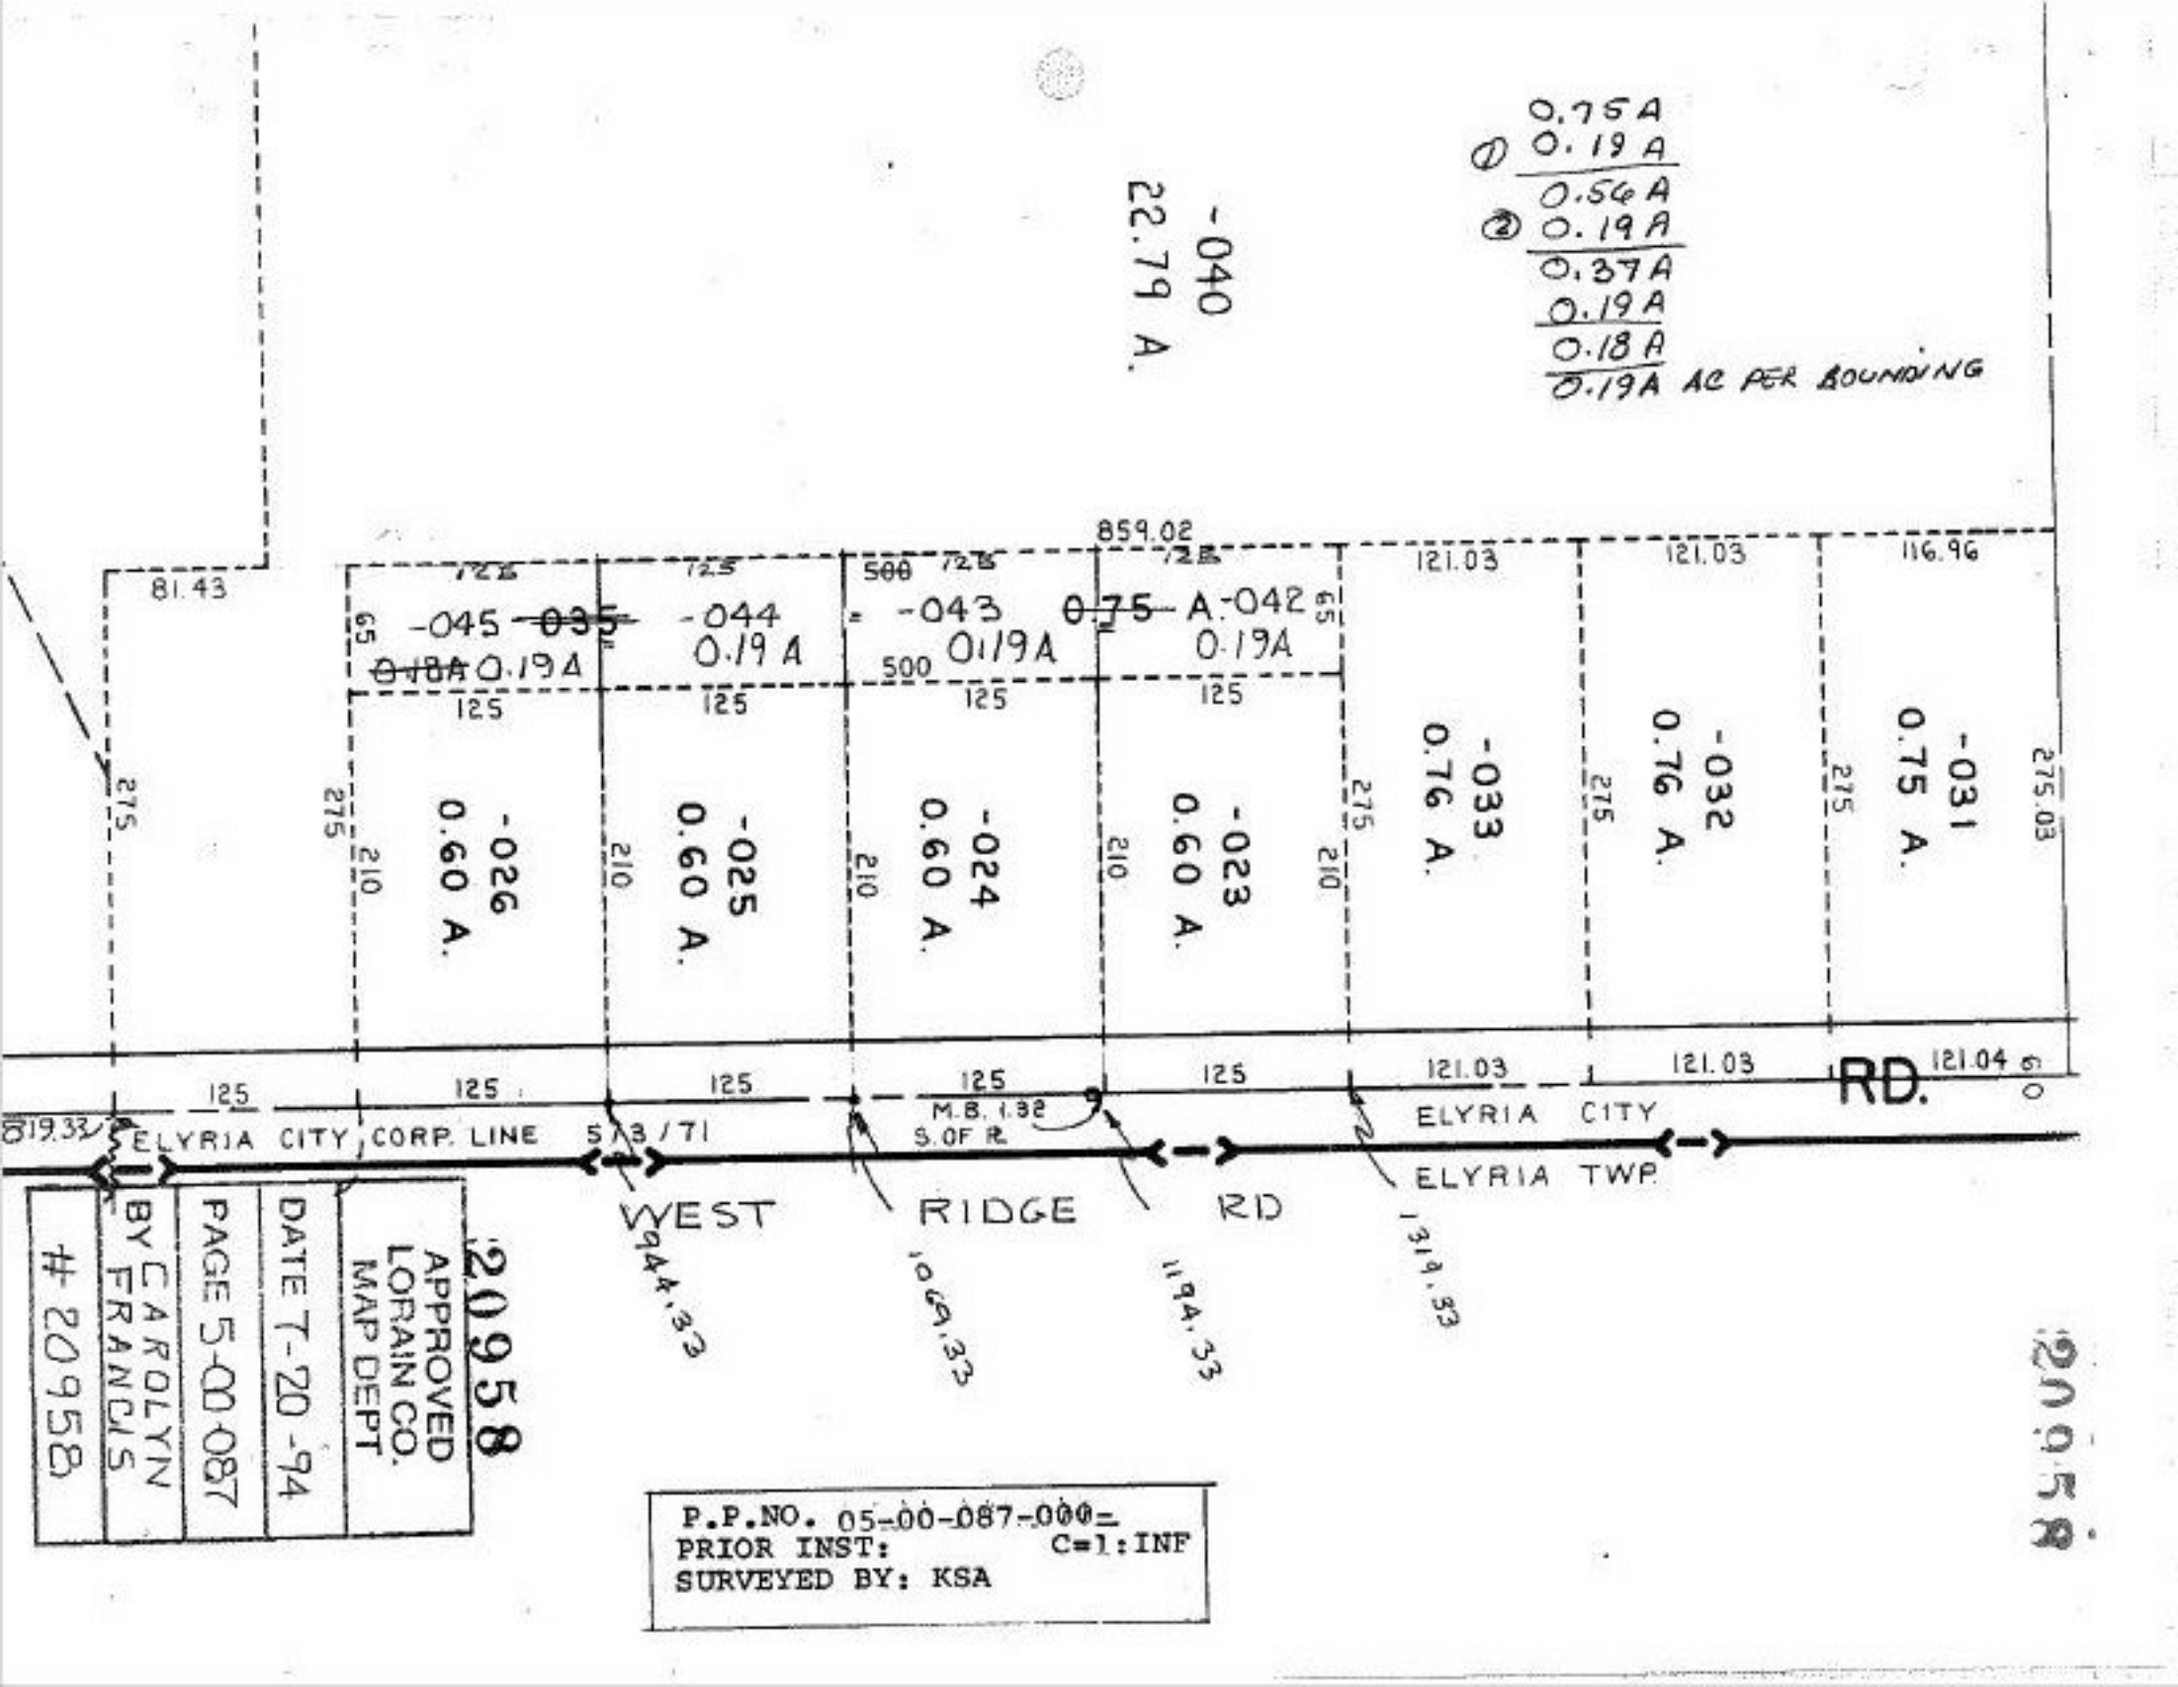
0.75A
① 0.19A
0.56A
② 0.19A
0.37A
0.19A
0.18A
0.19A AC PER BOUNDING
-040
22.79 A.
859.02
81.43
-045 0.19A
-044 0.19A
-043 0.19A
-042 0.19A
-026 0.60 A.
-025 0.60 A.
-024 0.60 A.
-023 0.60 A.
-033 0.76 A.
-032 0.76 A.
-031 0.75 A.
121.03
116.96
275.03
819.32
ELYRIA CITY CORP. LINE
573/71
M.B. 1.32 S.OF R.
ELYRIA CITY
ELYRIA TWP.
RD.
121.04
WEST
RIDGE
RD
944.33
1069.33
1194.33
1314.53
20958
APPROVED LORAIN CO. MAP DEPT
DATE 7-20-94
PAGE 5-00-087
BY CAROLYN FRANCIS
20958
P.P.NO. 05-00-087-000=
PRIOR INST:
C=1:INF
SURVEYED BY: KSA
20958