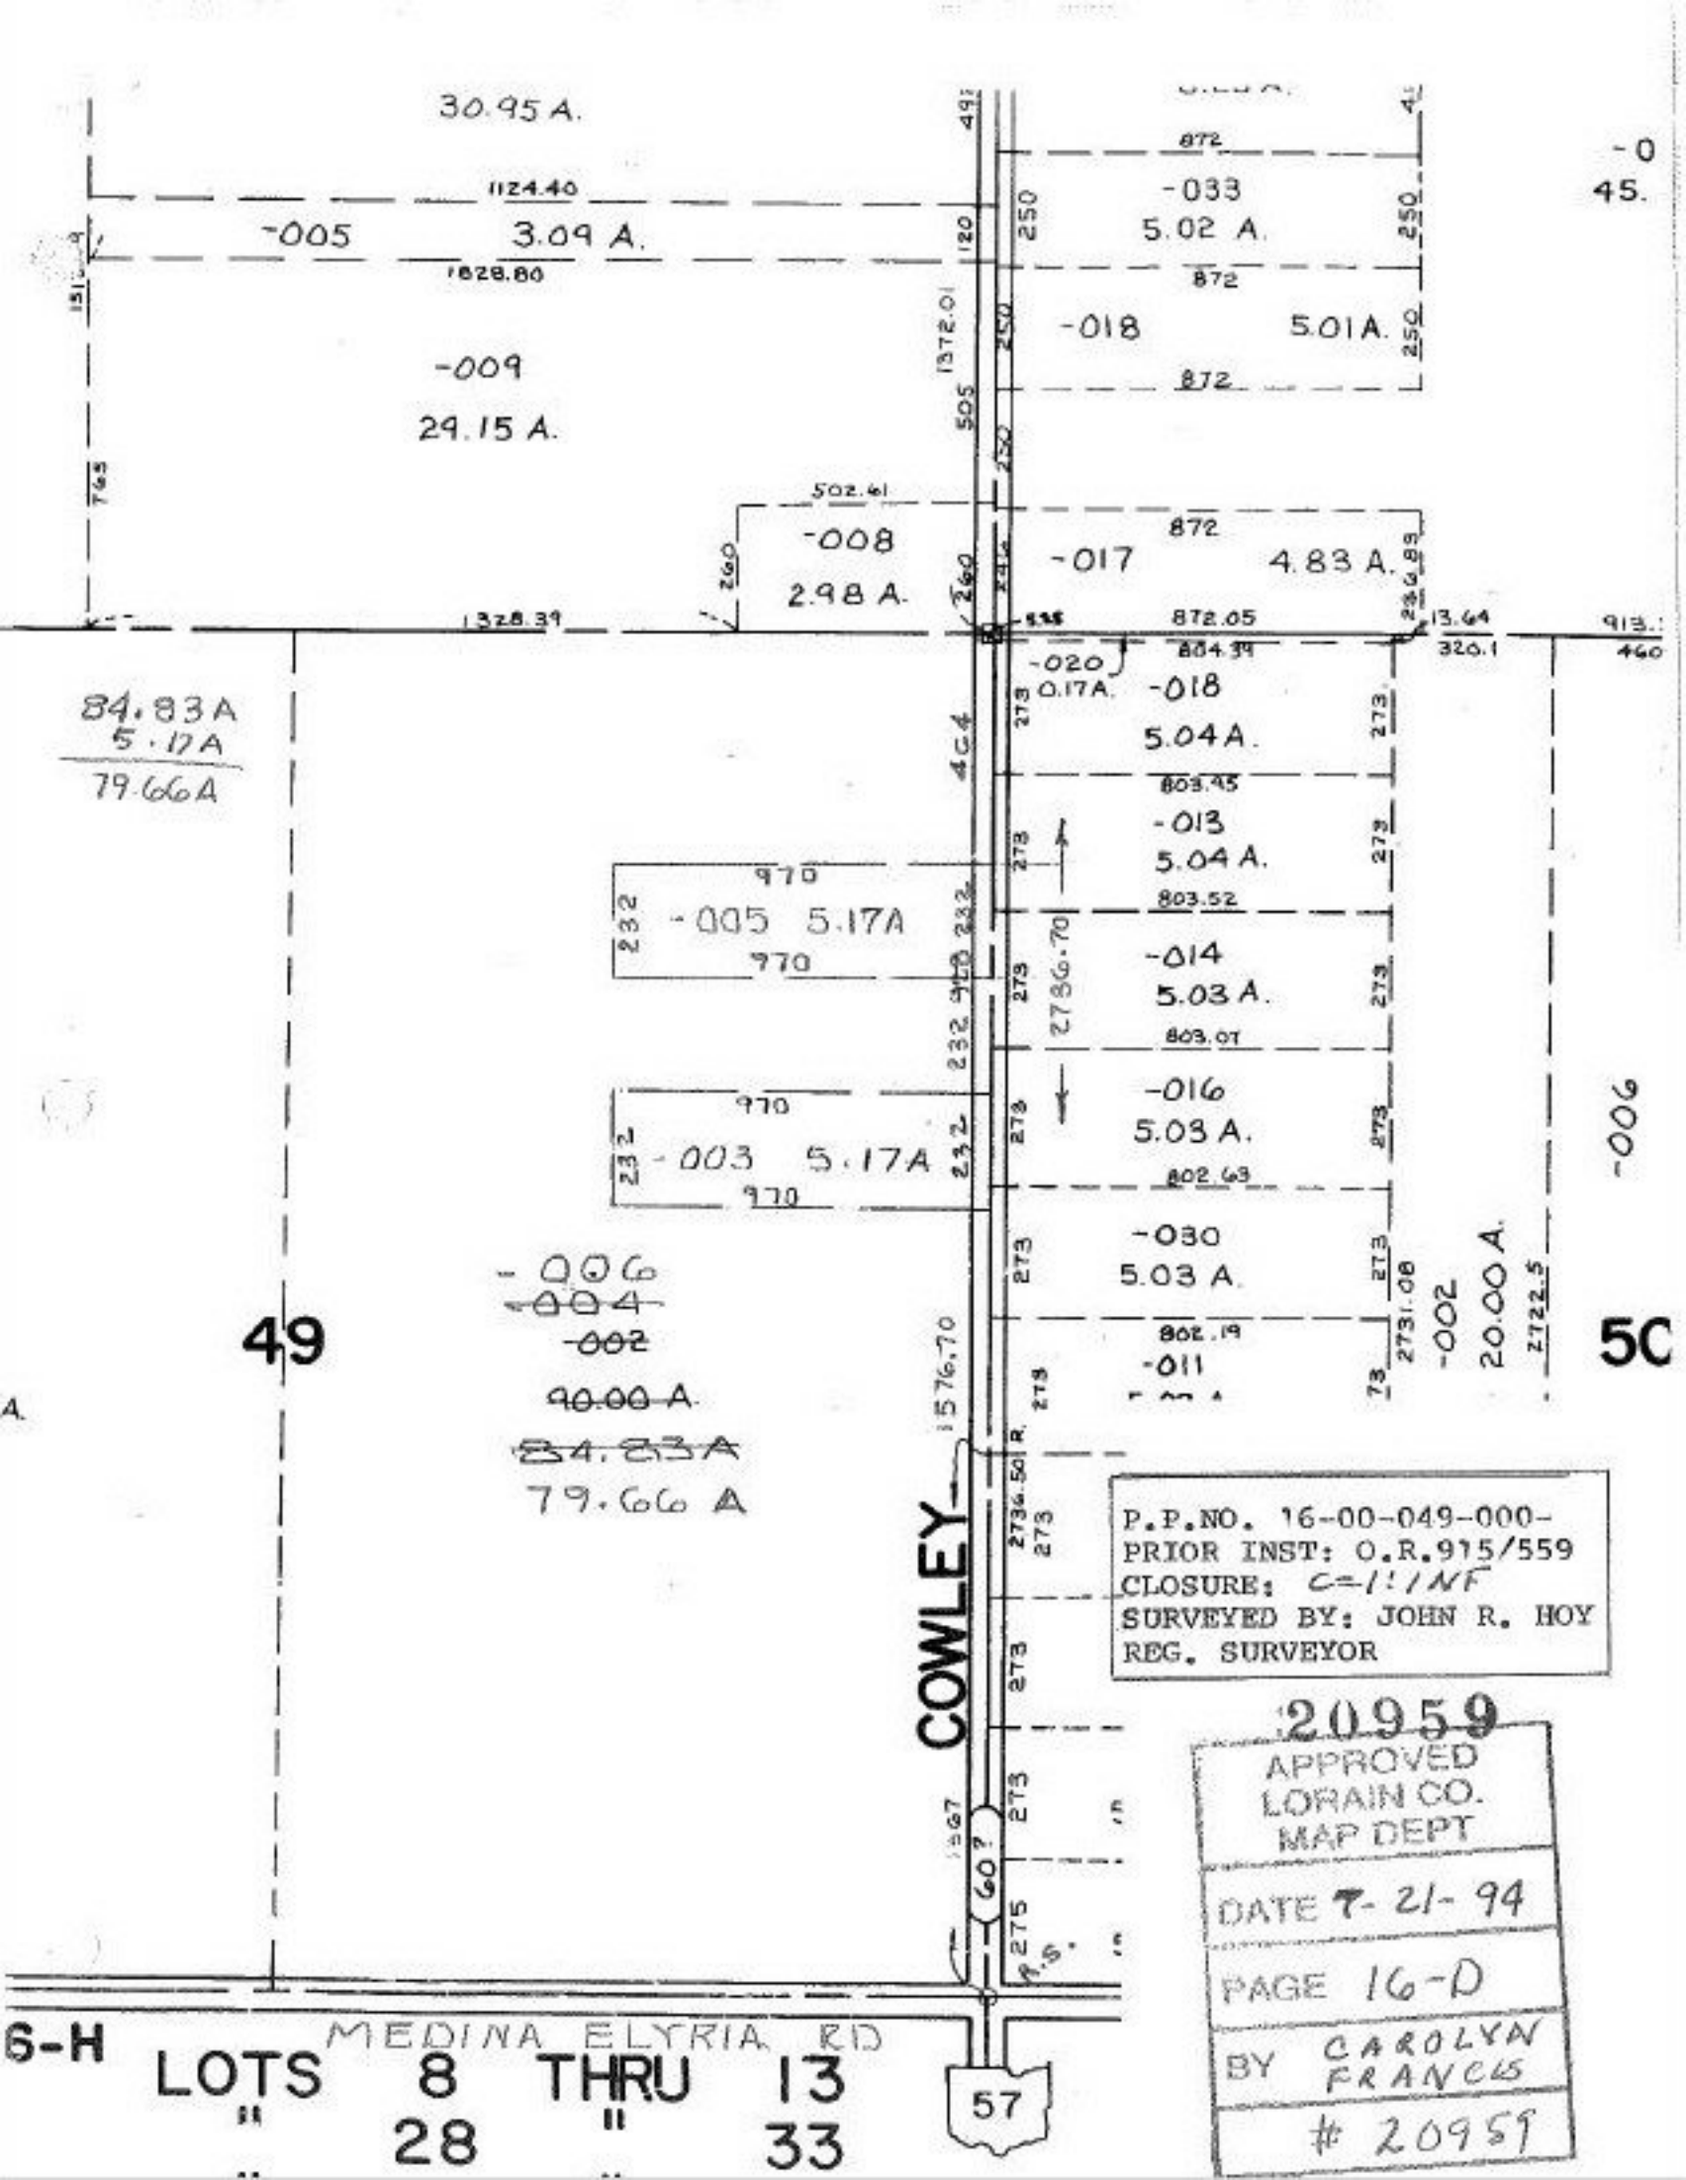
30.95 A.
1124.40
-005 3.09 A.
1828.80
-009
29.15 A.
-033
5.02 A.
-018 5.01 A.
-008
2.98 A.
-017 4.83 A.
1328.39
872.05
804.39
-020
0.17A.
-018
5.04 A.
803.45
-013
5.04 A.
803.52
-014
5.03 A.
803.07
-016
5.03 A.
802.63
-030
5.03 A.
802.19
-011
-005 5.17A
-003 5.17A
84.83A
5.17A
79.66A
-006
~~-004~~
~~-002~~
~~90.00 A.~~
~~84.83A~~
79.66 A
-002
20.00 A.
49
50
COWLEY
57
6-H
MEDINA ELYRIA RD
LOTS 8 THRU 13
" 28 " 33
P.P.NO. 16-00-049-000-
PRIOR INST: O.R.915/559
CLOSURE: C=1:1NF
SURVEYED BY: JOHN R. HOY
REG. SURVEYOR
20959
APPROVED
LORAIN CO.
MAP DEPT
DATE 7-21-94
PAGE 16-D
BY CAROLYN FRANCIS
20959