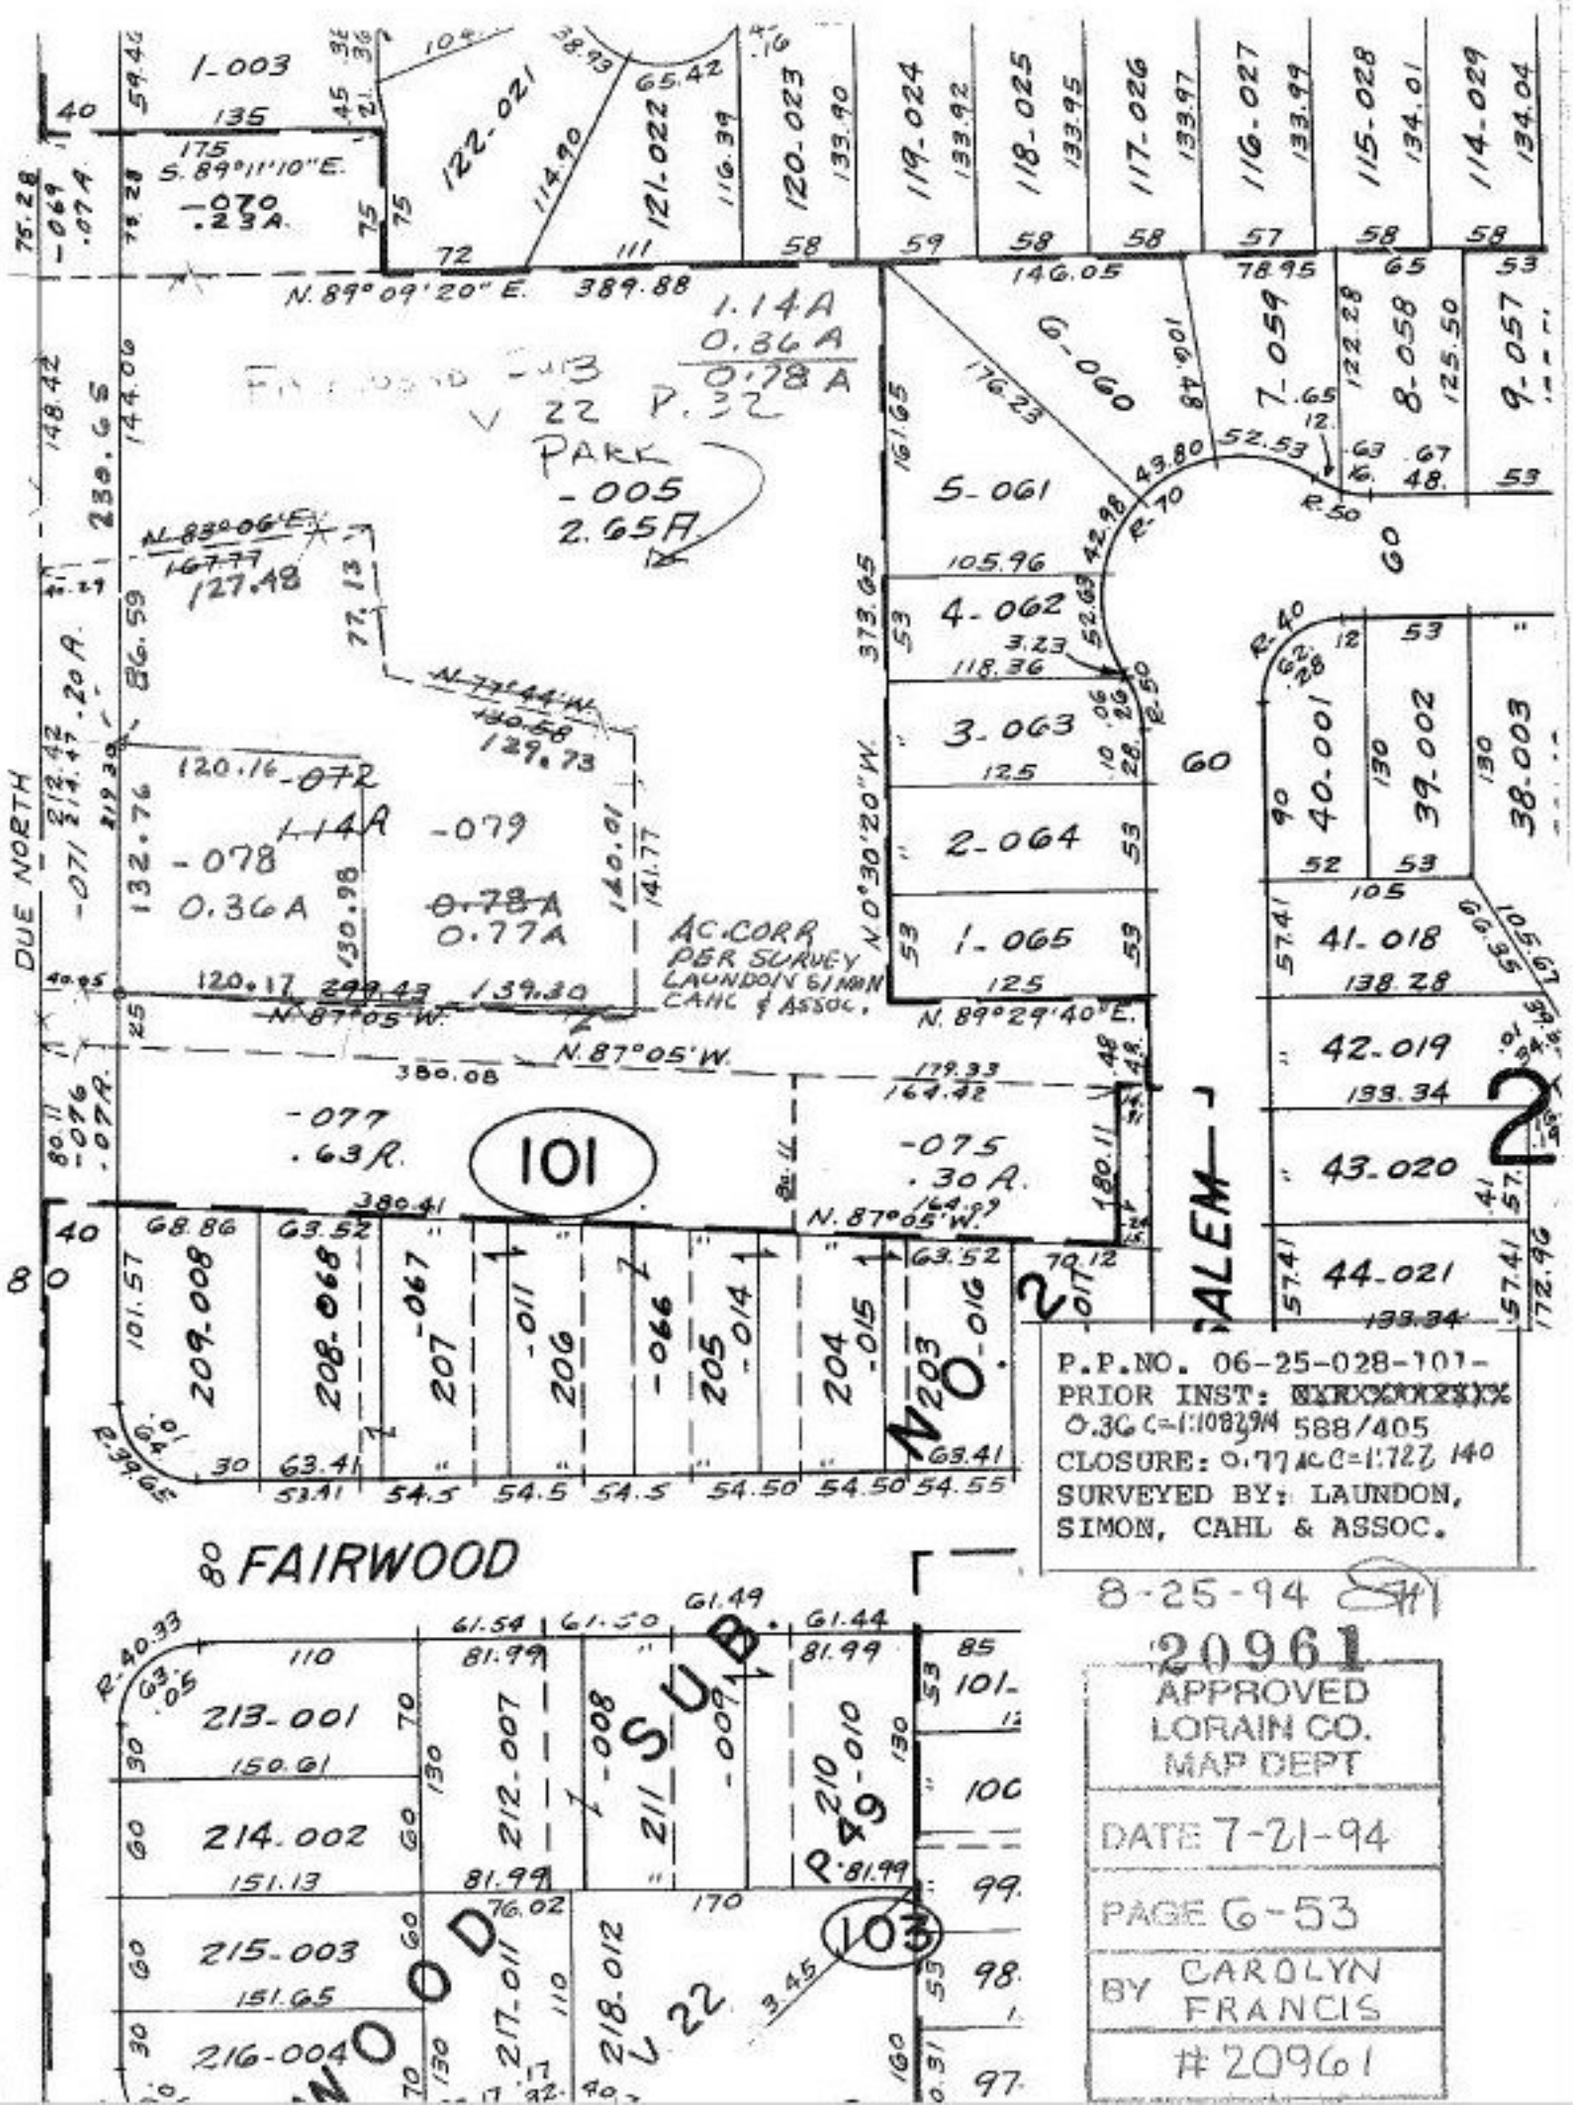
1.003
135
175
S.89°11'10"E.
-070
.23A.
122-021
121.022
120.023
119-024
118-025
117-026
116-027
115-028
114-029
N.89°09'20"E. 389.88
1.14A
0.36A
0.78A
V 22 P. 32
PARK
-005
2.65A
N.88°06'E.
167.77
127.48
N.77°44'W.
130.58
129.73
120.16-072
1.14A
-079
-078
0.36A
0.78A
0.77A
AC.CORR PER SURVEY LAUNDON & MINN CAHL & ASSOC.
N.87°05'W.
380.08
179.33
164.42
-077
.63R.
101
-075
.30A.
N.87°05'W.
380.41
N.89°29'40"E.
N.0°30'20"W.
6.060
7.059
8-058
9-057
5-061
4-062
3.063
2-064
1-065
40-001
39-002
38-003
41-018
42-019
43-020
44-021
209-008
208-068
207
206
205
204
203
202
DUE NORTH
P.P.NO. 06-25-028-101-
PRIOR INST: [illegible]
0.36 C-1:108294 588/405
CLOSURE: 0.77 AC C-1:727 140
SURVEYED BY: LAUNDON, SIMON, CAHL & ASSOC.
80 FAIRWOOD
213-001
214.002
215-003
216-004
212-007
211-008
210-009
218-012
217-011
101
103
V 22
8-25-94
20961
APPROVED
LORAIN CO.
MAP DEPT
DATE 7-21-94
PAGE 6-53
BY CAROLYN FRANCIS
#20961