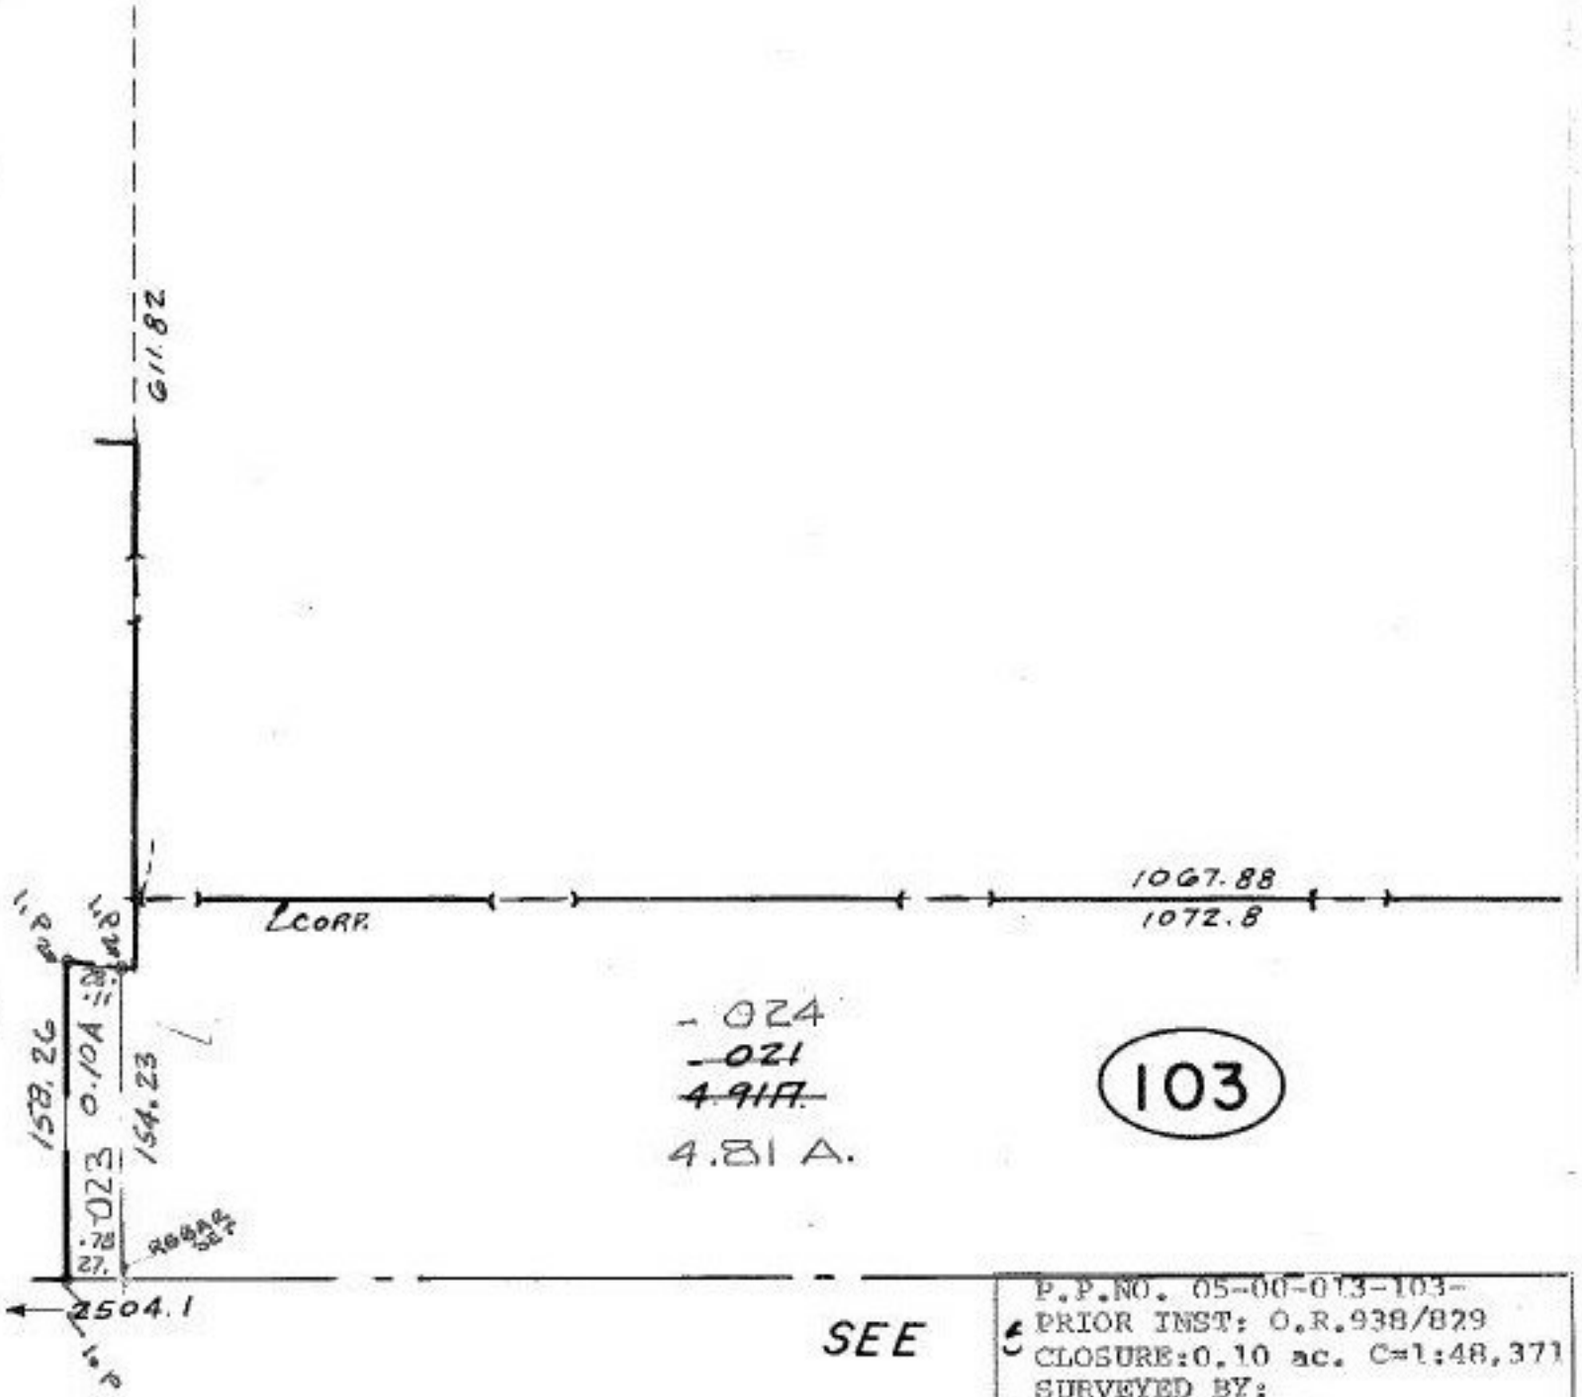

P.P.NO. 05-00-013-103-
PRIOR INST: O.R.938/829
CLOSURE:0.10 ac. C=1:48,371
SURVEYED BY:
EARL H. HUNTER
REG. SURVEYOR

9-7-94

20964

APPROVED
LORAIN CO.
MAP DEPT

DATE 7-22-94

PAGE 5-00-013B

BY CAROLYN FRANCIS

20964