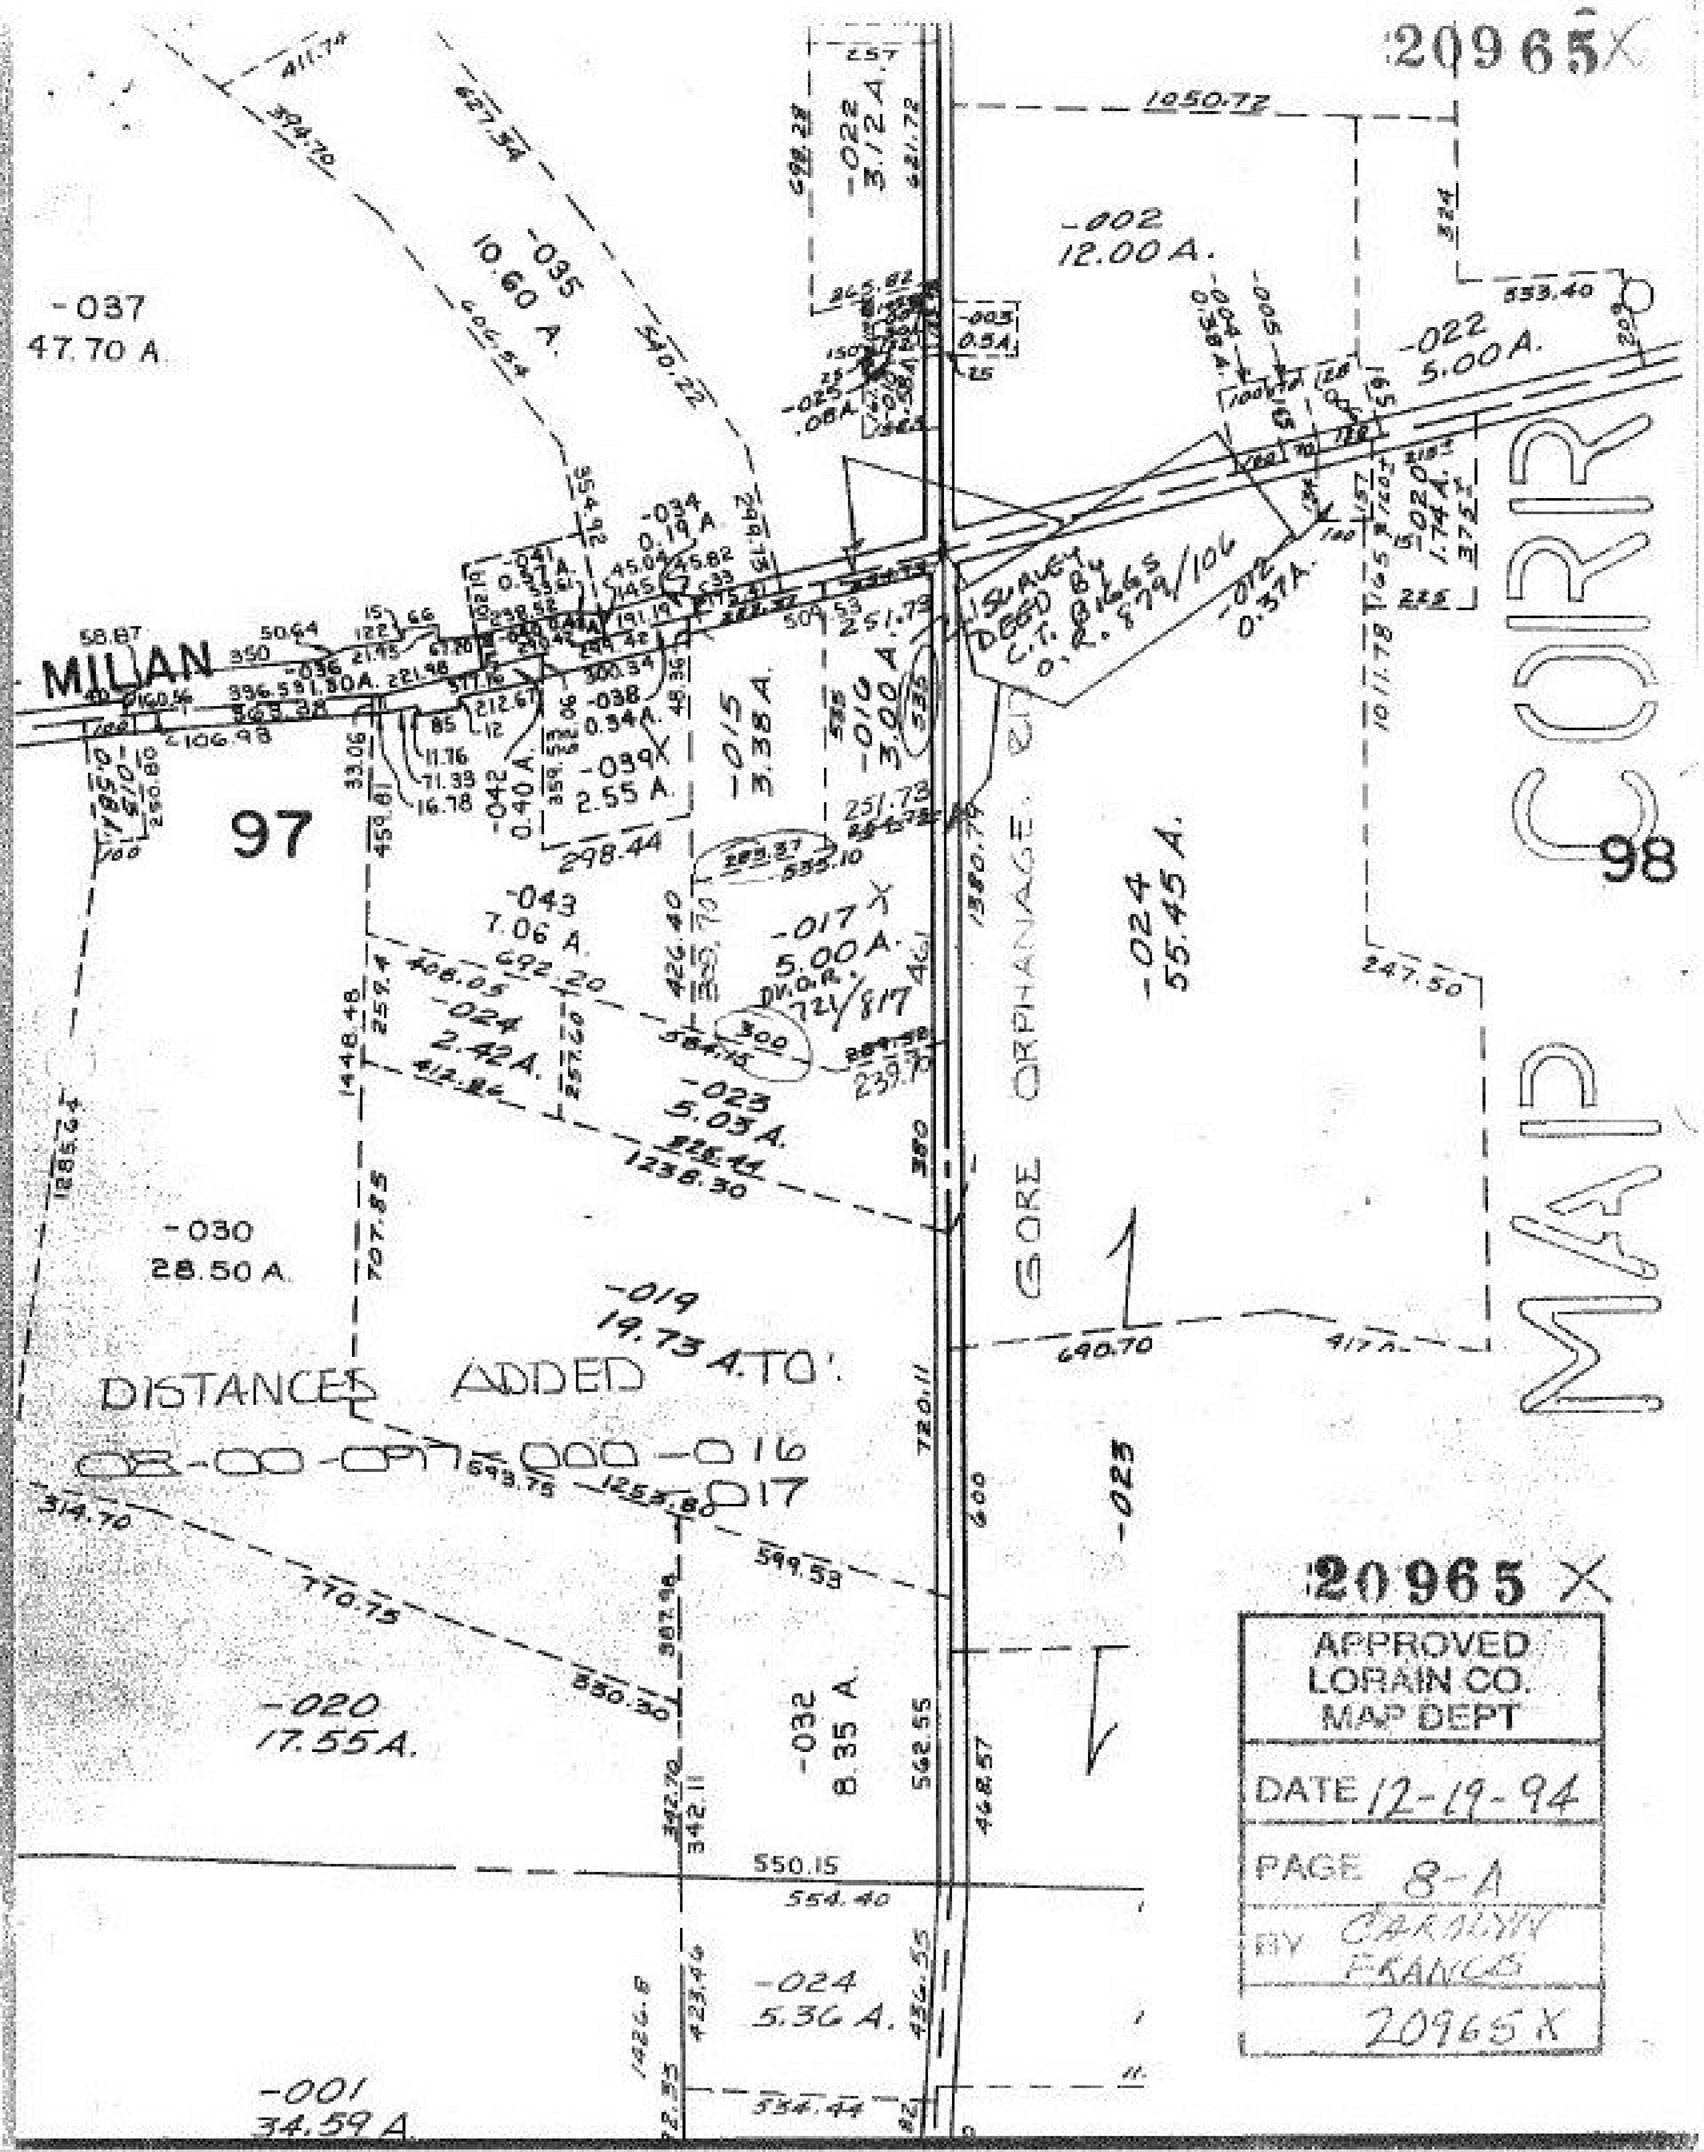
20965X
MILIAN
97
98
MAP CORR
-037
47.70 A.
-035
10.60 A.
-022
3.12 A.
-002
12.00 A.
-022
5.00 A.
-003
0.5 A.
-025
.08 A.
-034
0.19 A.
-041
0.37 A.
-036
1.30 A.
-038
0.34 A.
-039
2.55 A.
-042
0.40 A.
-015
3.38 A.
-016
3.00 A.
-012
0.37 A.
-020
1.74 A.
-043
7.06 A.
-017
5.00 A.
DV. O.R. 721/817
-024
2.42 A.
-023
5.03 A.
-024
55.45 A.
-030
28.50 A.
-019
19.73 A.TO'.
DISTANCES ADDED
08-00-097-000-016
017
-020
17.55 A.
-032
8.35 A.
-024
5.36 A.
-001
34.59 A.
-023
GORE ORPHANAGE RD.
SURVEY DEED BY C.T. BIGGS O.R. 879/106
1050.72
1236.30
550.15
20965X
APPROVED LORAIN CO. MAP DEPT
DATE 12-19-94
PAGE 8-A
BY CAROLYN FRANCS
20965X