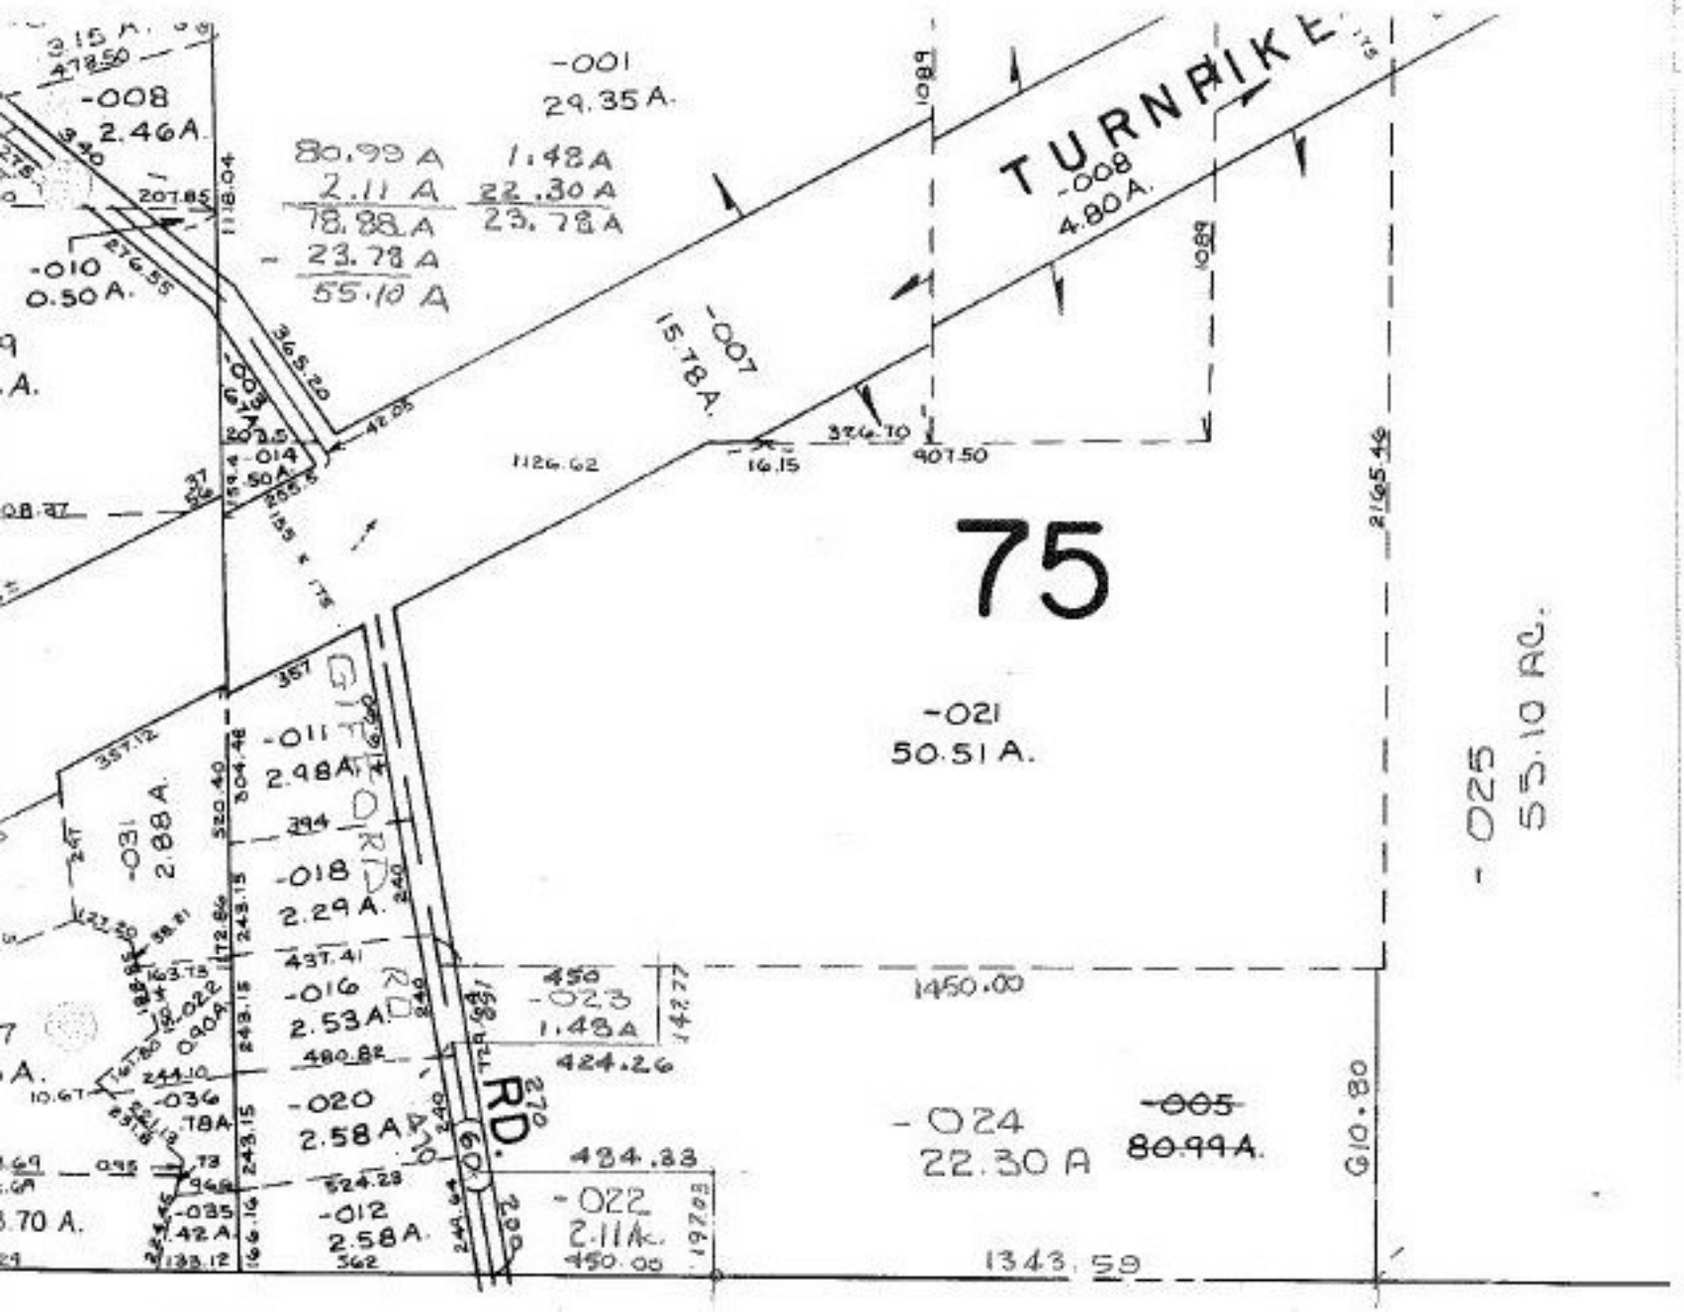

SEE 8-C

P.P.NO. 01-00-075-000-
PRIOR INST: DV.1298/271
CLOSURE: 2.11 ac. C=1:328,882
1.48 ac. C=1:181,601
22.30 ac. C=1:746,296
SURVEYED BY: N. R. HURA
REG. SURVEYOR

9-14-94

20967

APPROVED
LORAIN CO.
MAP DEPT

DATE 7-27-94

PAGE 1 - K

BY CAROLYN FRANCIS

20967

BROWNHELM

SCALE: 1" = 400'