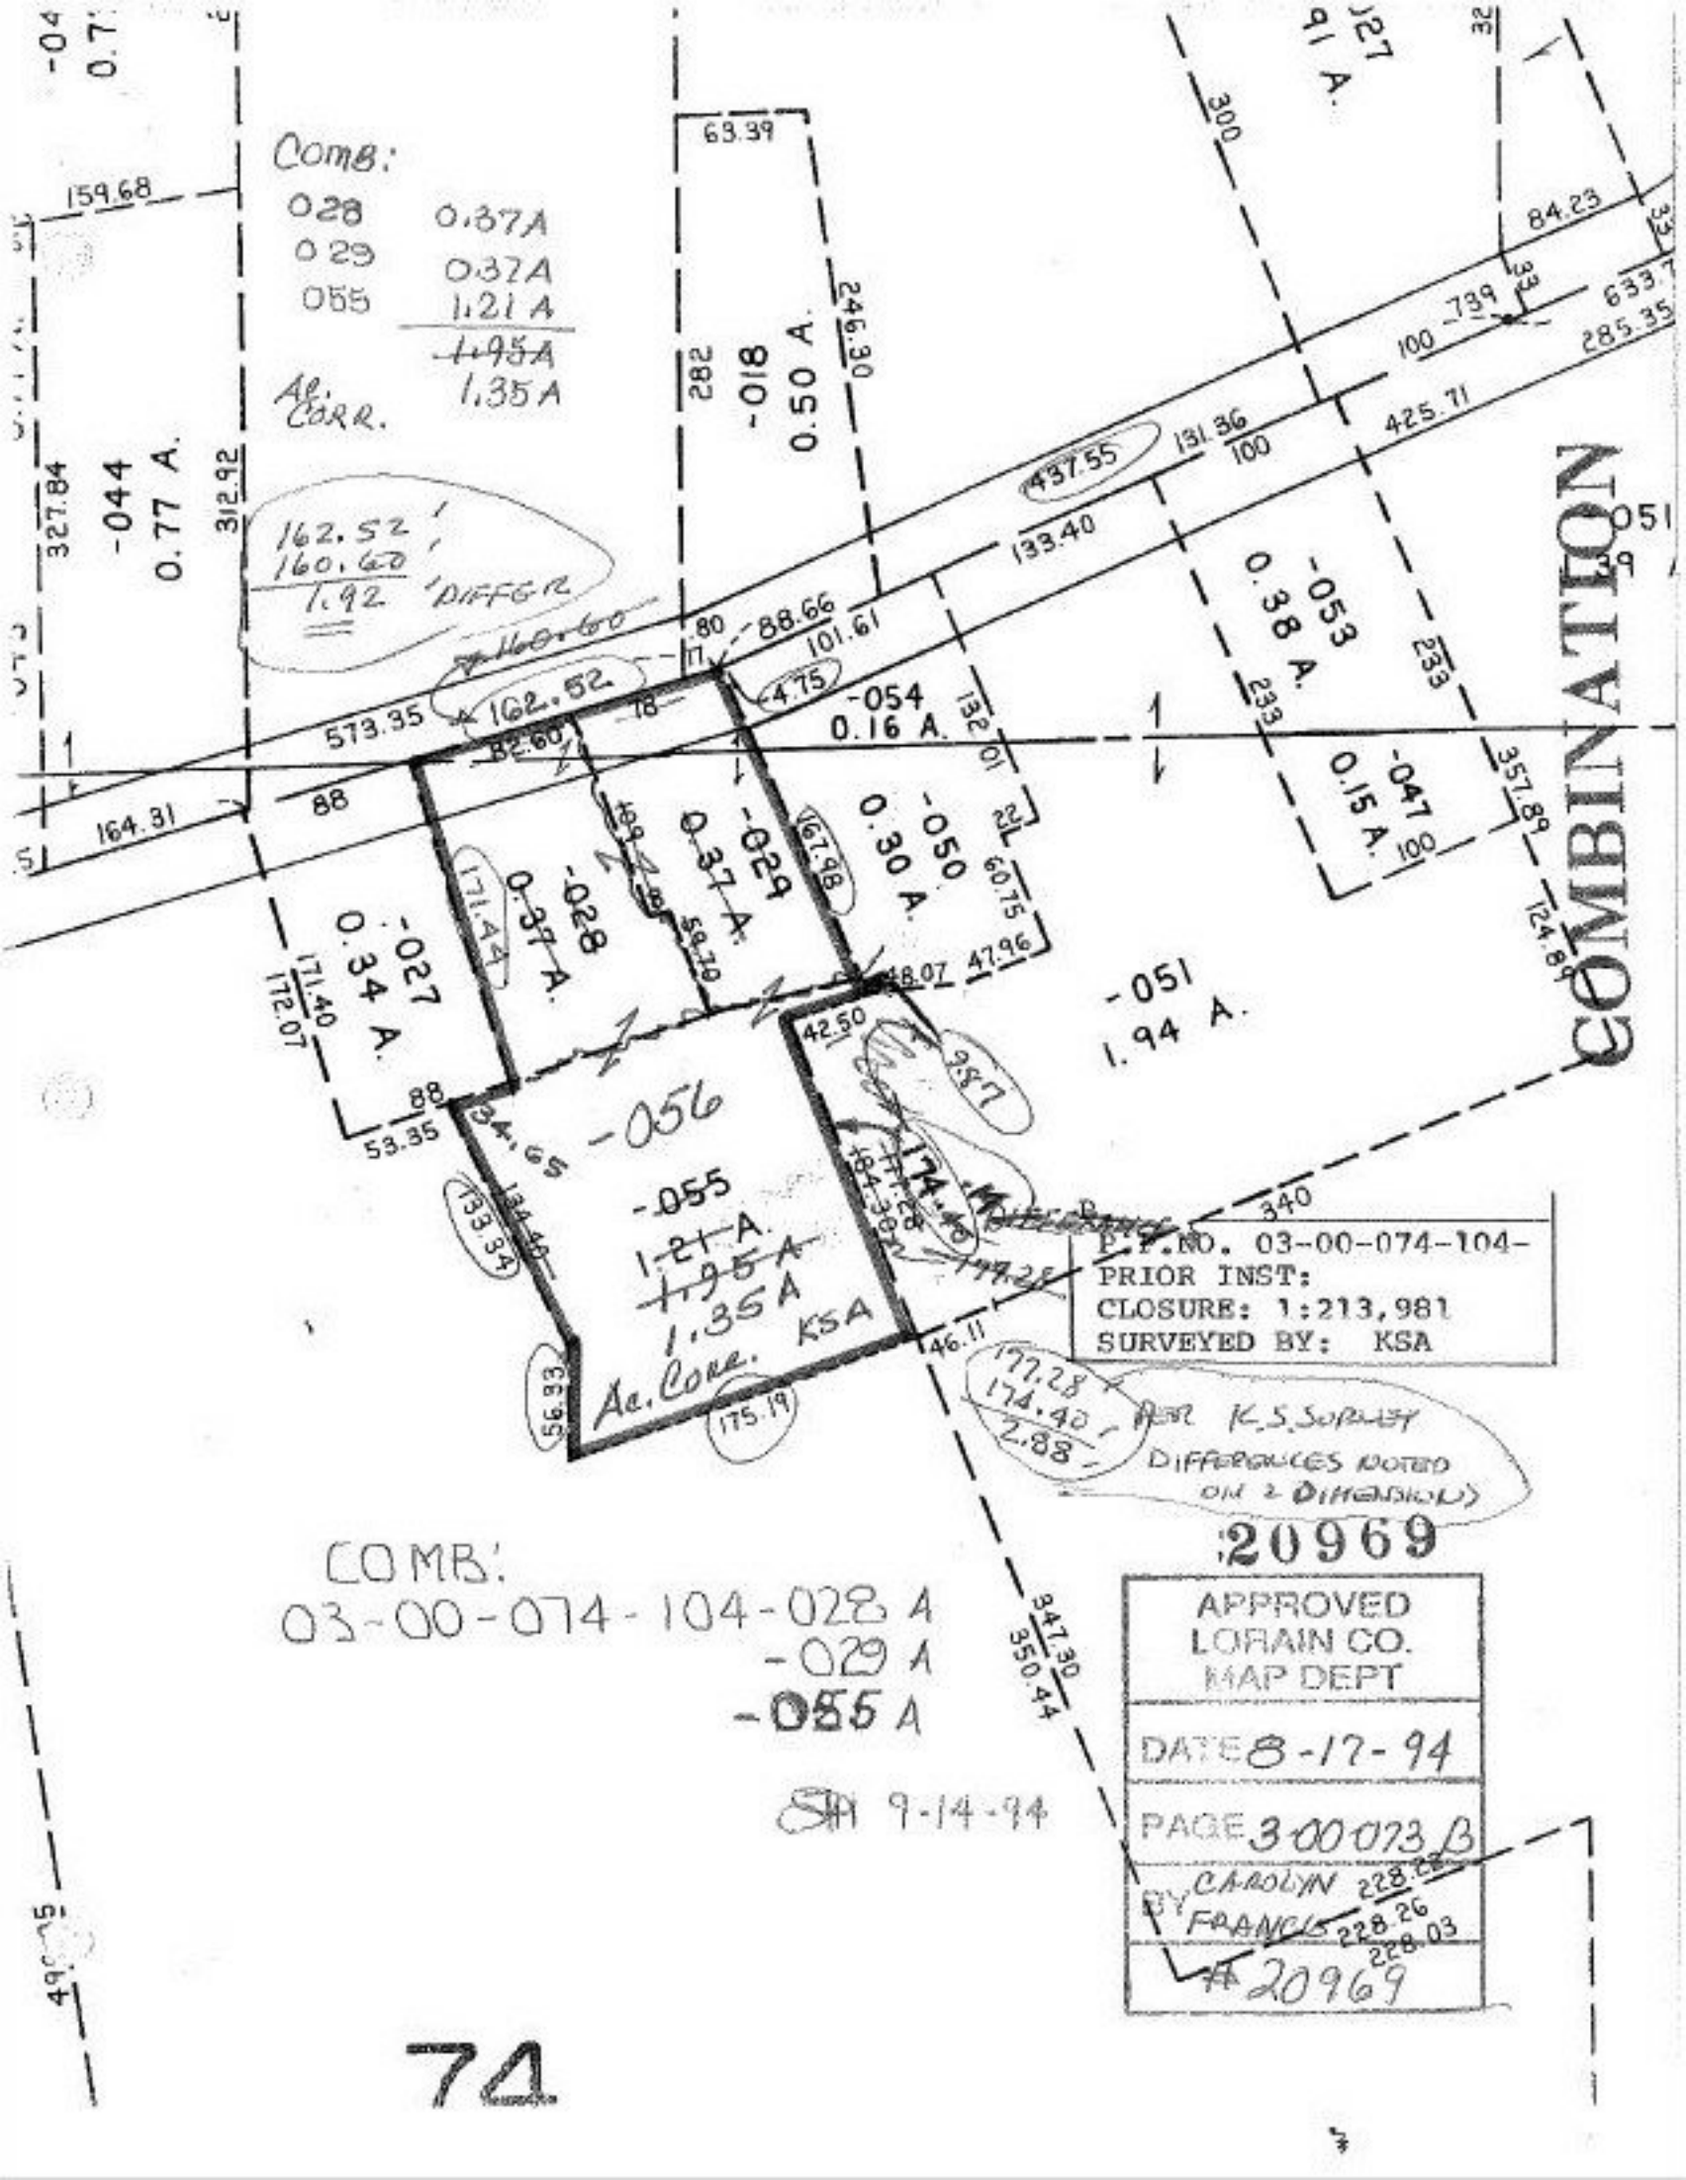
COMBINATION
Comb:
028 0.37A
029 0.32A
055 1.21A
1.95A
1.35A
Ac. Corr.
-044
0.77 A.
-018
0.50 A.
-053
0.38 A.
-054
0.16 A.
-047
0.15 A.
-029
0.37 A.
-028
0.37 A.
-027
0.34 A.
-050
0.30 A.
-051
1.94 A.
-056
-055
1.21A
1.95A
1.35A
Ac. Corr. KSA
162.52
160.60
1.92 DIFFER
P.I.NO. 03-00-074-104-
PRIOR INST:
CLOSURE: 1:213,981
SURVEYED BY: KSA
177.28
174.40
2.88
PER K.S. SURVEY
DIFFERENCES NOTED
ON 2 DIMENSION
20969
COMB:
03-00-074-104-028 A
-029 A
-055 A
9-14-94
APPROVED
LORAIN CO.
MAP DEPT
DATE 8-17-94
PAGE 300073 B
BY CAROLYN
FRANCIS
20969
74