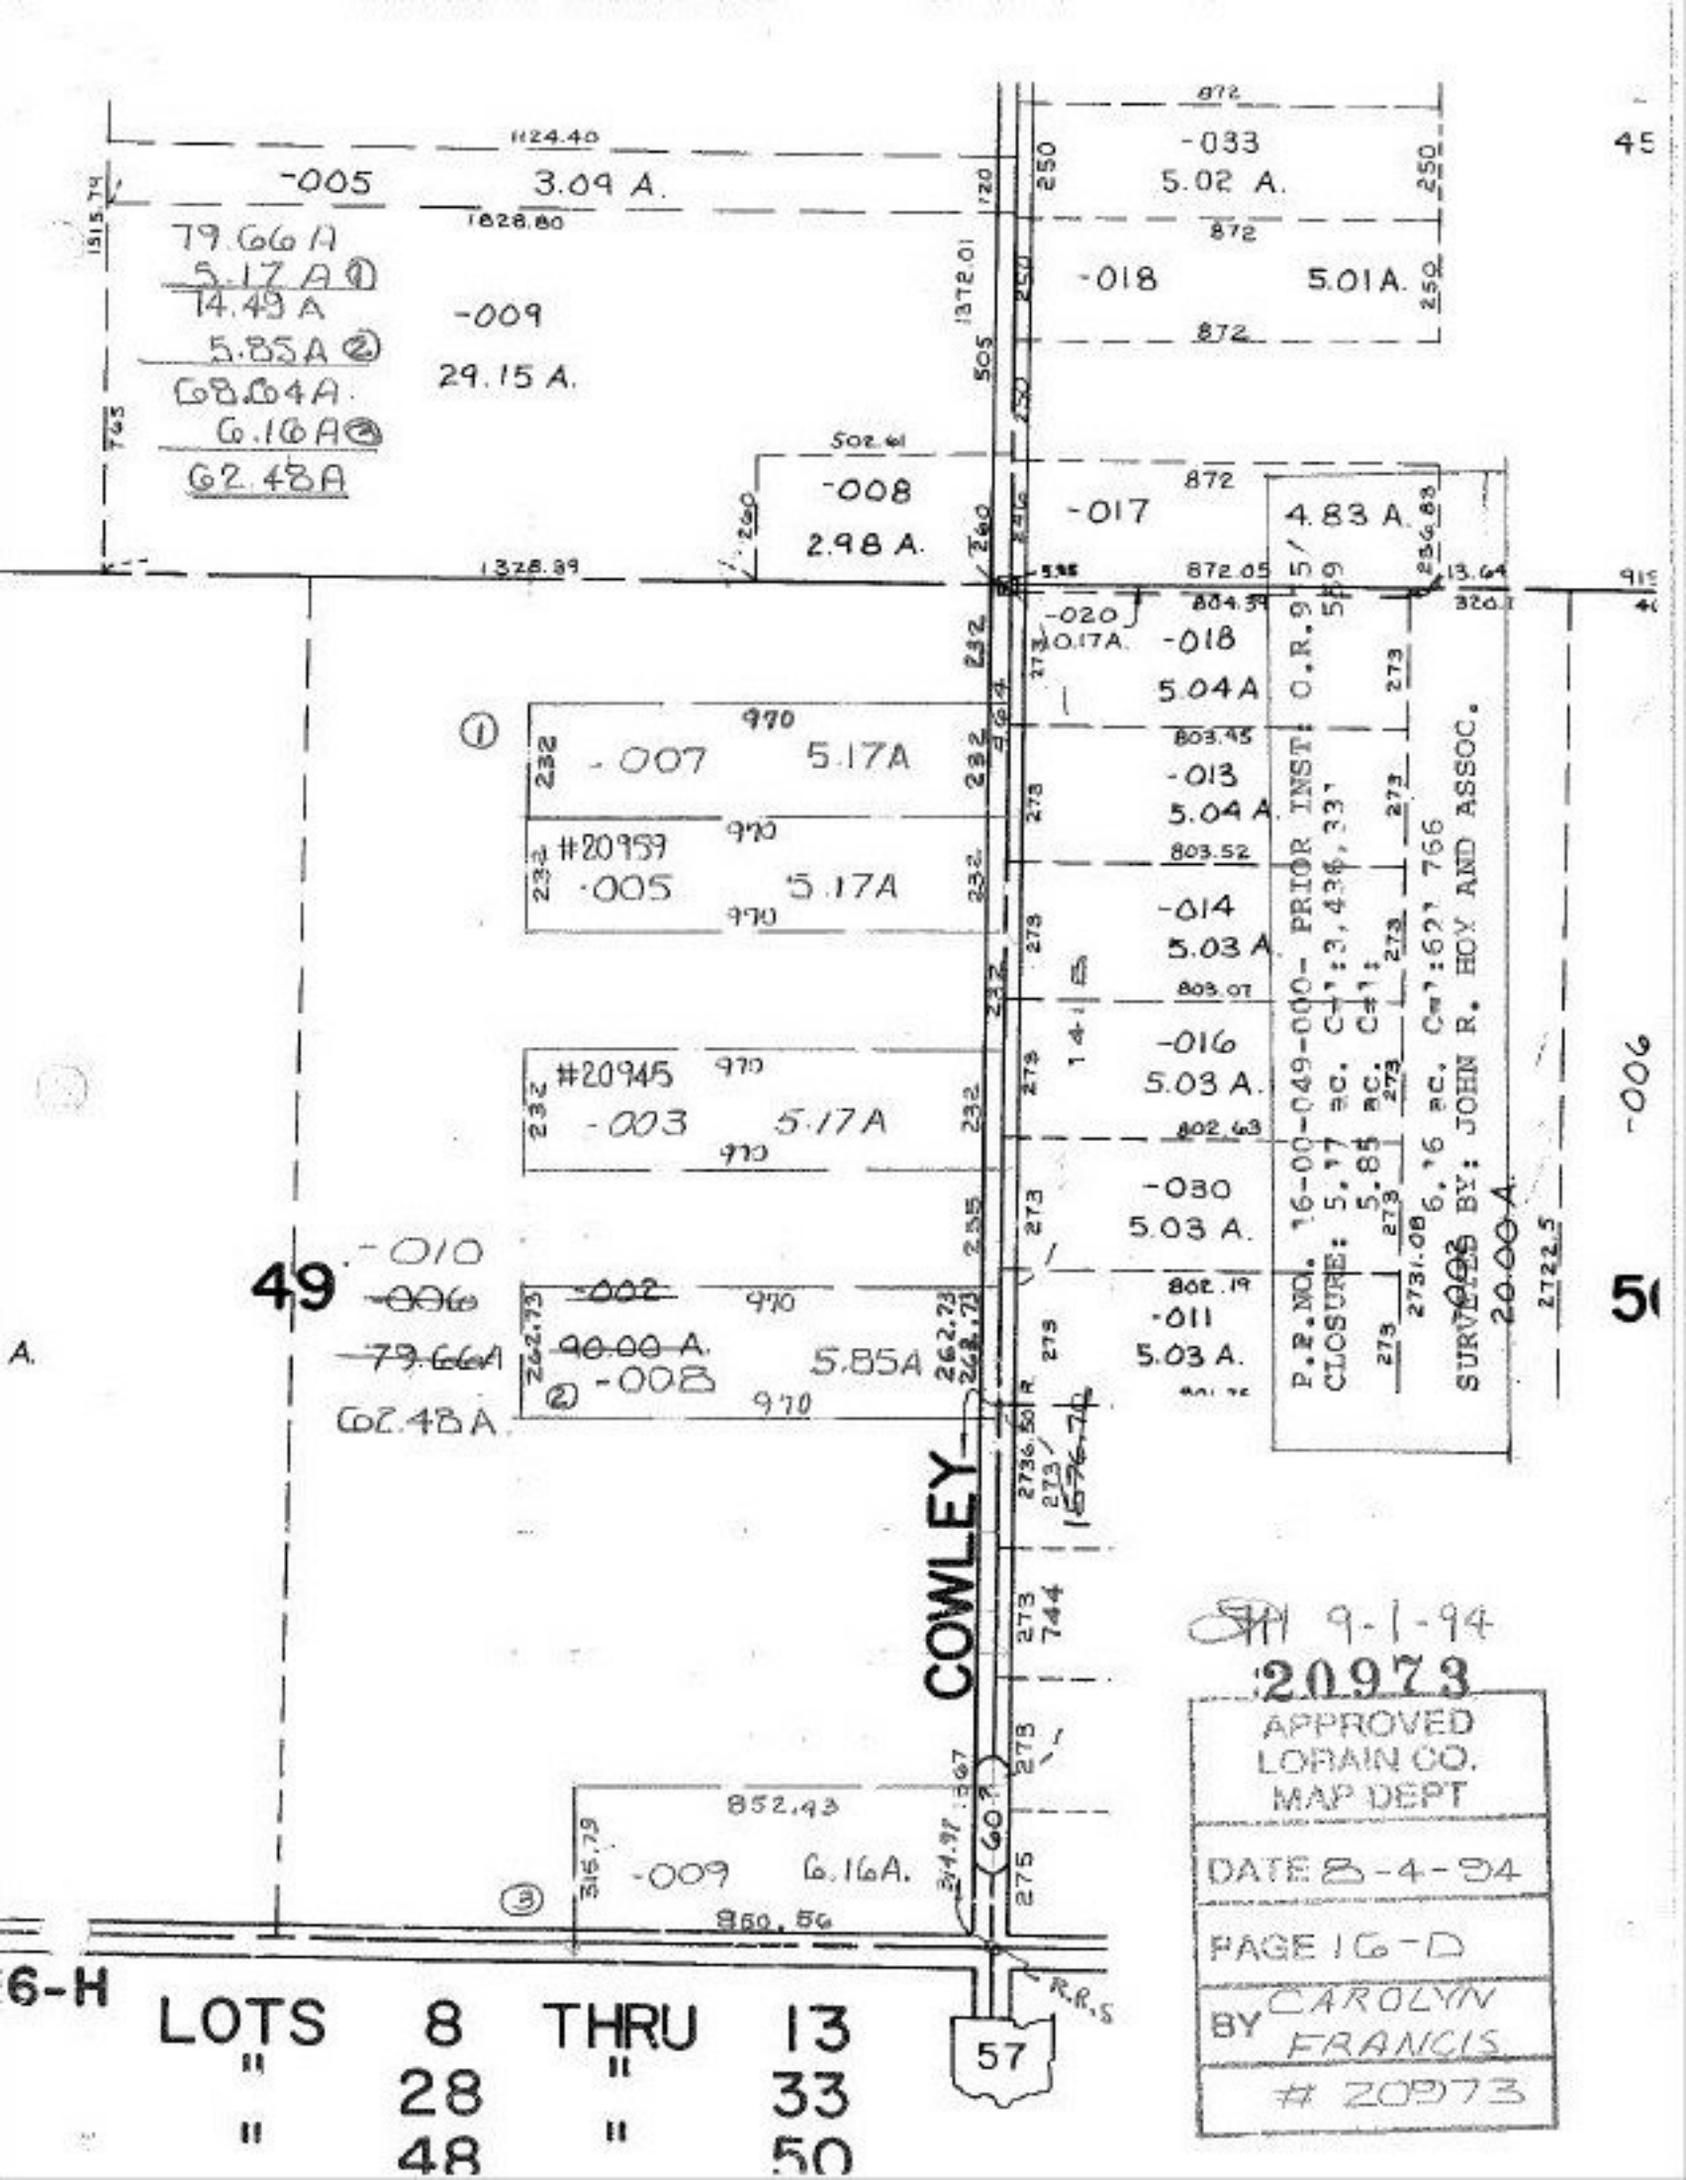
-005
3.09 A.
1124.40
1828.80
79.66A
5.17A ①
14.49A
5.85A ②
68.64A.
6.16A ③
62.48A
-009
29.15 A.
-033
5.02 A.
-018
5.01A.
-008
2.98 A.
-017
4.83 A.
-020
0.17A.
-018
5.04A
-013
5.04 A.
-014
5.03 A.
-016
5.03 A.
-030
5.03 A.
-011
5.03 A.
-007
5.17A
#20959
-005
5.17A
#20945
-003
5.17A
-010
-006
-002
90.00 A.
-008
5.85A
-009
6.16A.
49
COWLEY
P.P.NO. 16-00-049-000- PRIOR INST: O.R. 5/
CLOSURE: 5.17 ac. C#1: 3,436.33'
5.85 ac.
6.16 ac. C#1: 62' 766
SURVEYED BY: JOHN R. HOY AND ASSOC.
20.00 A.
-006
LOTS 8 THRU 13
" 28 " 33
" 48 " 50
57
R.R.
9-1-94
20973
APPROVED
LORAIN CO.
MAP DEPT
DATE 8-4-94
PAGE 16-D
BY CAROLYN FRANCIS
20973