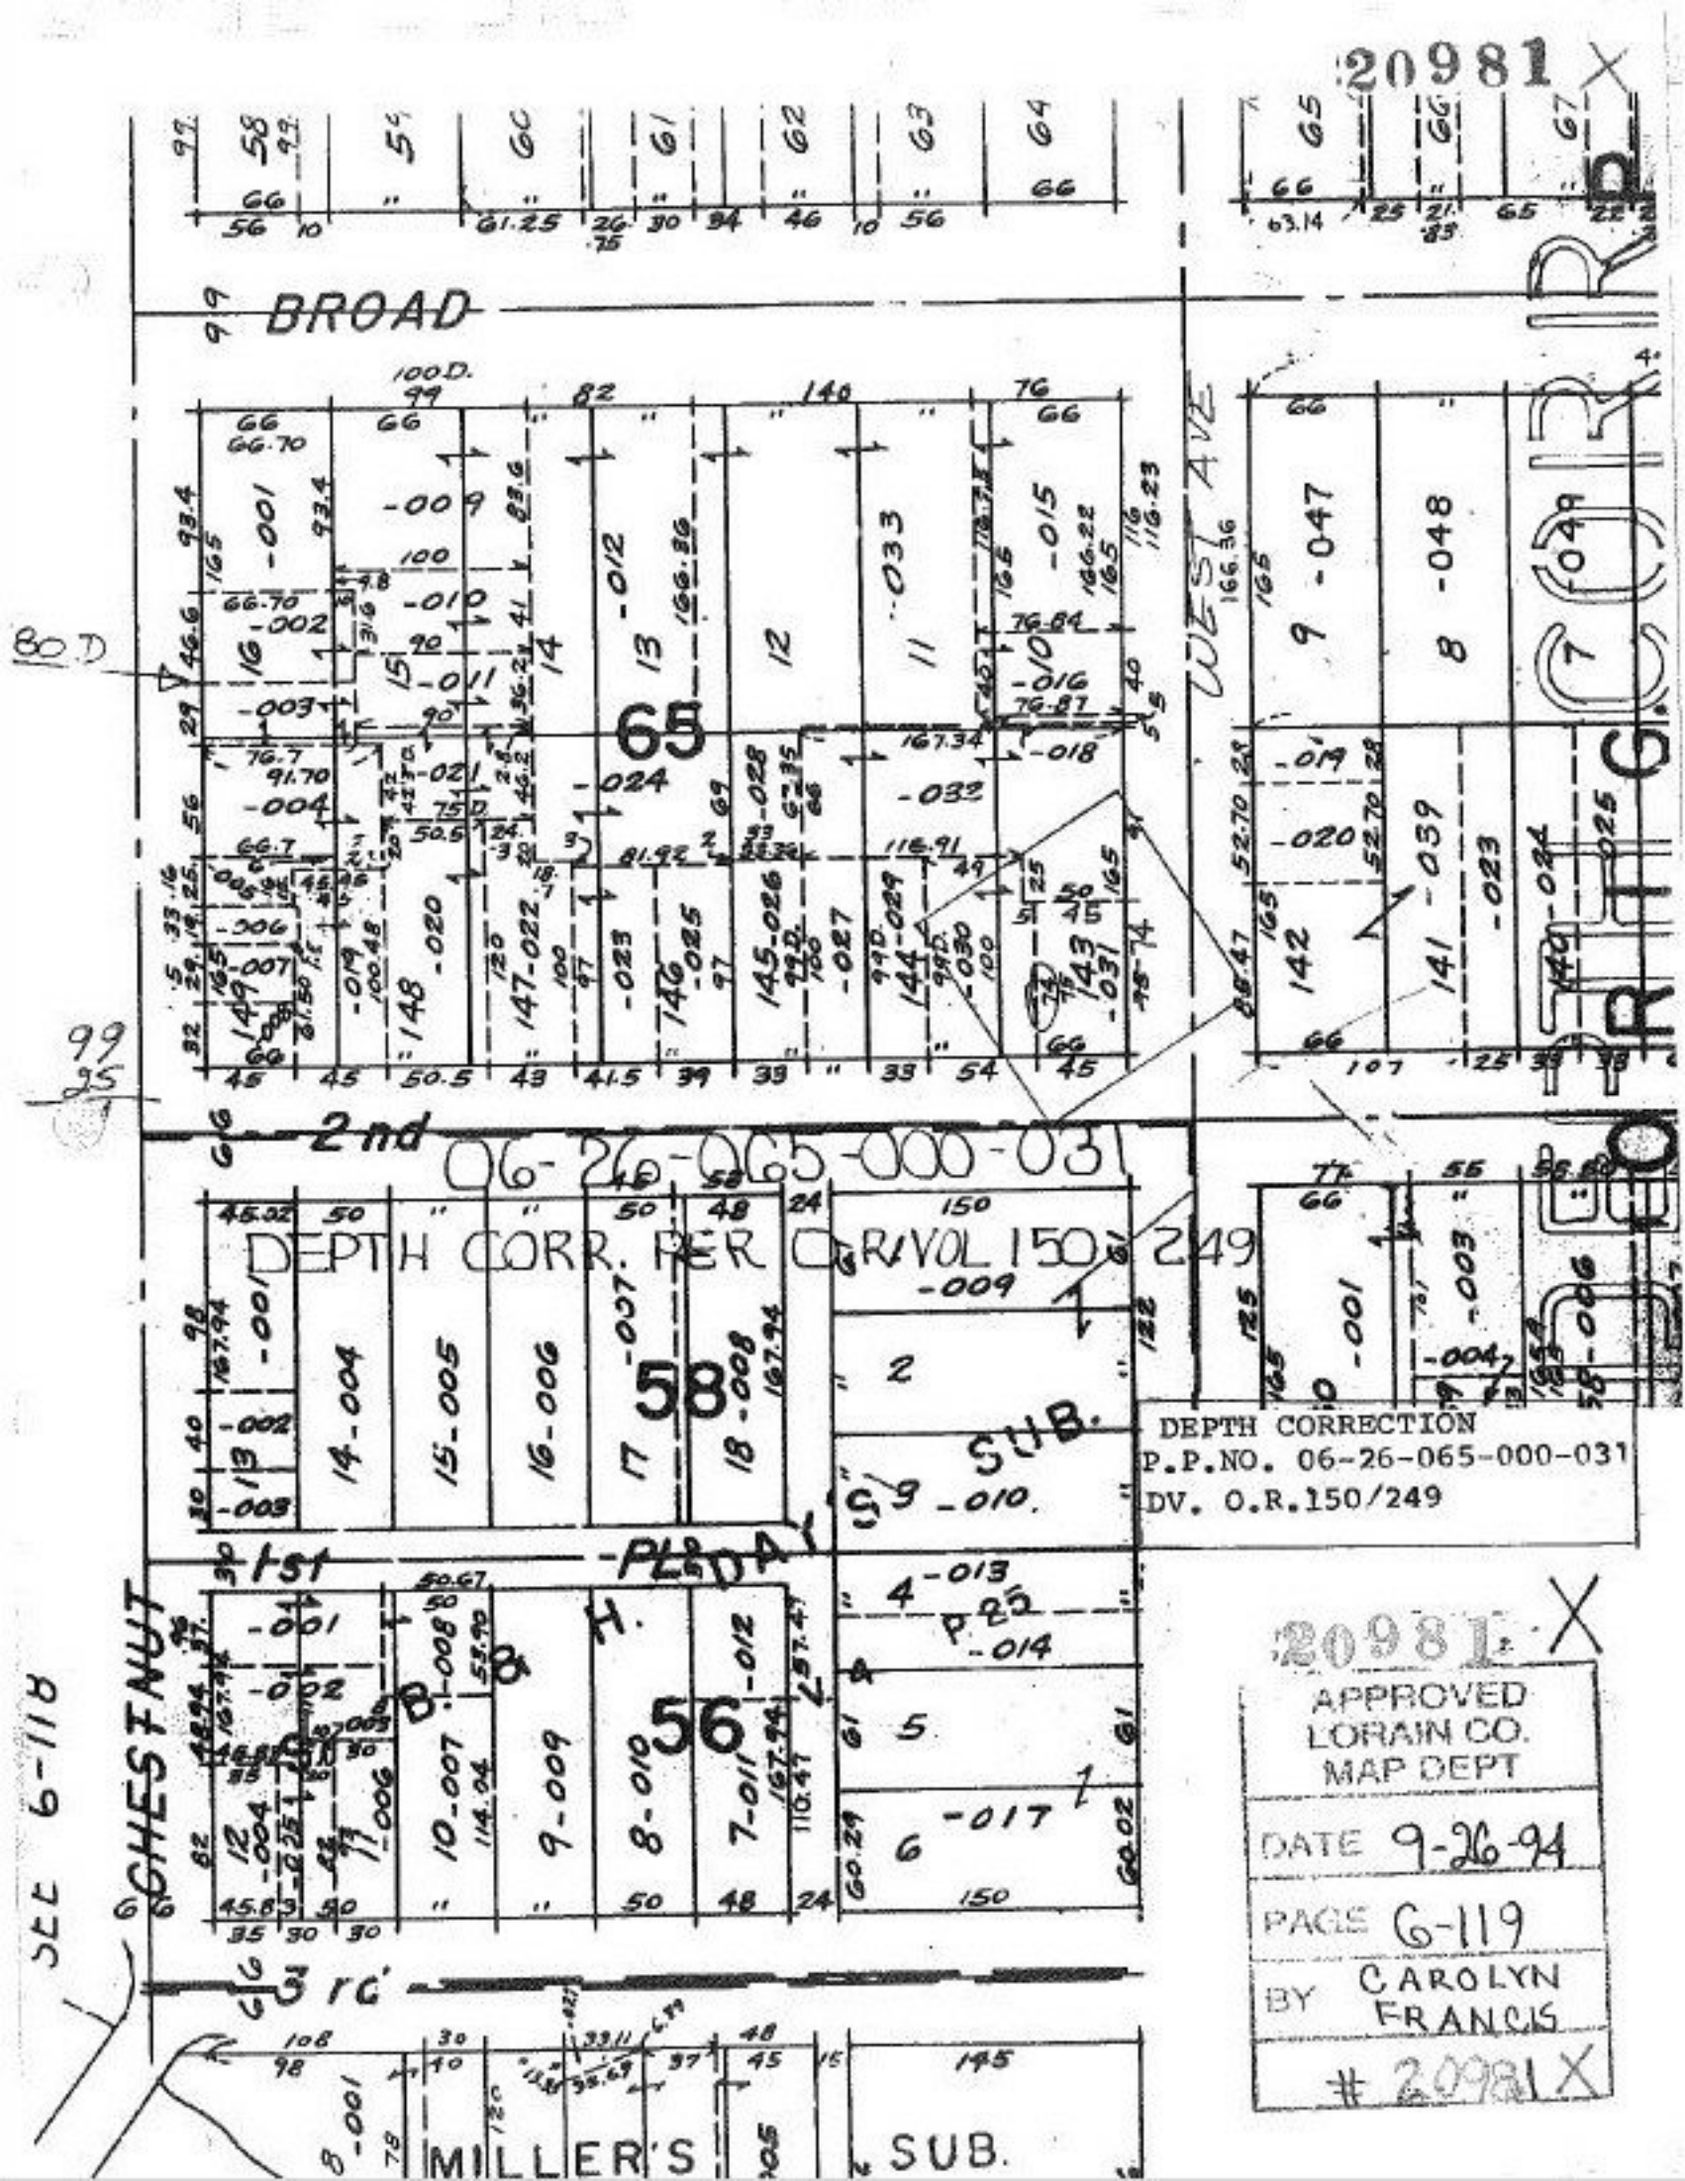
20981
BROAD
WEST AVE
2nd
06-26-065-000-031
DEPTH CORR. PER O.R. VOL 150/249
1st
CHESTNUT
3rd
MILLER'S SUB.
SEE 6-118
DEPTH CORRECTION
P.P.NO. 06-26-065-000-031
DV. O.R.150/249
20981
APPROVED
LORAIN CO.
MAP DEPT
DATE 9-26-94
PAGE 6-119
BY CAROLYN FRANCIS
20981