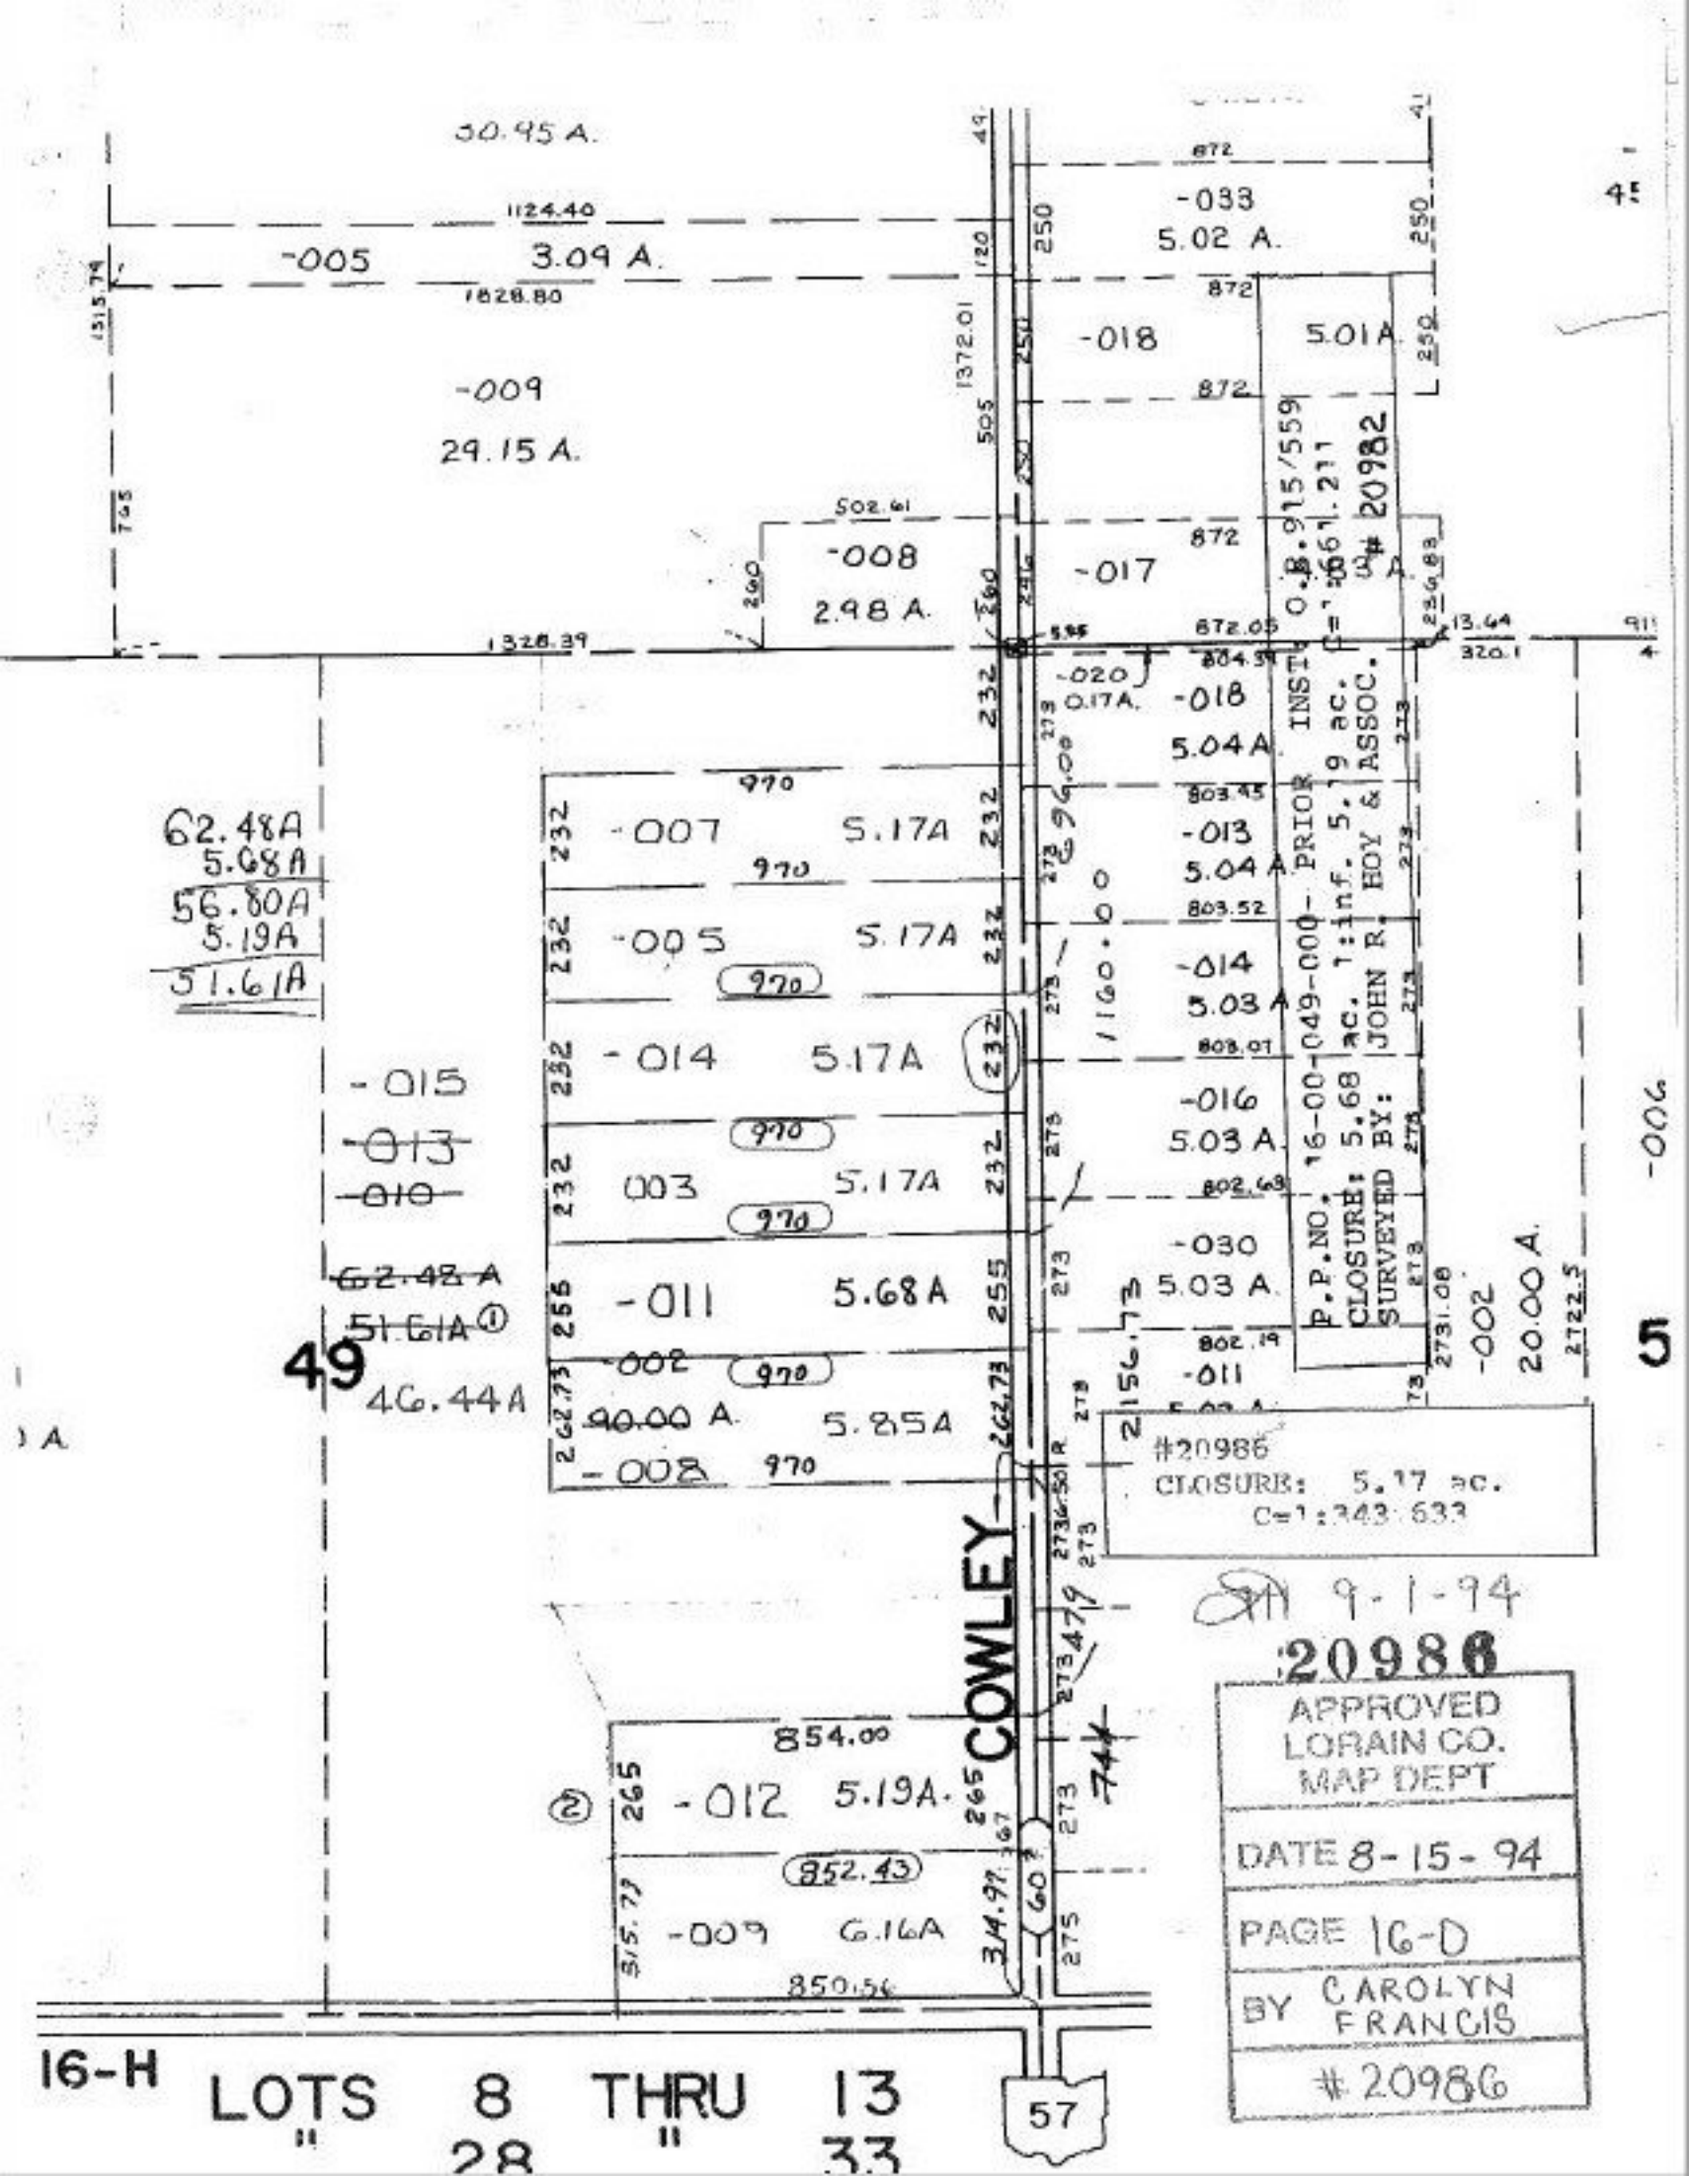

30.95 A.
1124.40
-005
3.09 A.
1828.80
-009
29.15 A.
-033
5.02 A.
-018
5.01 A.
-008
2.98 A.
-017
1328.39
-020
0.17A.
-018
5.04 A.
-007
5.17A
-005
5.17A
-014
5.17A
-013
5.04 A.
-014
5.03 A.
-016
5.03 A.
-030
5.03 A.
-011
5.68 A
-002
90.00 A.
5.85A
-008
-015
-013
-010
62.48A
5.68A
56.80A
5.19A
51.61A
62.48 A
51.61A
46.44A
49
5
-002
20.00 A.
-006
P.P.NO. 16-00-049-000- PRIOR INST. O.R. 915/559
CLOSURE: 5.68 ac. 1:inf. 5.19 ac. C=1:661.211
SURVEYED BY: JOHN R. HOY & ASSOC. # 20982
#20986
CLOSURE: 5.17 ac.
C=1:343.633
COWLEY
854.00
-012
5.19A.
852.43
-009
6.16A
850.56
16-H
LOTS 8 THRU 13
" 28 " 33
57
9-1-94
20986
APPROVED
LORAIN CO.
MAP DEPT
DATE 8-15-94
PAGE 16-D
BY CAROLYN FRANCIS
#20986