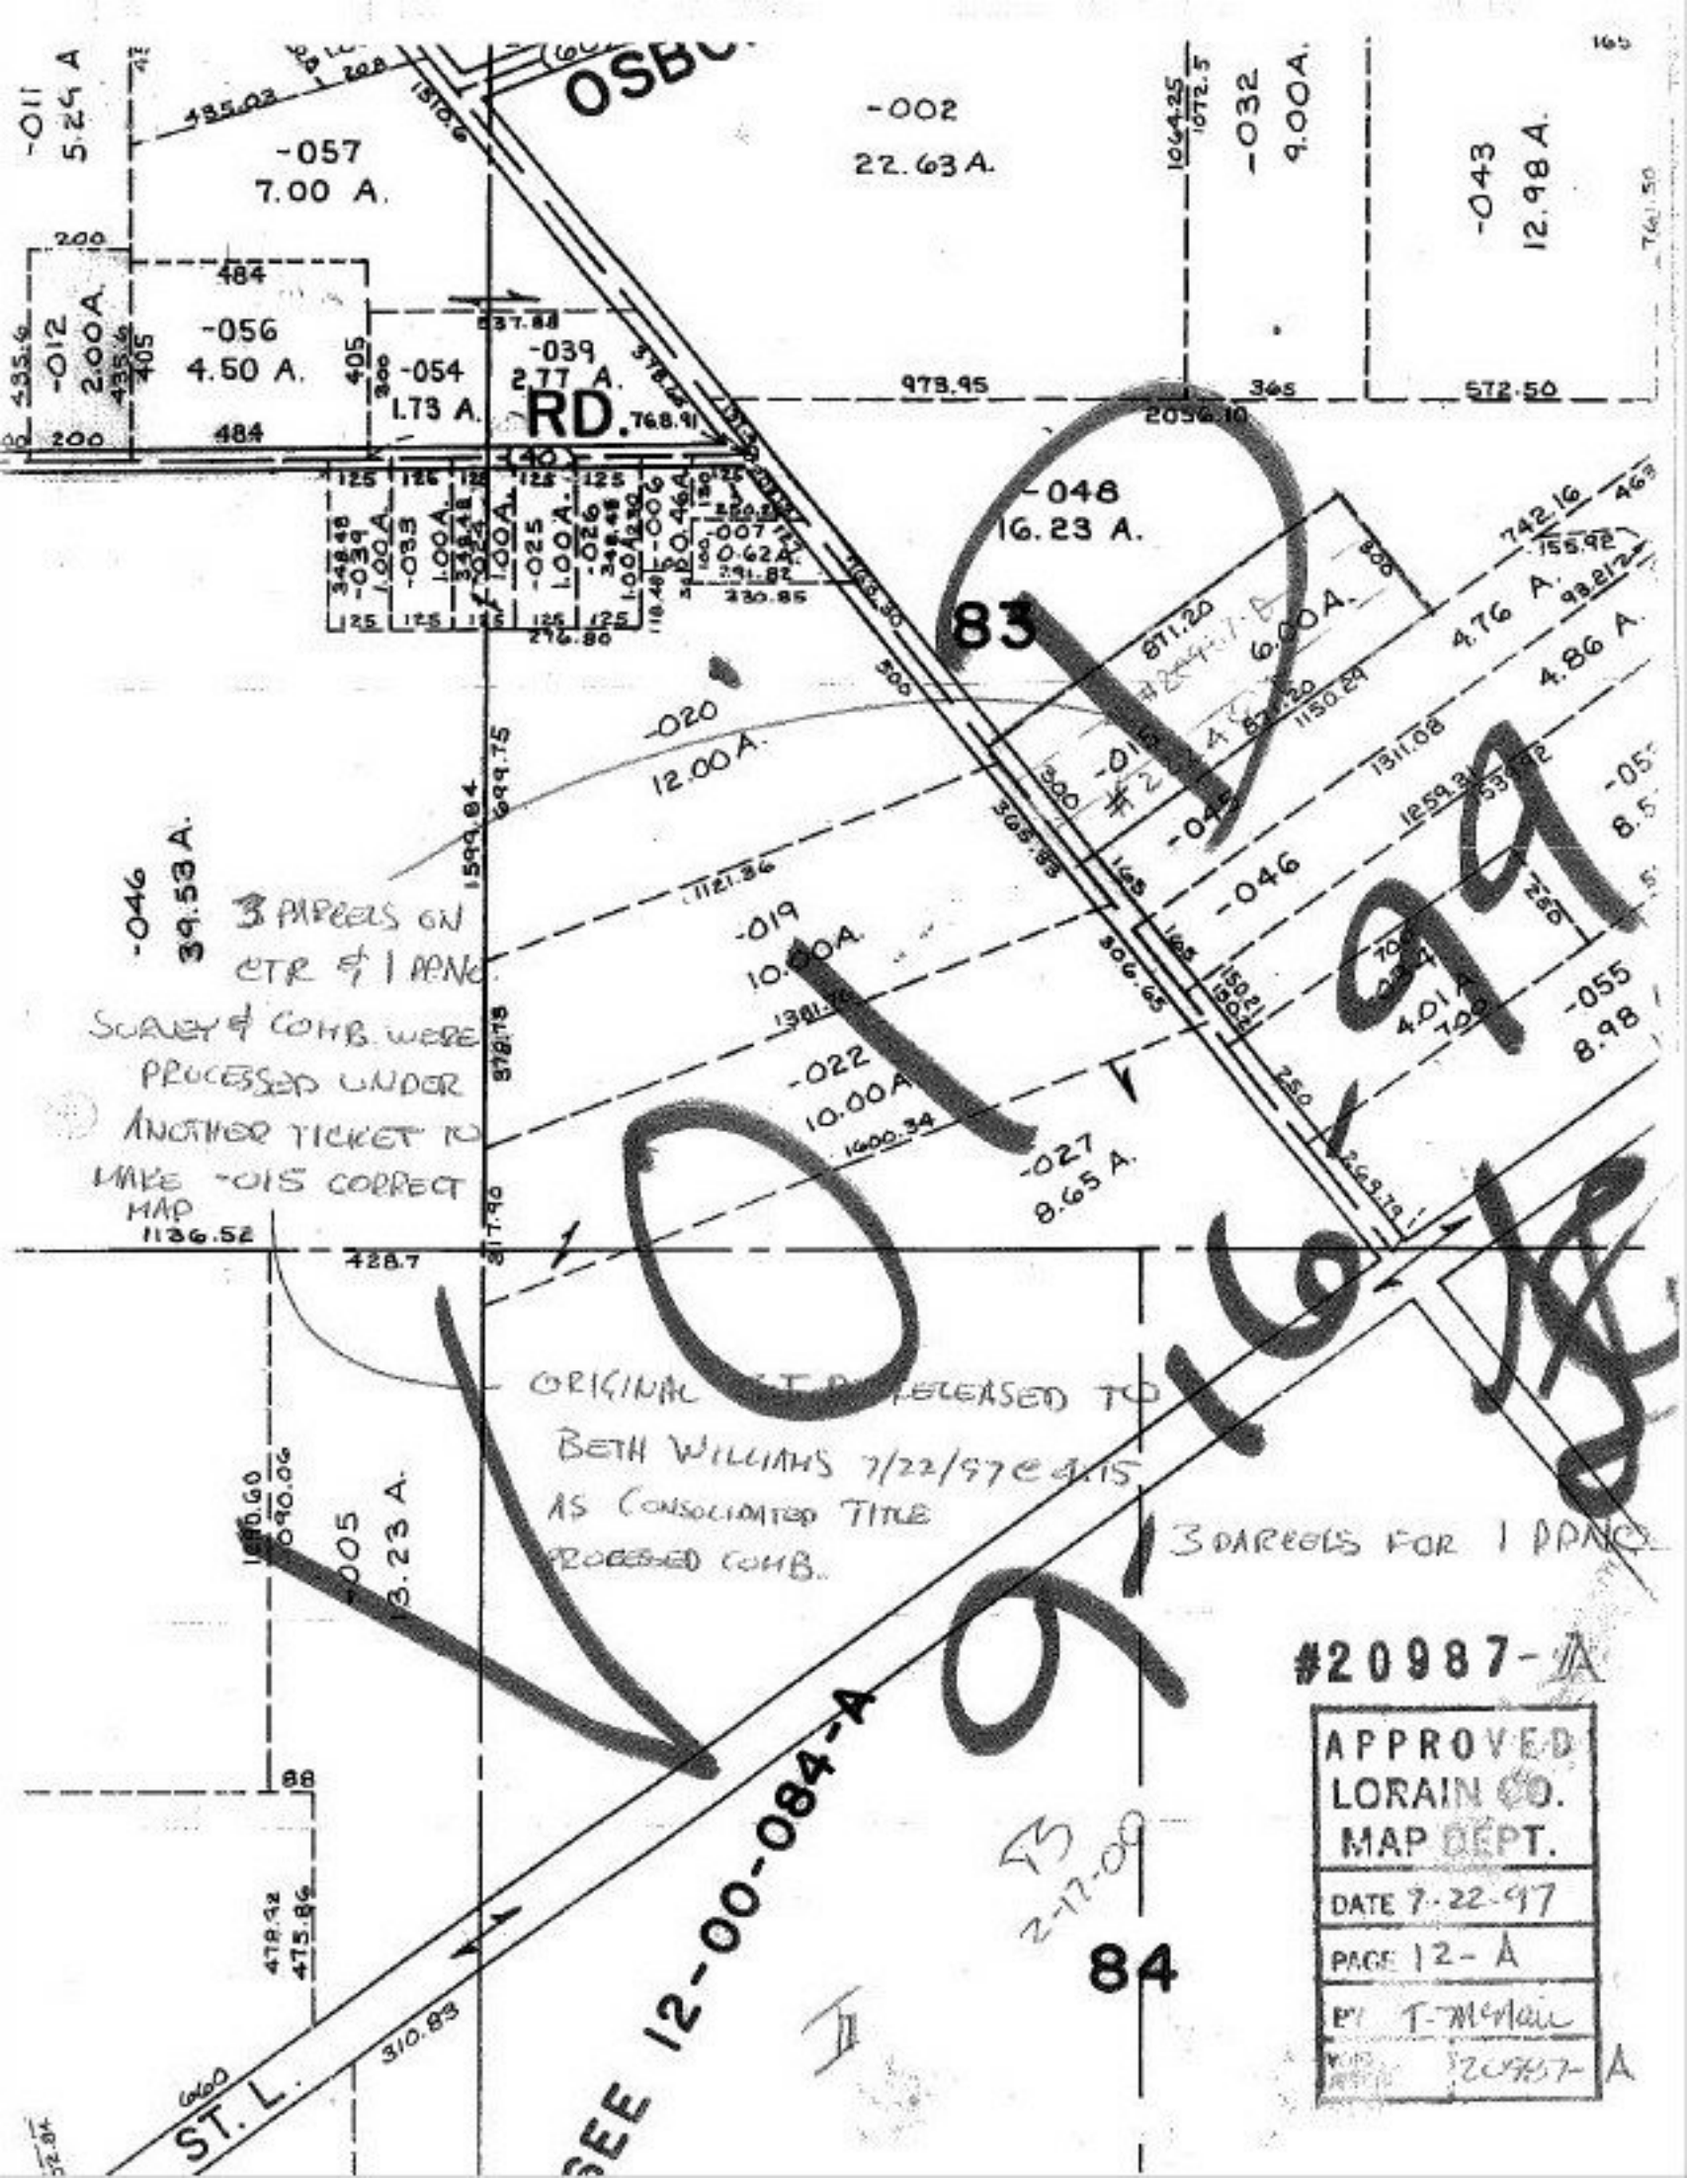
-011
5.24 A
-057
7.00 A.
-002
22.63 A.
-032
9.00A.
-043
12.98 A.
-012
2.00A.
-056
4.50 A.
-054
1.73 A.
-039
2.77 A.
RD.
-048
16.23 A.
83
-020
12.00A.
-046
39.53 A.
-019
10.00A.
-022
10.00A
-027
8.65 A.
-046
-055
8.98
4.76 A.
4.86 A.
6.00A.
4.01 A
3 PARCELS ON CTR & 1 APP'D. SURVEY & COMB. WERE PROCESSED UNDER ANOTHER TICKET TO MAKE -015 CORRECT MAP
ORIGINAL ... RELEASED TO BETH WILLIAMS 7/22/97 e-mail AS CONSOLIDATED TITLE PROCESSED COMB.
3 PARCELS FOR 1 APP'D
-005
3.23 A.
84
SEE 12-00-084-A
ST. L.
#20987-A
APPROVED
LORAIN CO.
MAP DEPT.
DATE 7-22-97
PAGE 12-A
BY T-McNair
MAP #20987-A