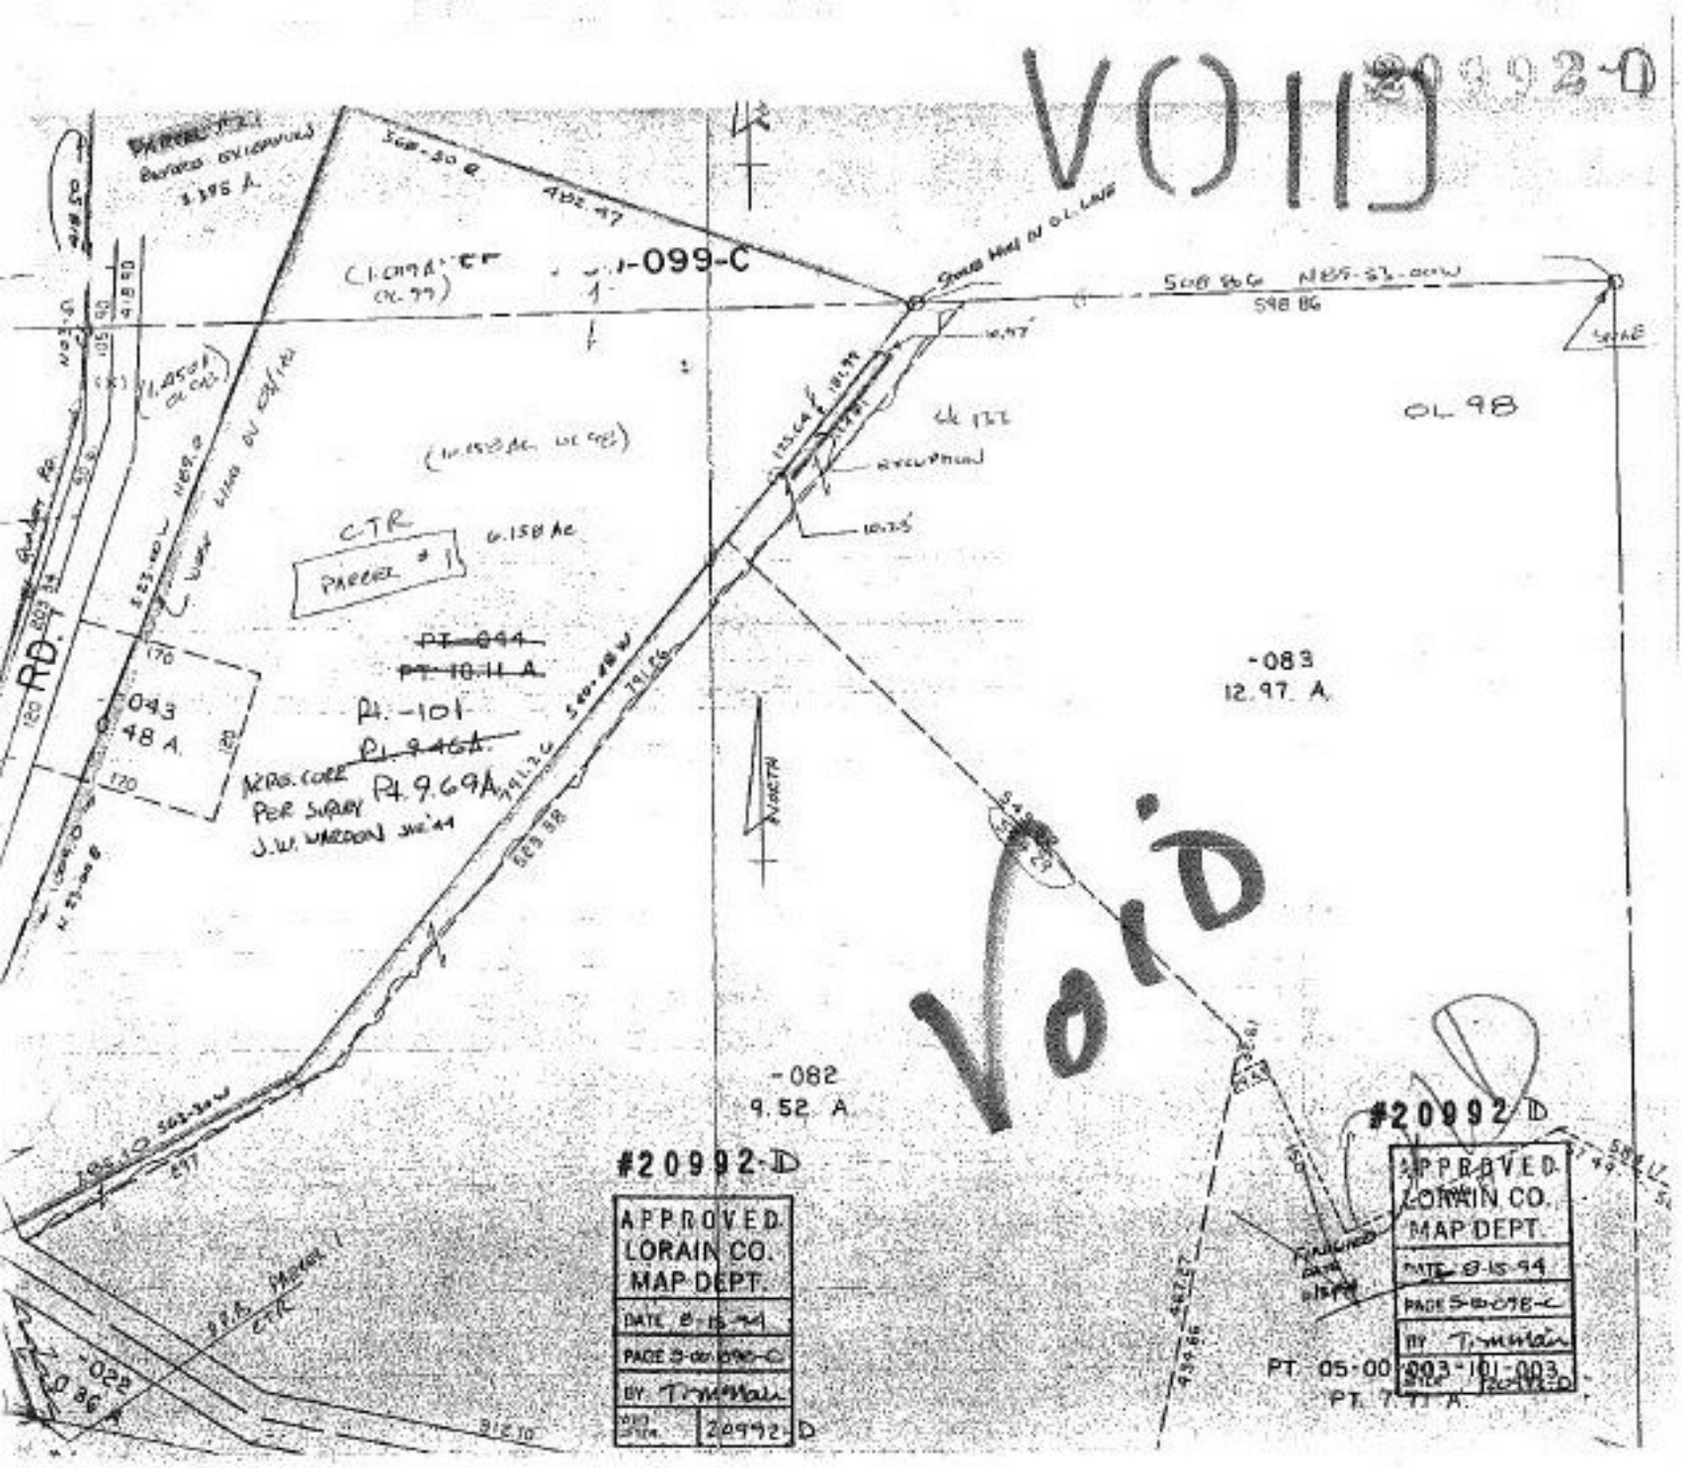
VOID
20992-D
PARCEL #1
Surveyed Oct. 1993
3.196 A.
S68-30 E
482.47
(1.099A. OL 99)
1-099-C
Ground Meas to O.L. Line
S68 BG
N89-53-00W
S68 BG
OL 98
OL 97
(1.450A OL 98)
(10.150Ac OL 98)
CTR
PARCEL #1
6.158 Ac
RD.1
-043
48 A.
PT. 044
PT. 10.11 A.
Pt. -101
Pt. 9.46A.
Pt. 9.69A.
PER SURV
J.W. WILDON JUL '44
S89 58
-083
12.97 A.
VOID
-082
9.52 A.
#20992-D
APPROVED
LORAIN CO.
MAP DEPT.
DATE 8-15-94
PAGE 5-00-078-C
BY TMcMain
PRO SITE 20992-D
#20992-D
APPROVED
LORAIN CO.
MAP DEPT.
DATE 8-15-94
PAGE 5-00-078-C
BY TMcMain
PT. 05-00-003-101-003
PT. 7.77 A.
-028
3.86 A.
PARCEL 1
CTR