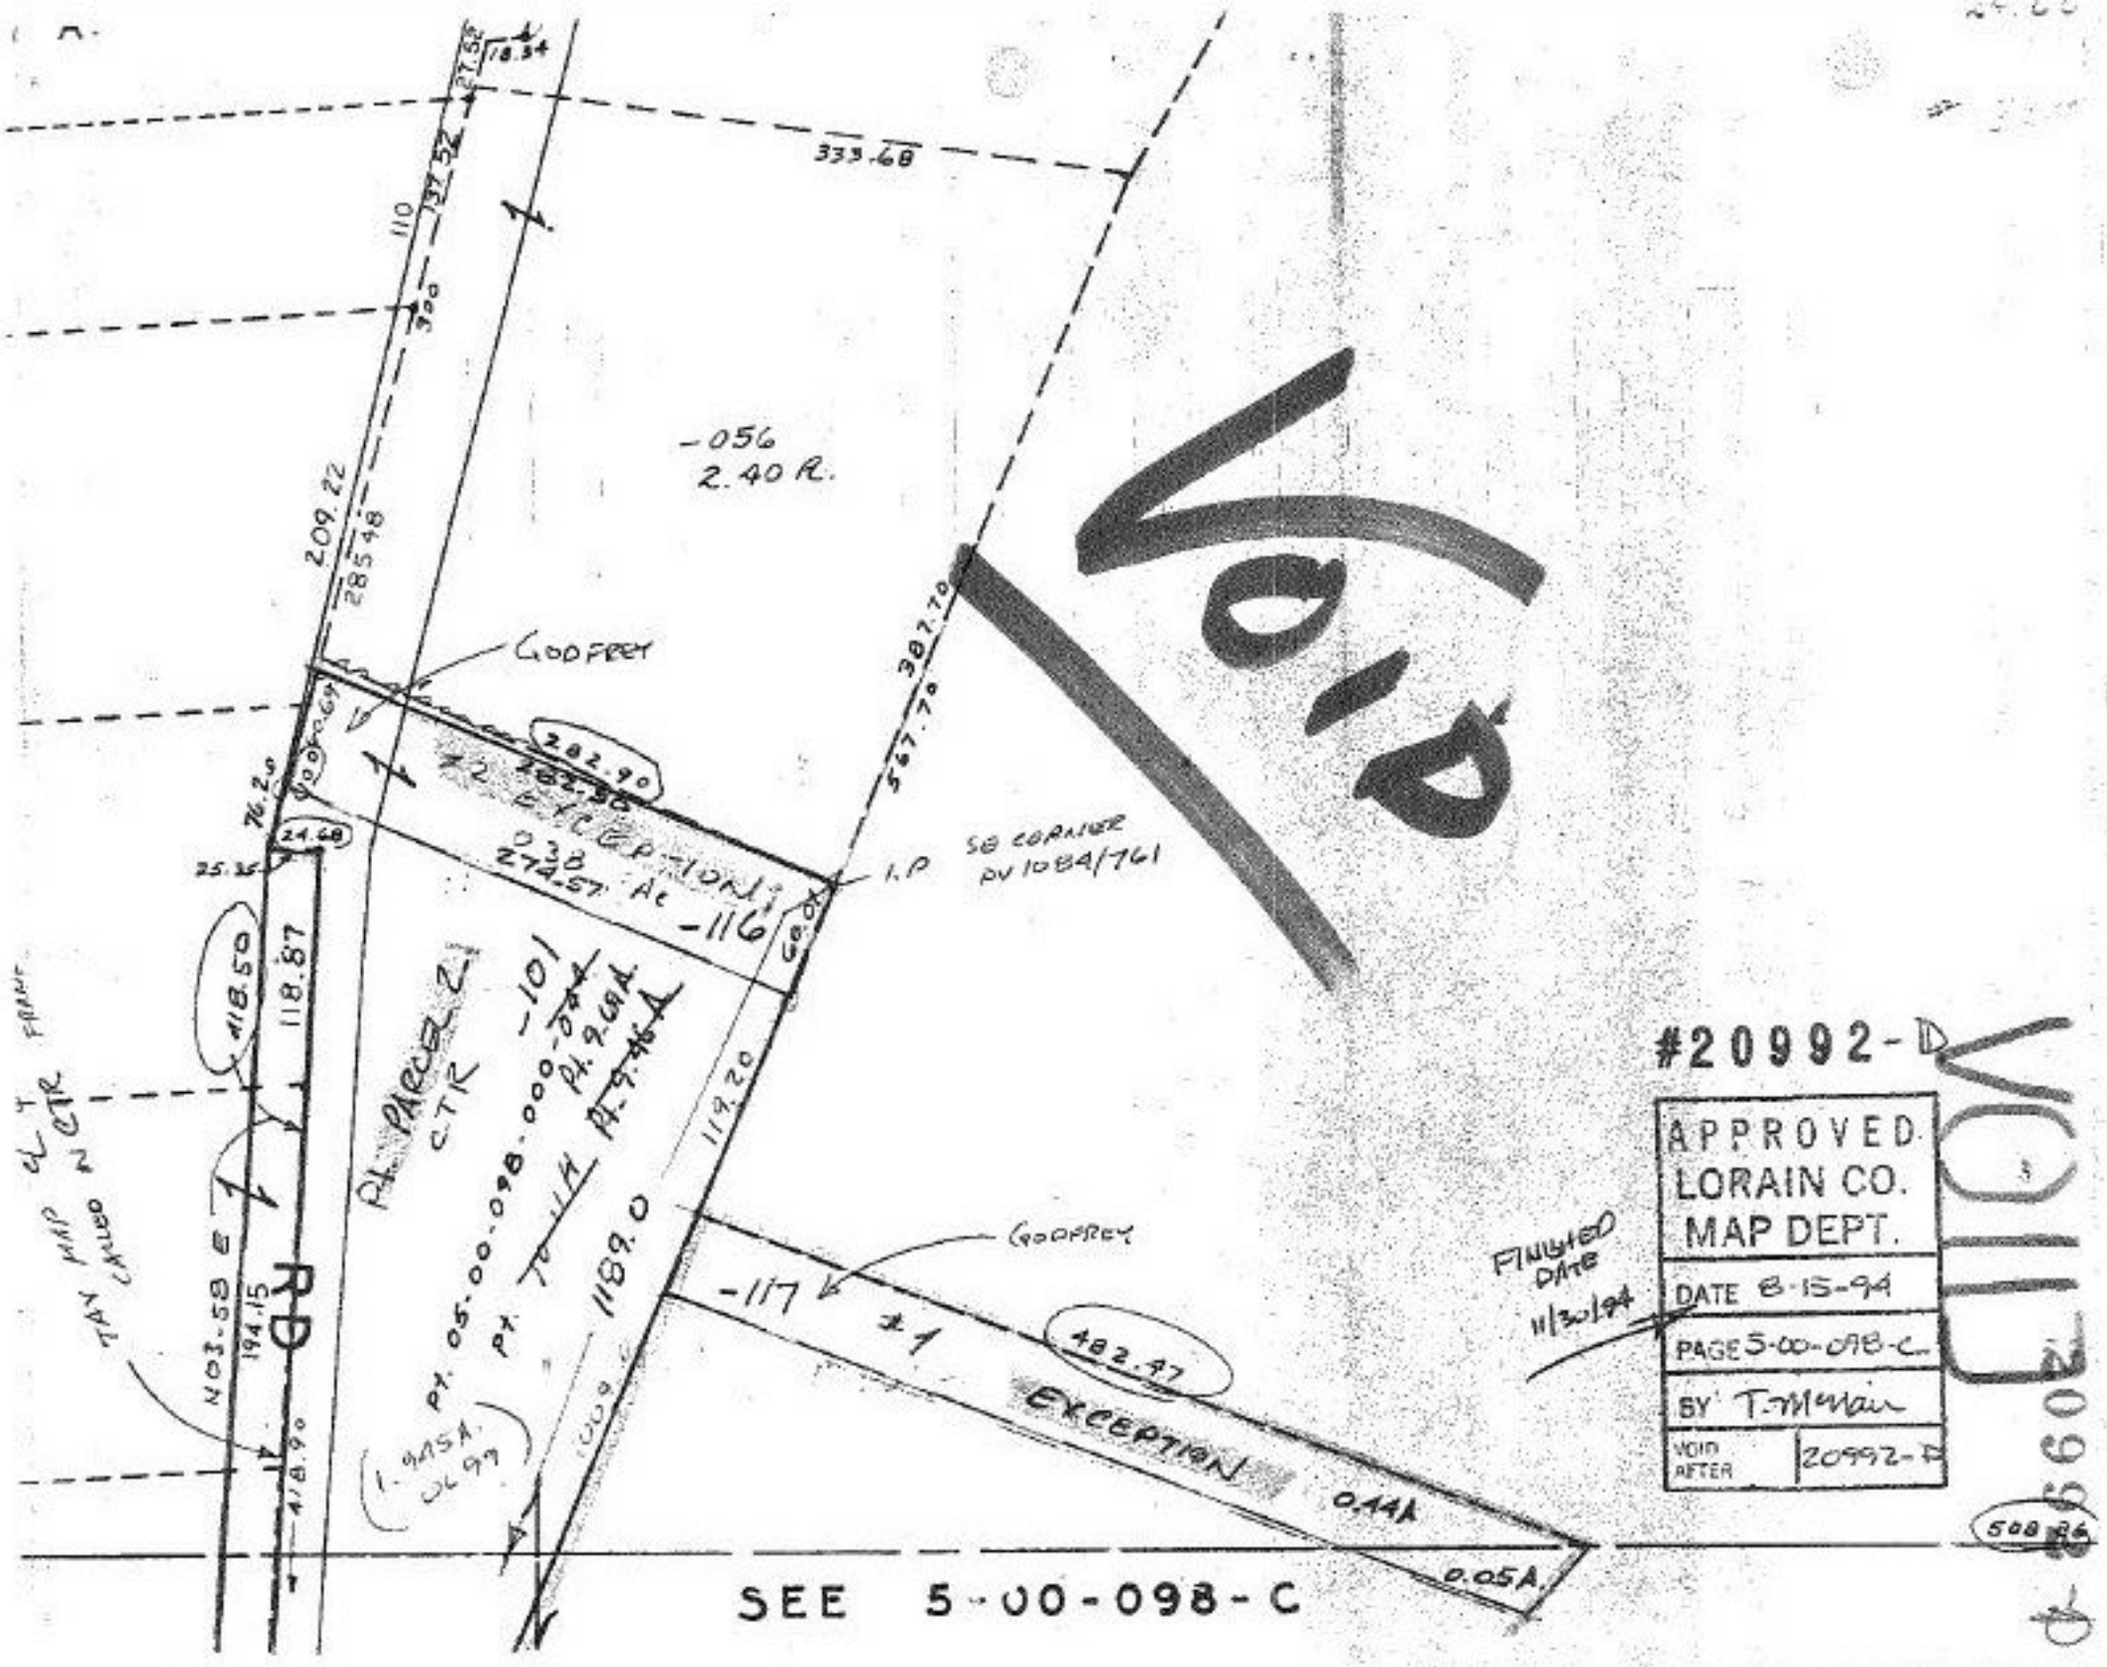
VOID
333.68
110
197.52
209.22
285.48
-056
2.40 R.
GODFREY
282.90
182.52
1.2 EXCEPTION
0.38
274.57 Ac
-116
I.P
SE CORNER
PV 1084/761
307.70
567.70
76.20
24.68
25.15
118.50
118.87
-101
PT. PARCEL 1
CTR
PT. 05-00-098-000-3
PT. 9.69A
PT. 7.11A
PT. 9.46A
1189.0
119.20
GODFREY
-117
1.1
482.47
EXCEPTION
0.44A
0.05A
508.86
SEE 5-00-098-C
TAX MAP N CTR
N03.58 E
194.15
418.90
RD
(1.9454 OL 93)
#20992-D
APPROVED
LORAIN CO.
MAP DEPT.
DATE 8-15-94
PAGE 5-00-098-C
BY T. McMain
VOID AFTER 20992-D
FINISHED DATE 11/30/94
VOID
D 560