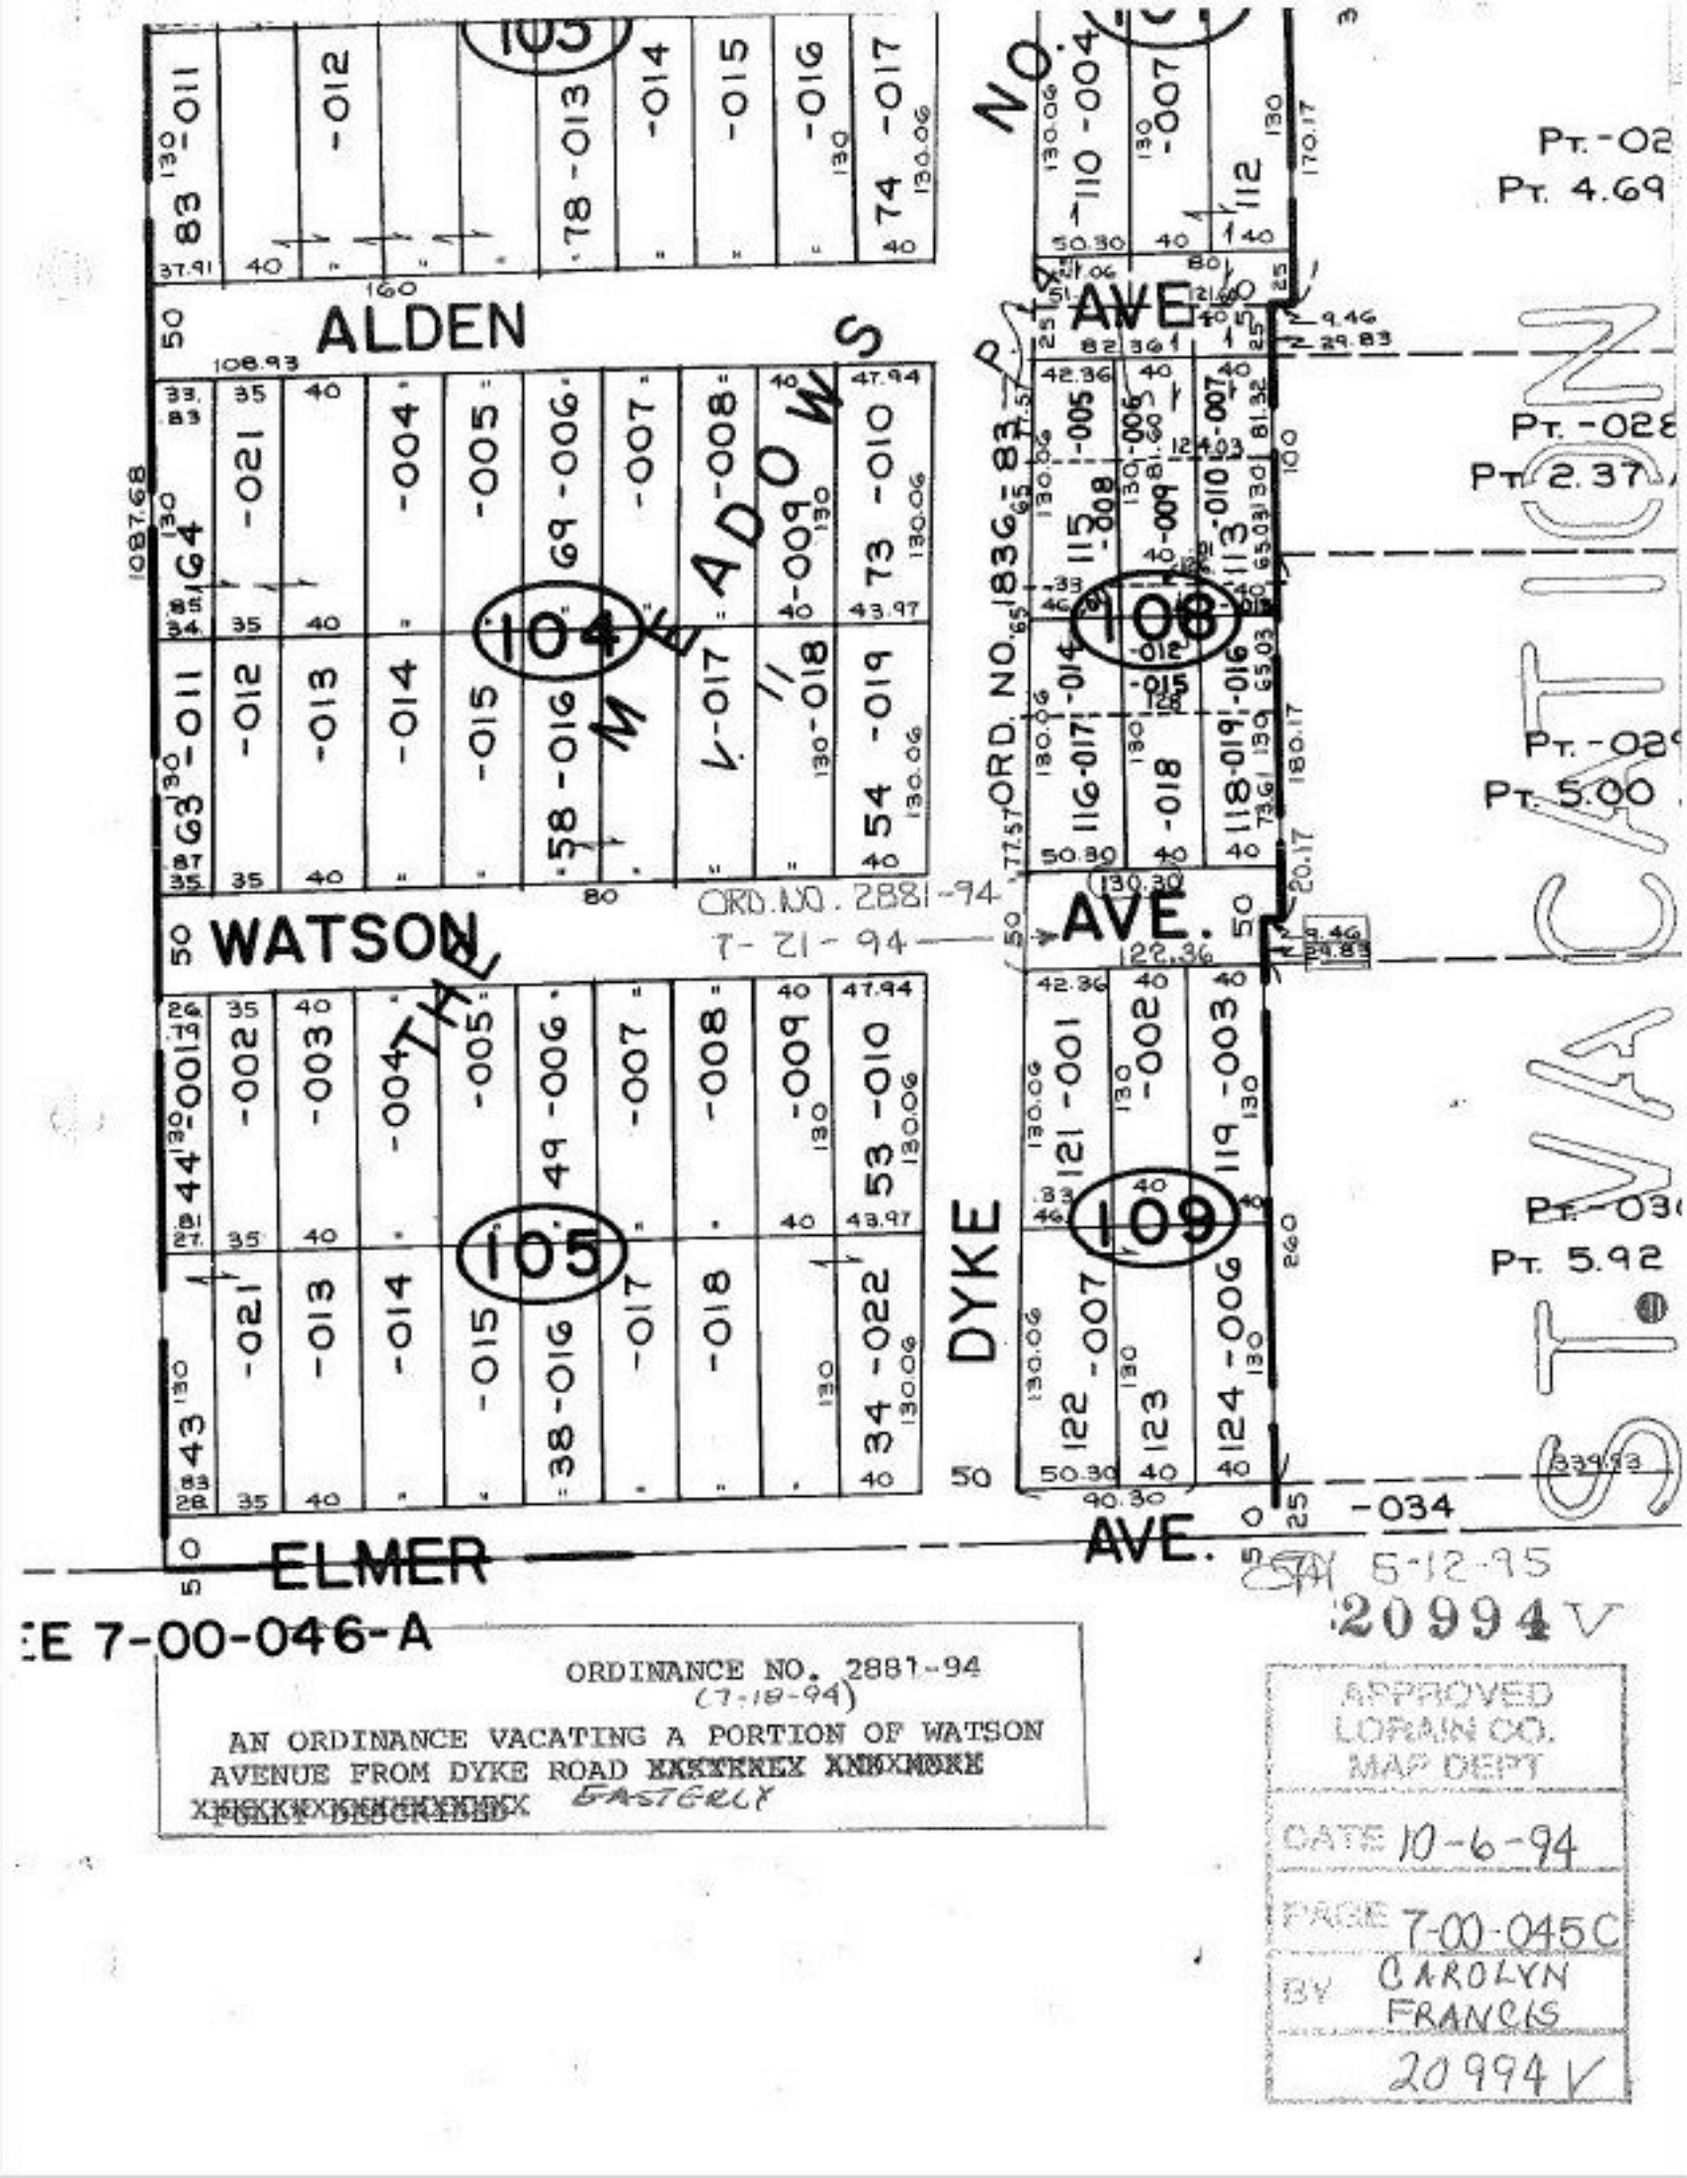

E 7-00-046-A

ORDINANCE NO. 2881-94
(7-18-94)

AN ORDINANCE VACATING A PORTION OF WATSON AVENUE FROM DYKE ROAD ~~EASTERLY AND WESTERLY~~ EASTERLY ~~PARTLY DESCRIBED~~

5-12-95
20994 V

APPROVED
LORAIN CO.
MAP DEPT
DATE 10-6-94
PAGE 7-00-045C
BY CAROLYN FRANCIS
20994 V