#20995-X

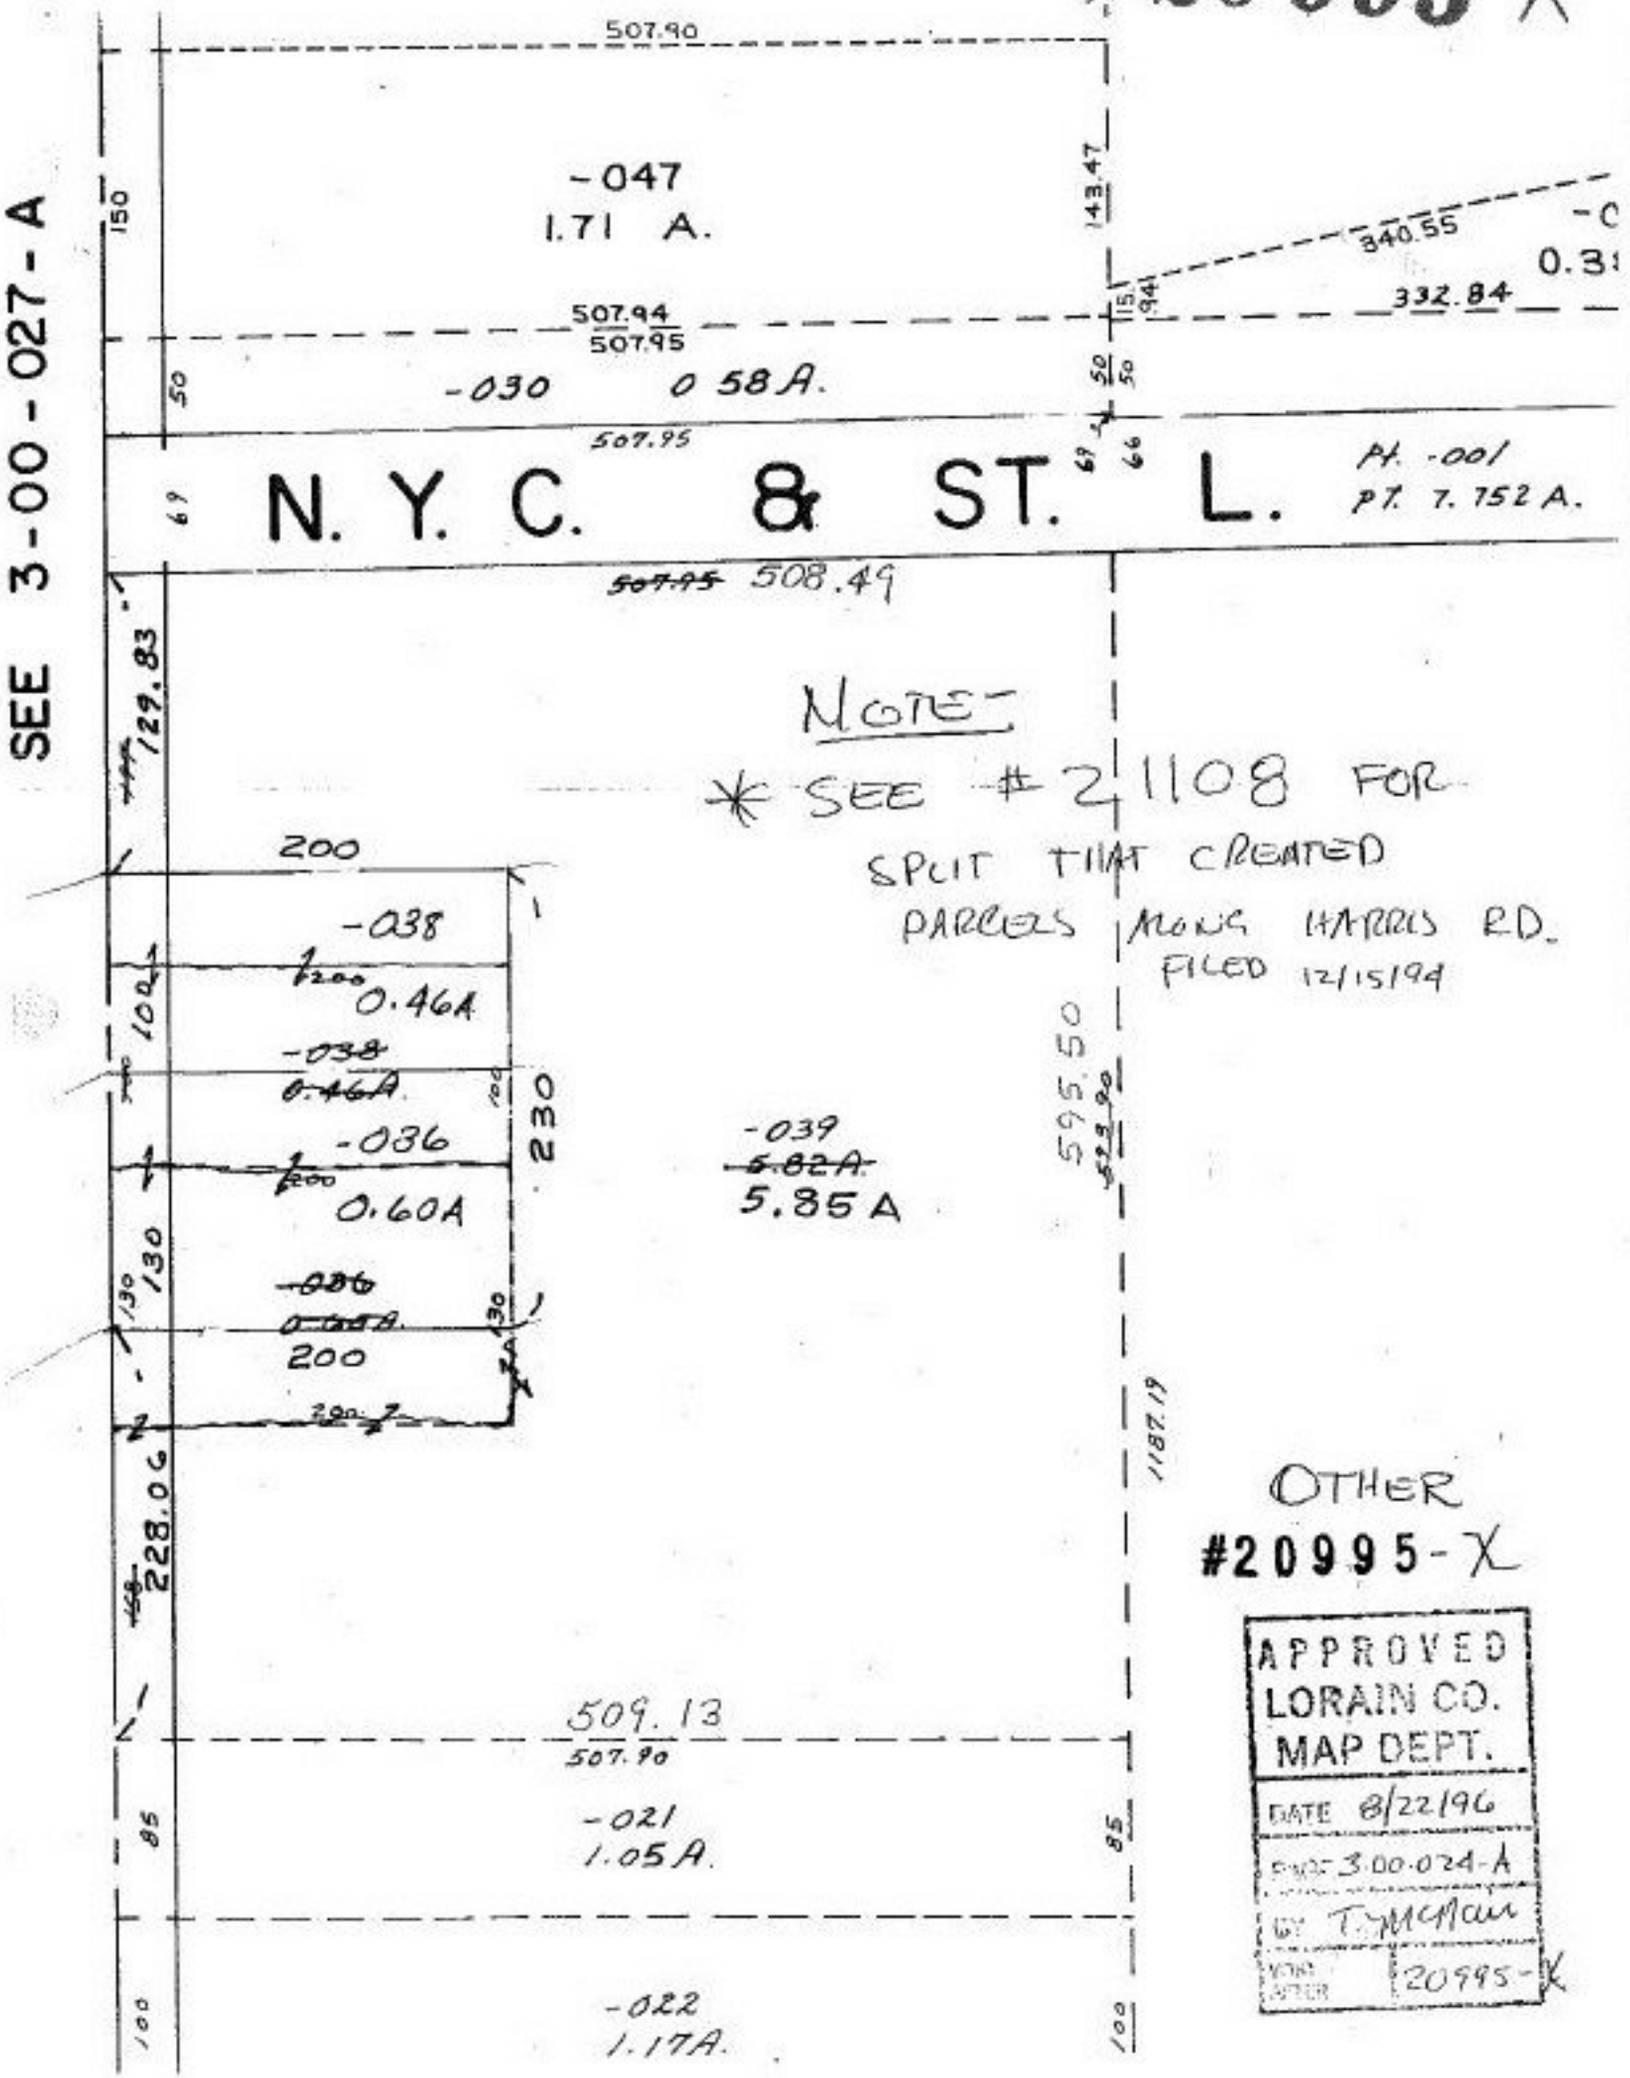

OTHER
#20995-X

APPROVED
LORAIN CO.
MAP DEPT.
DATE 8/22/96
PARCEL 3-00-024-A
BY T. McMan
WORK ORDER 20995-X