20996

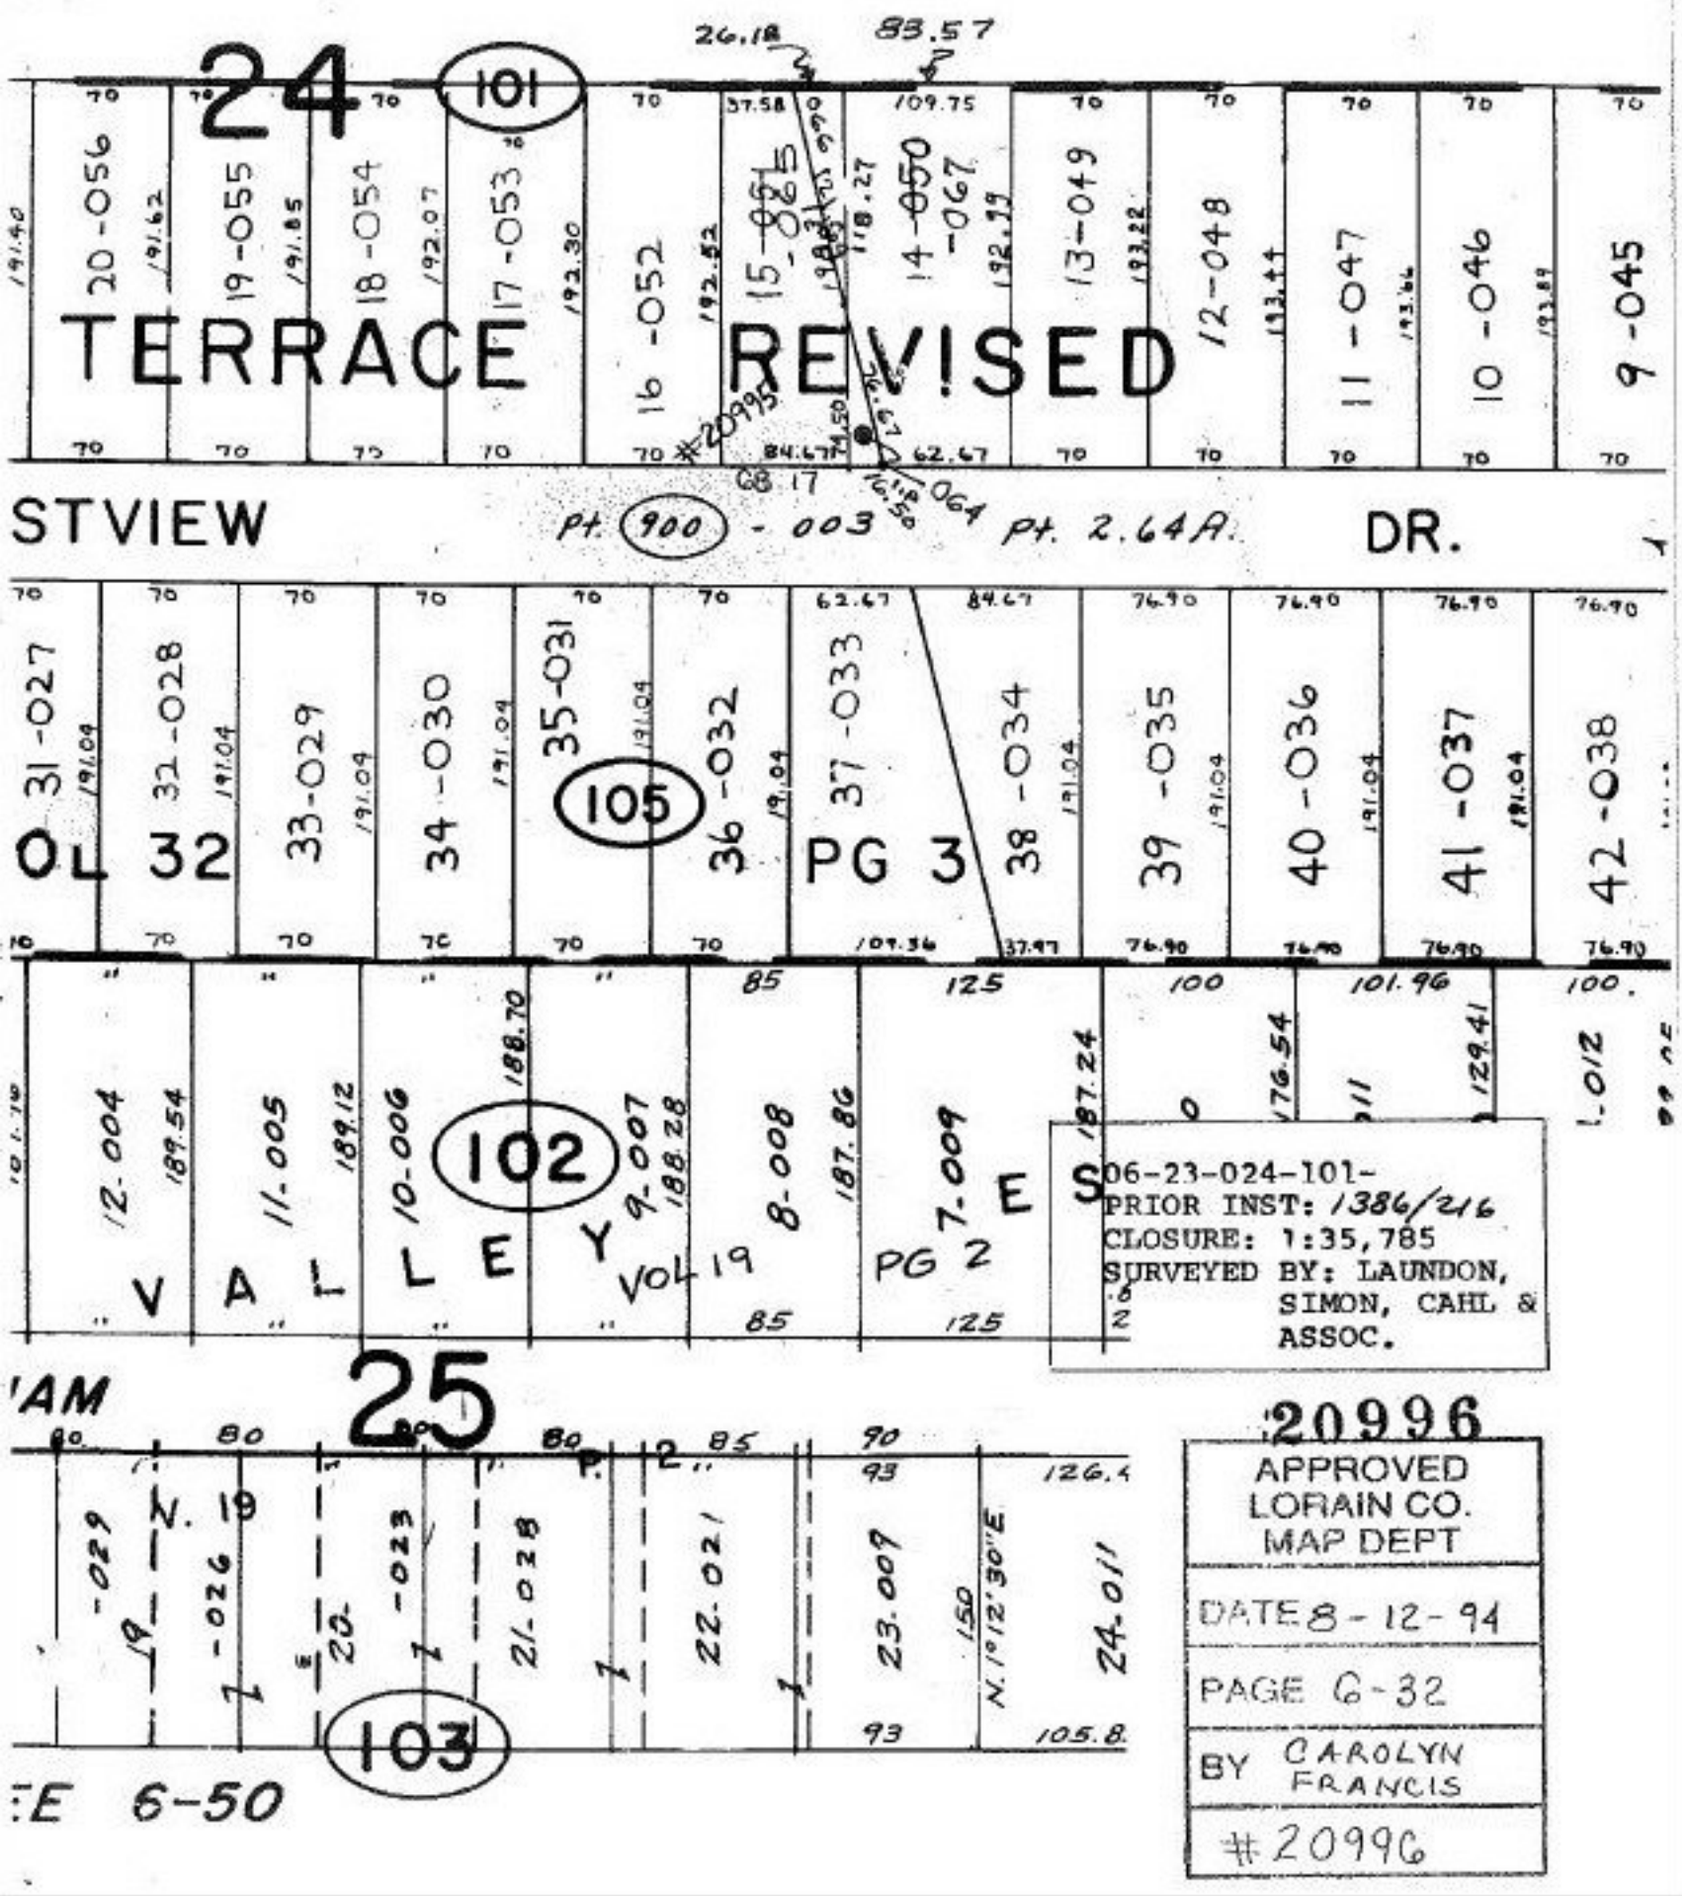

20996

APPROVED
LORAIN CO.
MAP DEPT

DATE 8-12-94

PAGE G-32

BY CAROLYN FRANCIS

#20996