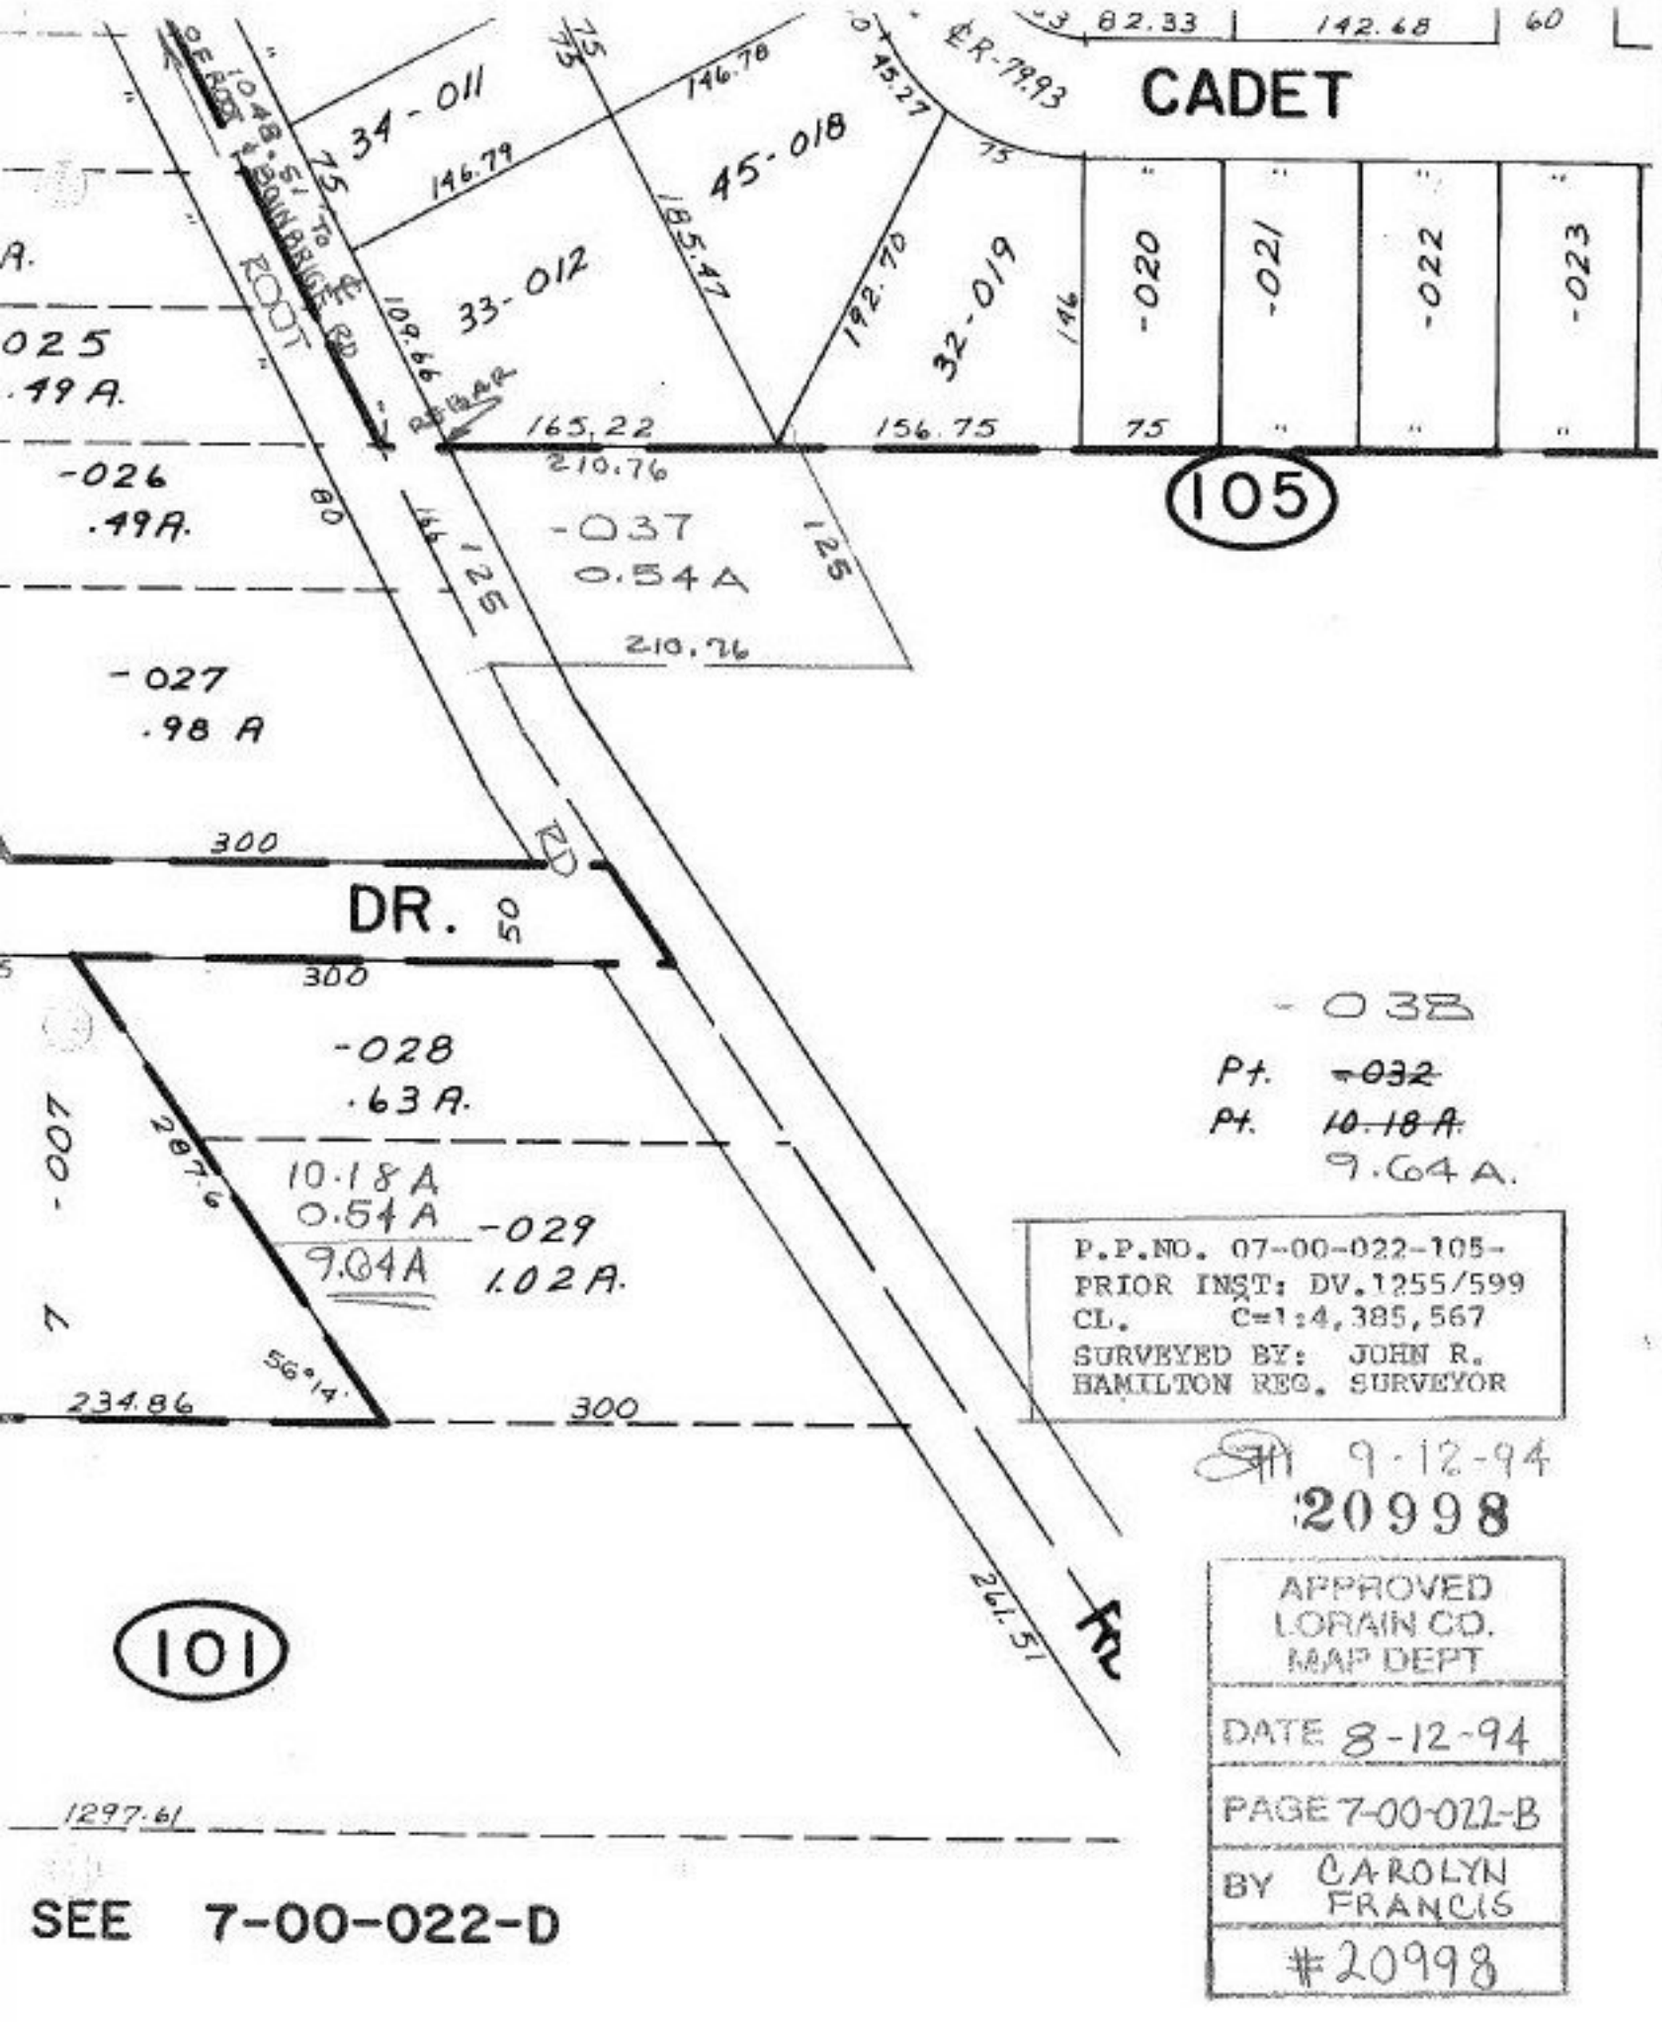
CADET
105
DR.
101
-034-011
-045-018
-033-012
-032-019
-020
-021
-022
-023
-026
.49A.
-027
.98 A
-037
0.54A
-028
.63A.
-029
1.02A.
10.18A
0.54A
9.64A
-007
-038
Pt. -032
Pt. 10.18A
9.64A.
P.P.NO. 07-00-022-105-
PRIOR INST: DV.1255/599
CL. C=1:4,385,567
SURVEYED BY: JOHN R. HAMILTON REG. SURVEYOR
9-12-94
20998
APPROVED LORAIN CO. MAP DEPT
DATE 8-12-94
PAGE 7-00-022-B
BY CAROLYN FRANCIS
#20998
SEE 7-00-022-D
7-00-022-B