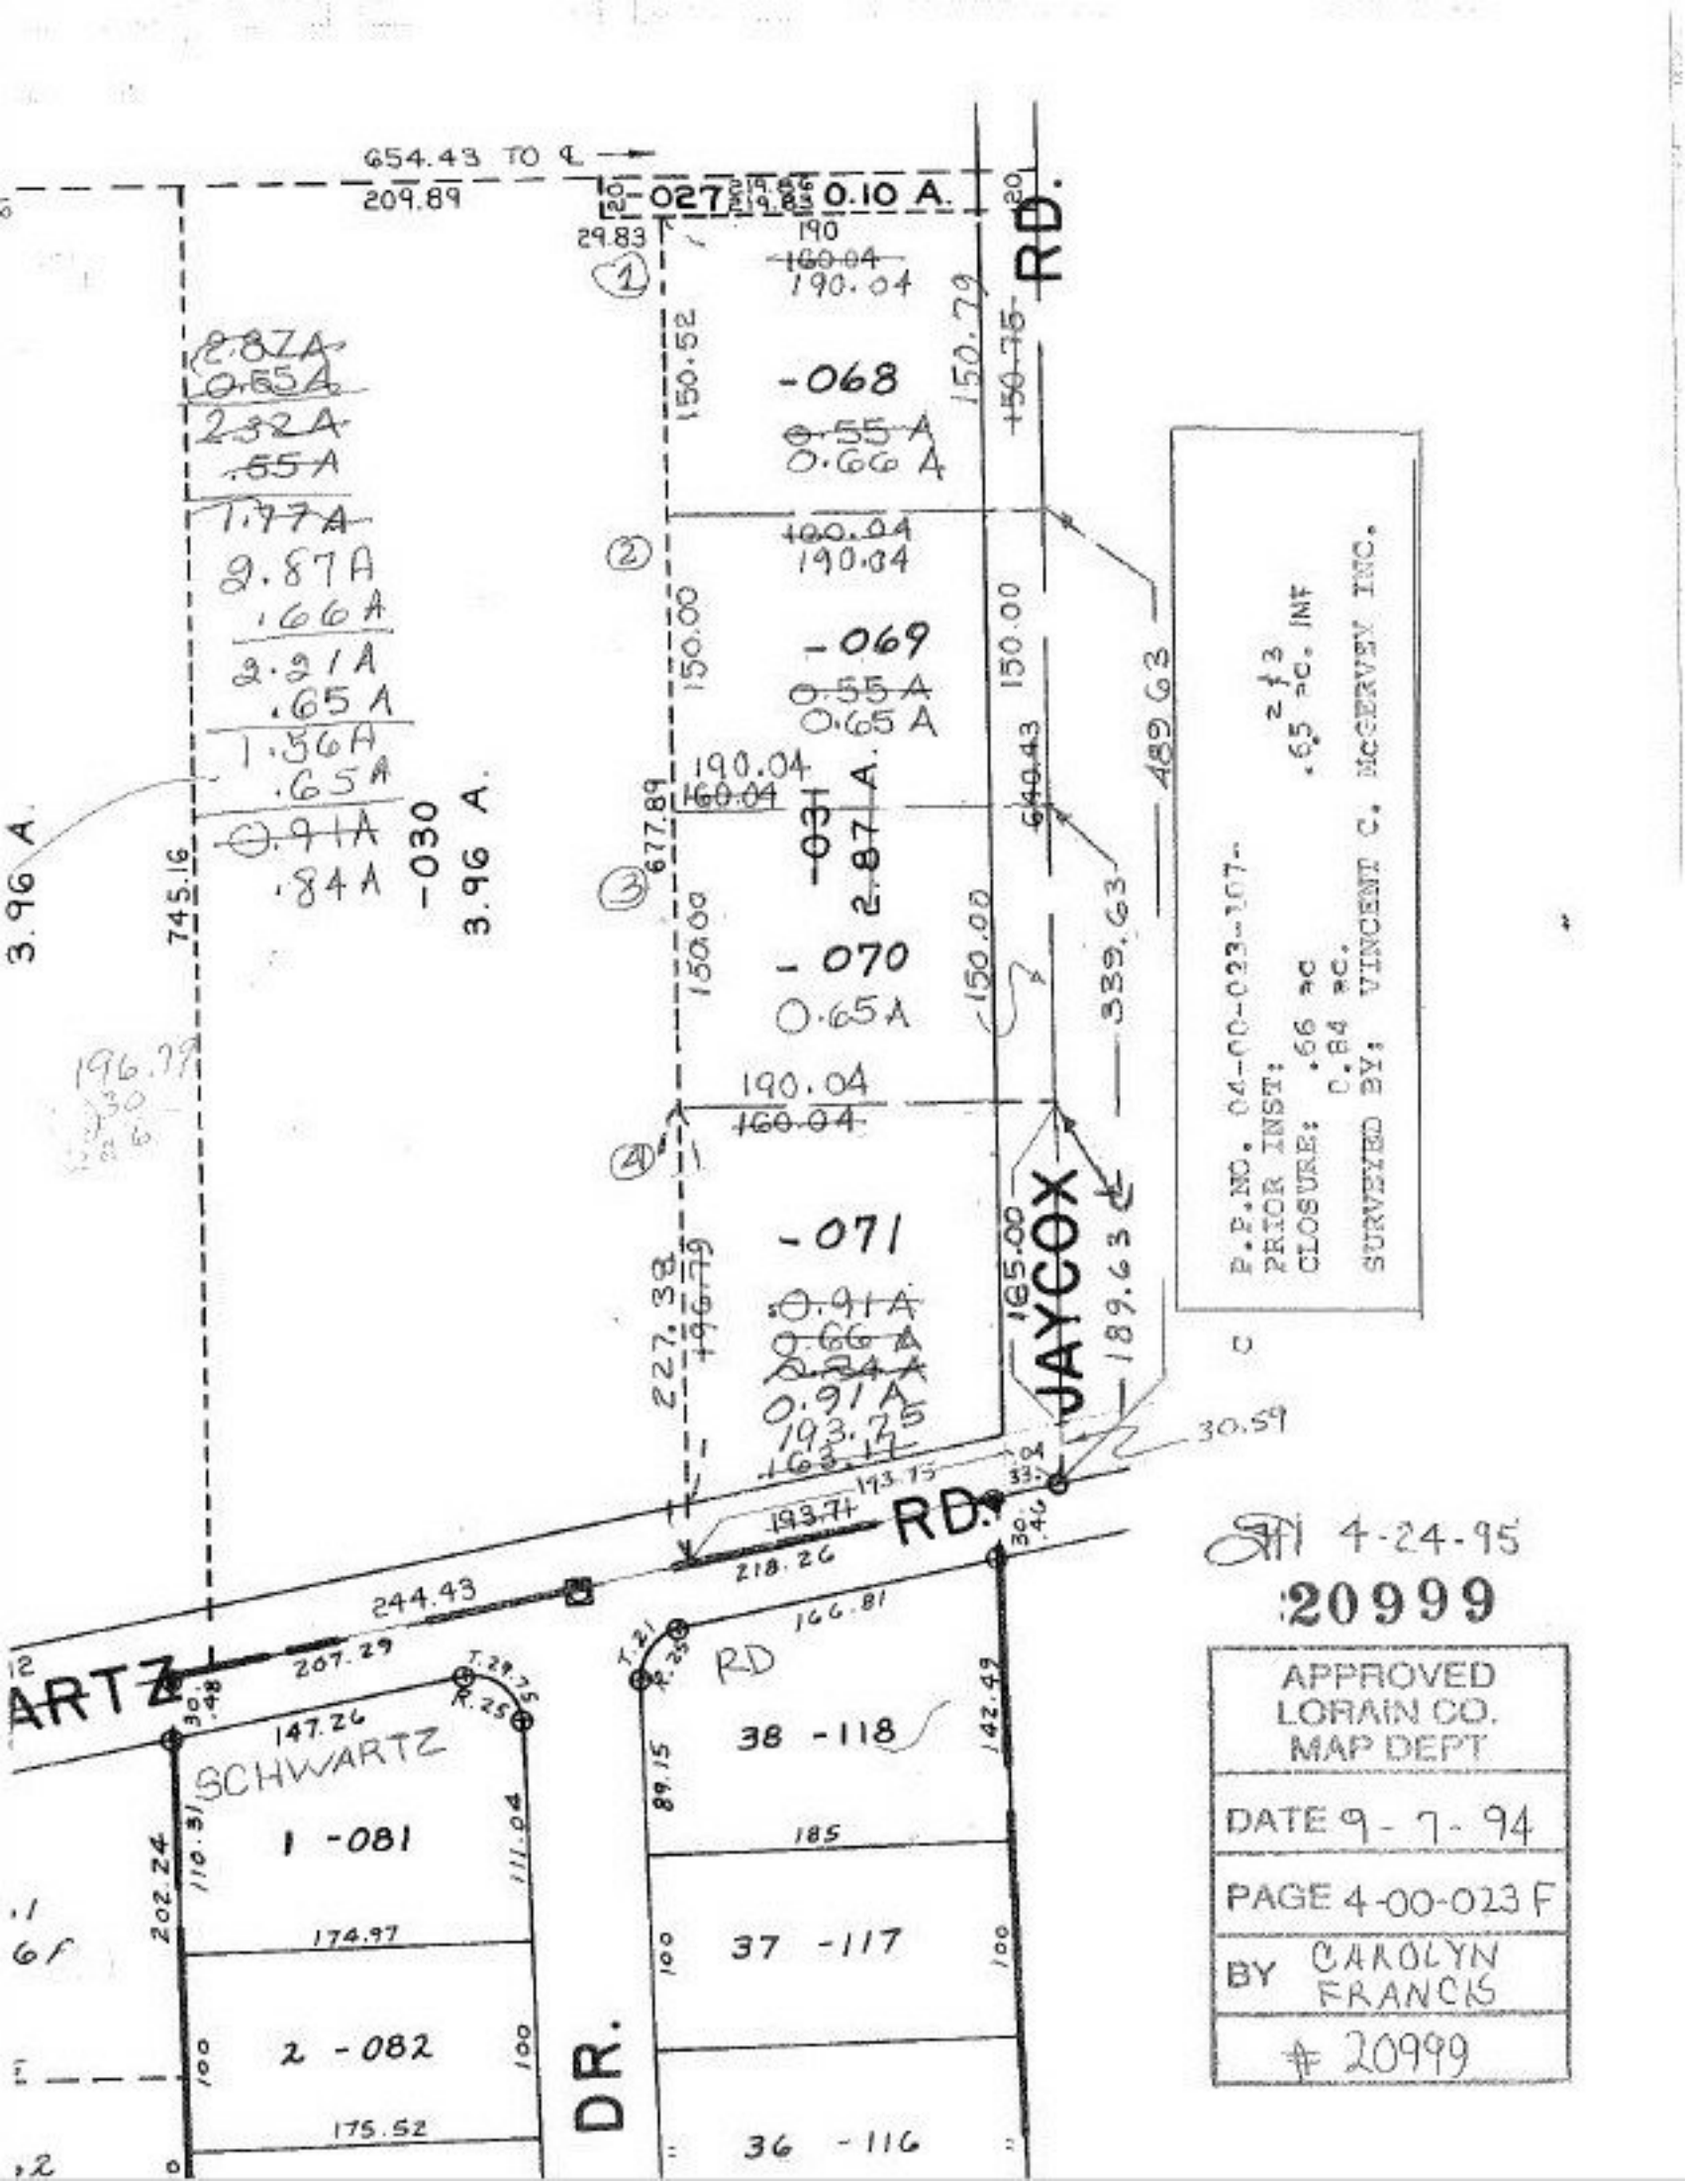
654.43 TO ℄
209.89
-027 0.10 A.
RD.
-068
0.55 A
0.66 A
-069
0.55 A
0.65 A
-031 2.87 A.
-070
0.65 A
-071
0.91 A
0.66 A
0.91 A
-030
3.96 A.
JAYCOX
RD.
244.43
SCHWARTZ
1 -081
2 -082
DR.
38 -118
37 -117
36 -116
RD
P.P.NO. 04-00-023-107--
PRIOR INST;
CLOSURE; .66 ac
.84 ac.
.65 ac. INF
SURVEYED BY; VINCENT C. McGERVEY INC.
APPROVED
LORAIN CO.
MAP DEPT
DATE 9-7-94
PAGE 4-00-023 F
BY CAROLYN FRANCIS
# 20999
4-24-95
20999