PARENT PARCEL: 03-00-037-102-009, -010 & -011
CHILD PARCEL: 03-00-037-102-088 THRU -093
STARTING POINT: CL OF U.S. 6 & LAFAYETTE BLVD.

21-00780

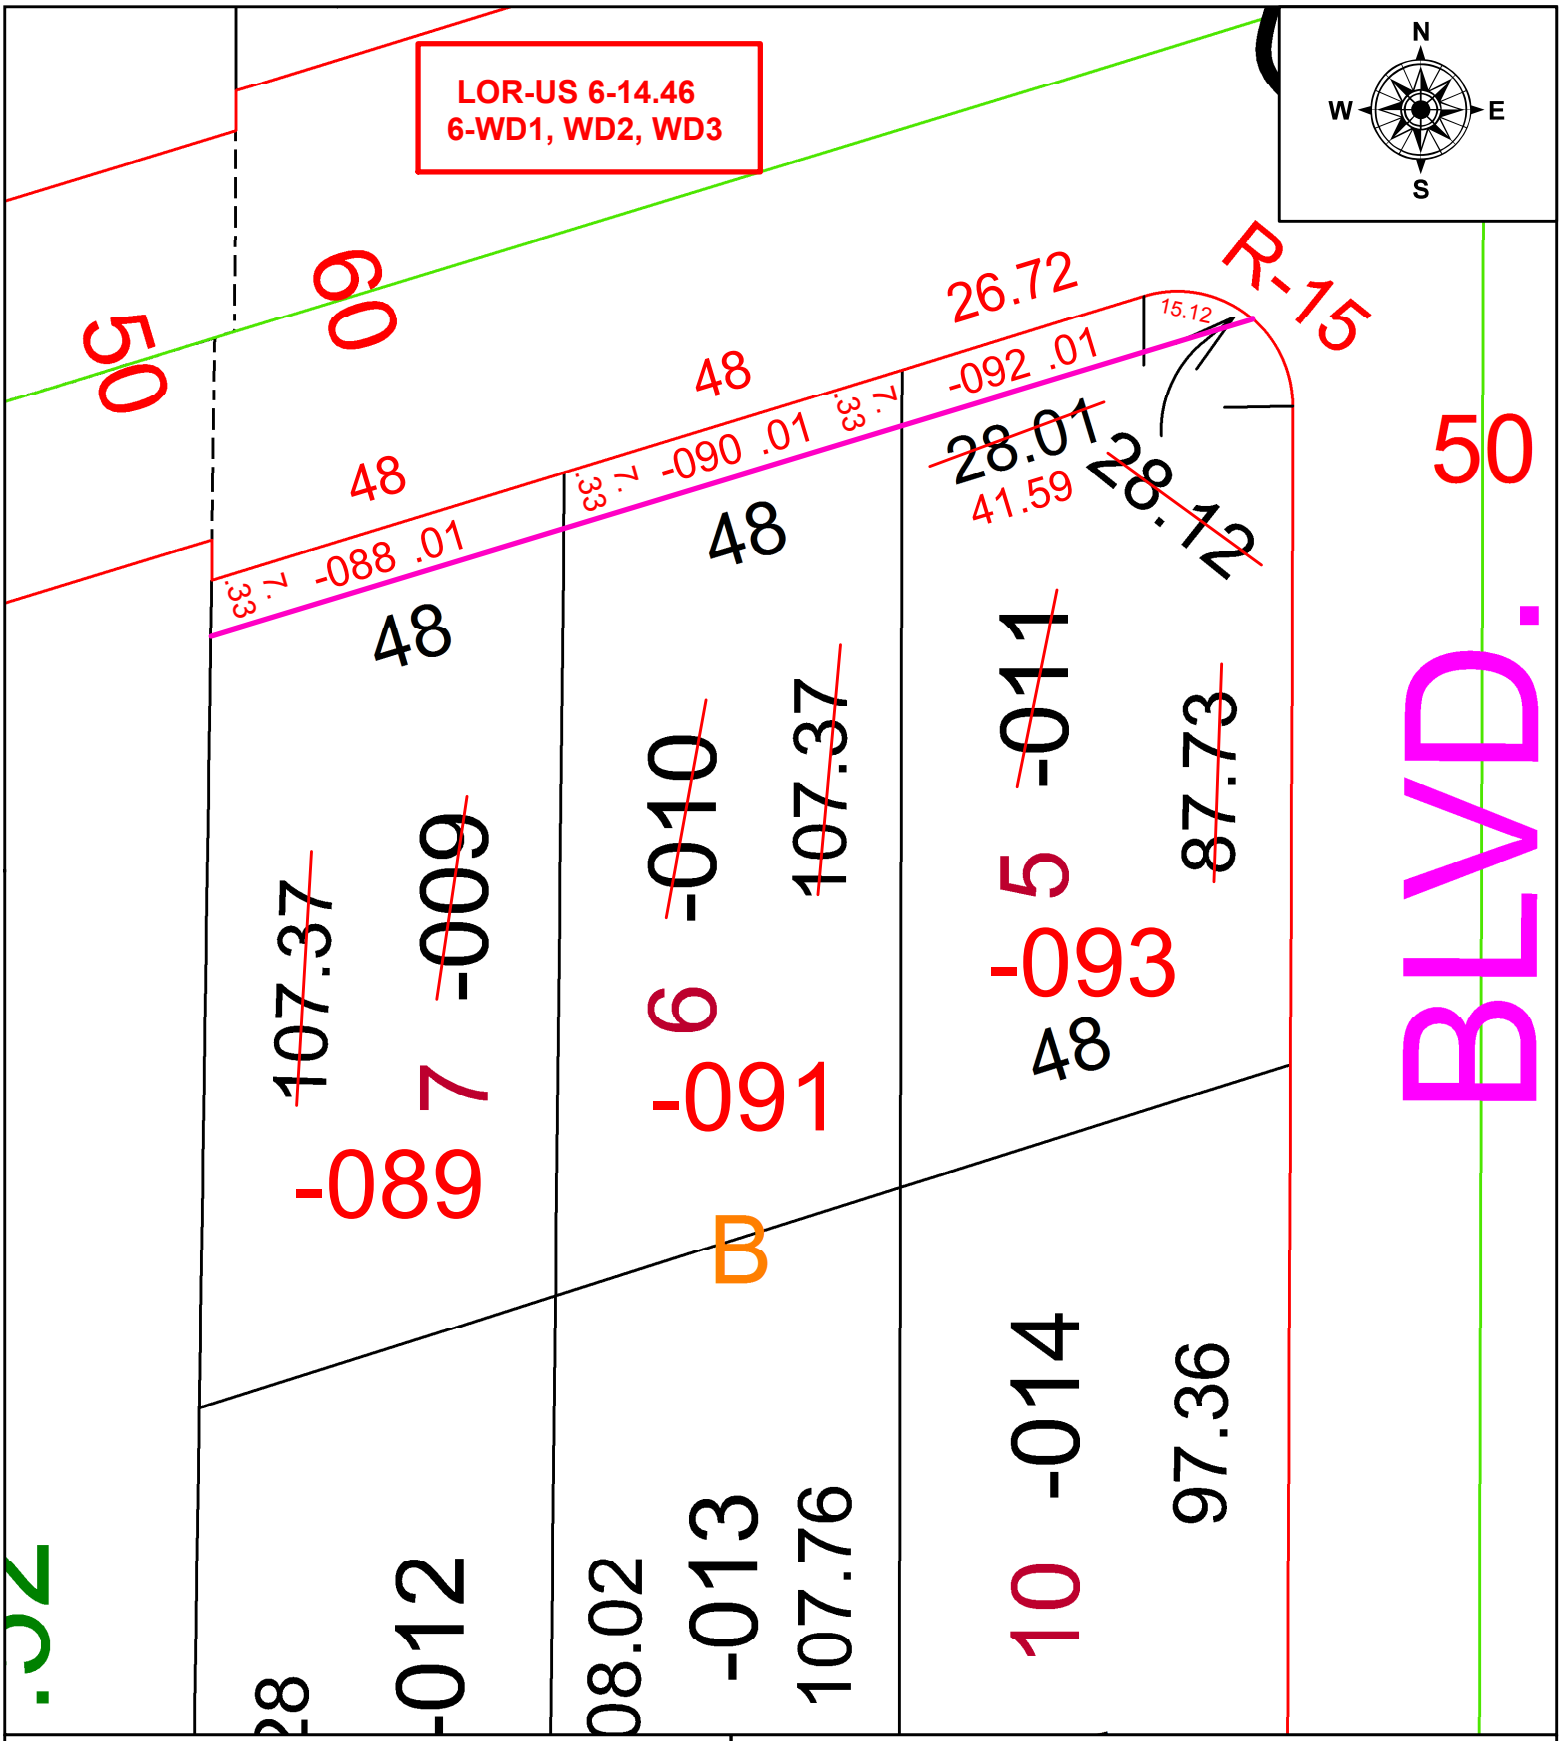

SPLITS/DEEDS PROCESSED
LORAIN COUNTY TAX MAP DEPARTMENT
226 MIDDLE AVE. ELYRIA, OH

SURVEYED BY: AMY KELLY
CLOSURE: 1: 2147483648
MAP PAGE(S): 03-00-037
APPOVED BY: DMA **DATE:** 11/18/2021
SCALE: 1" = 25' **PRIOR INSTRUMENT:** O.R. VOL 1312 PG. 500