PARENT PARCEL: 05-00-020-000-243, -244, -246 & -247

CHILD PARCEL: FRONTAGE CORR. -243, -244, -246 FROM 49.75 TO 50.00 & -247 FROM 49.51 TO 49.26

STARTING POINT: CERT. OR CORR. RESERVE AT BEAVER CREEK SUB. NO. 3 PV. 107 PG. 82

21-04663-C

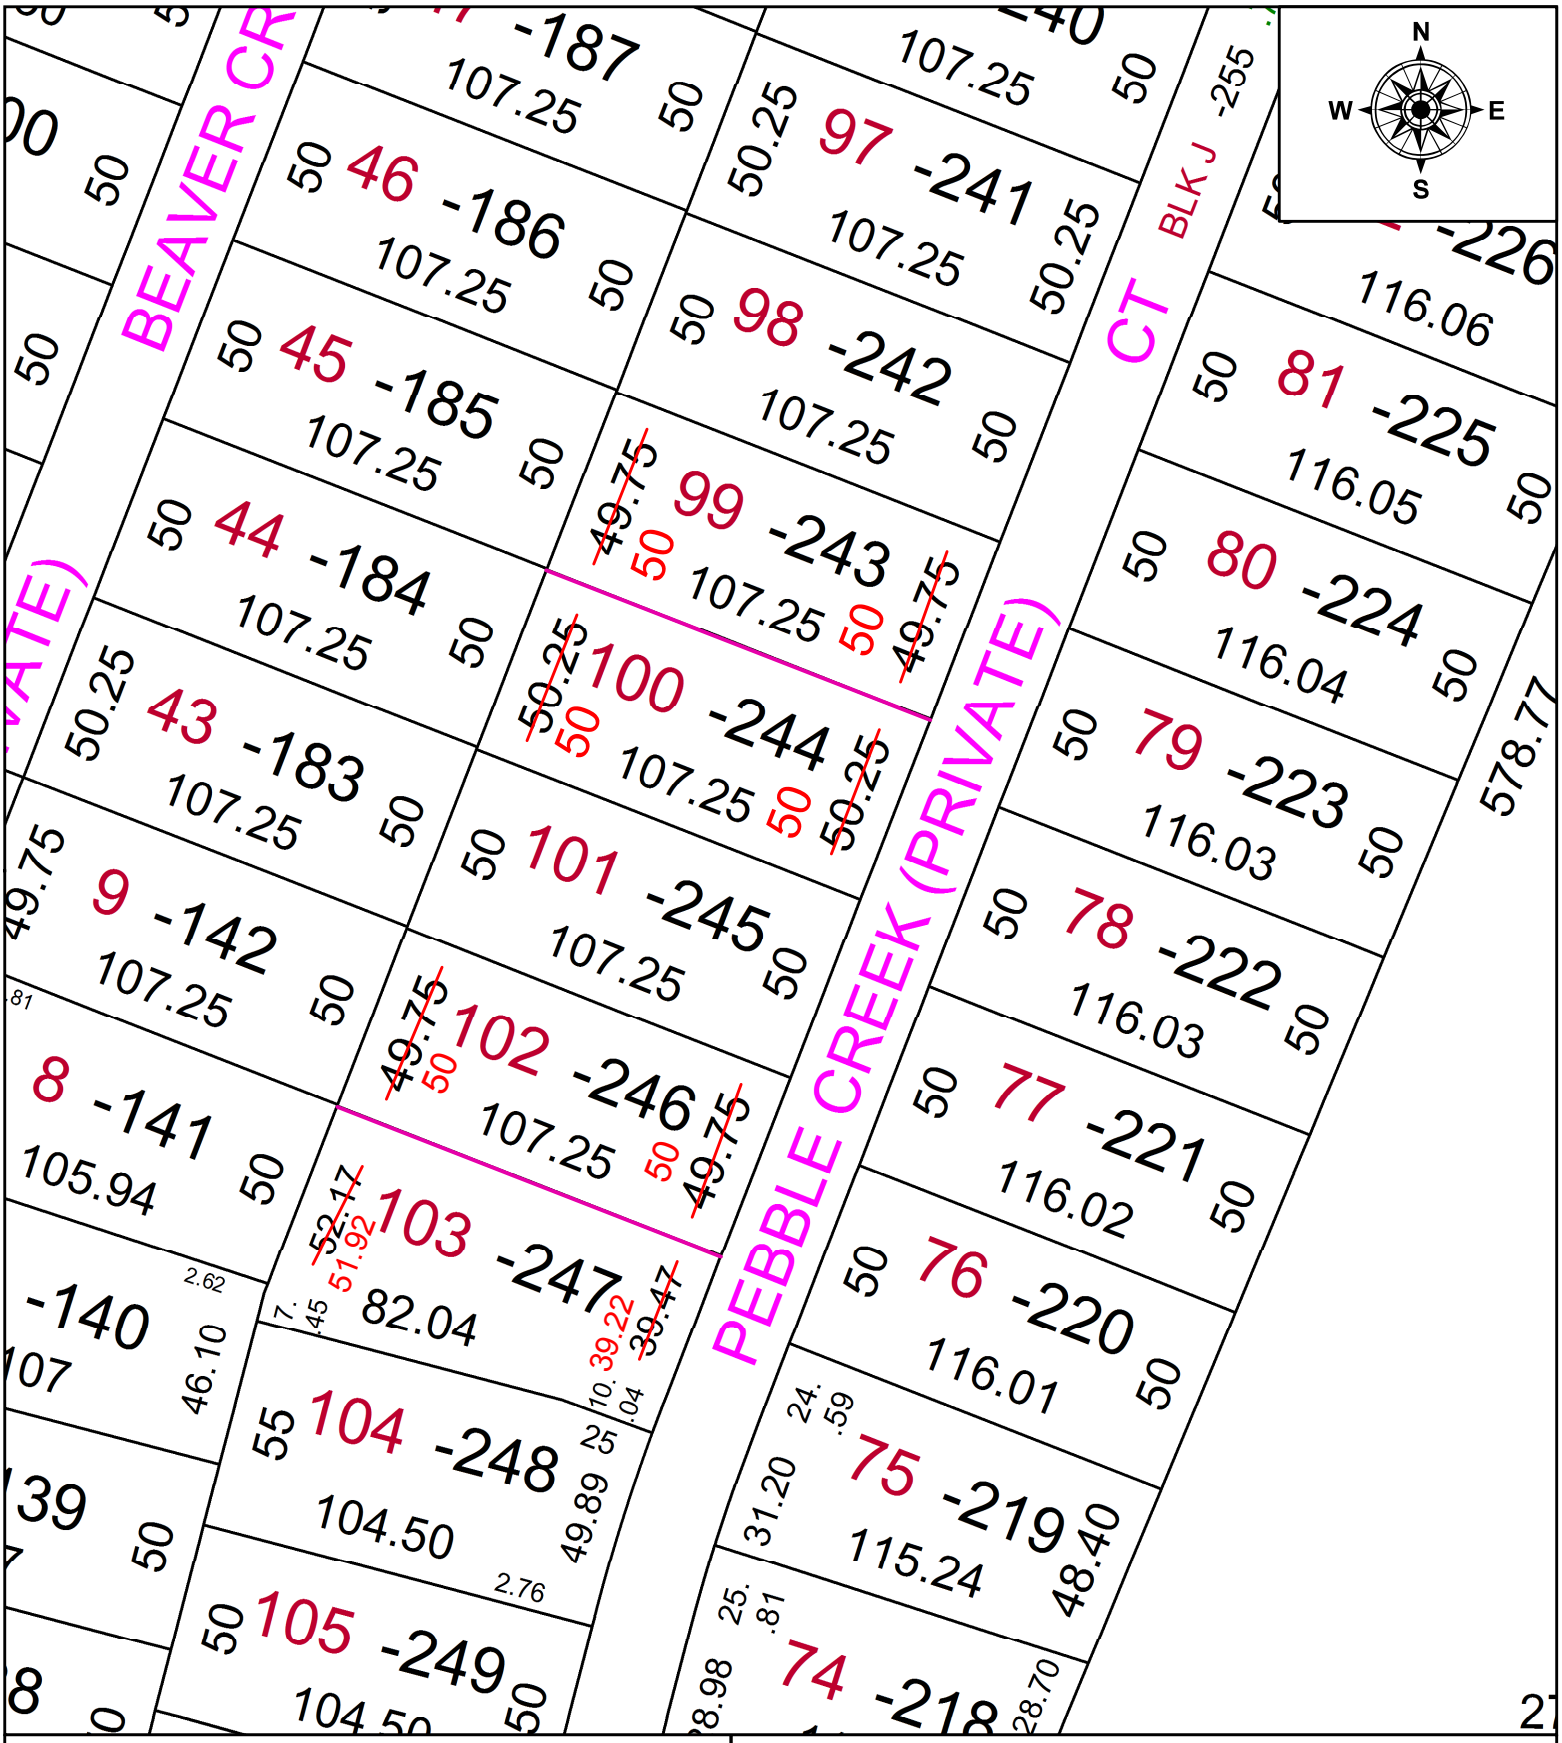

SPLITS/DEEDS PROCESSED

LORAIN COUNTY TAX MAP DEPARTMENT
226 MIDDLE AVE. ELYRIA, OH

SURVEYED BY: NA
CLOSURE: 1: 33,000
MAP PAGE(S): 03-00-101
APPOVED BY: TJS **DATE:** 9/29/2021
SCALE: 1" = 50' **PRIOR INSTRUMENT:** PV. 107 PG. 82