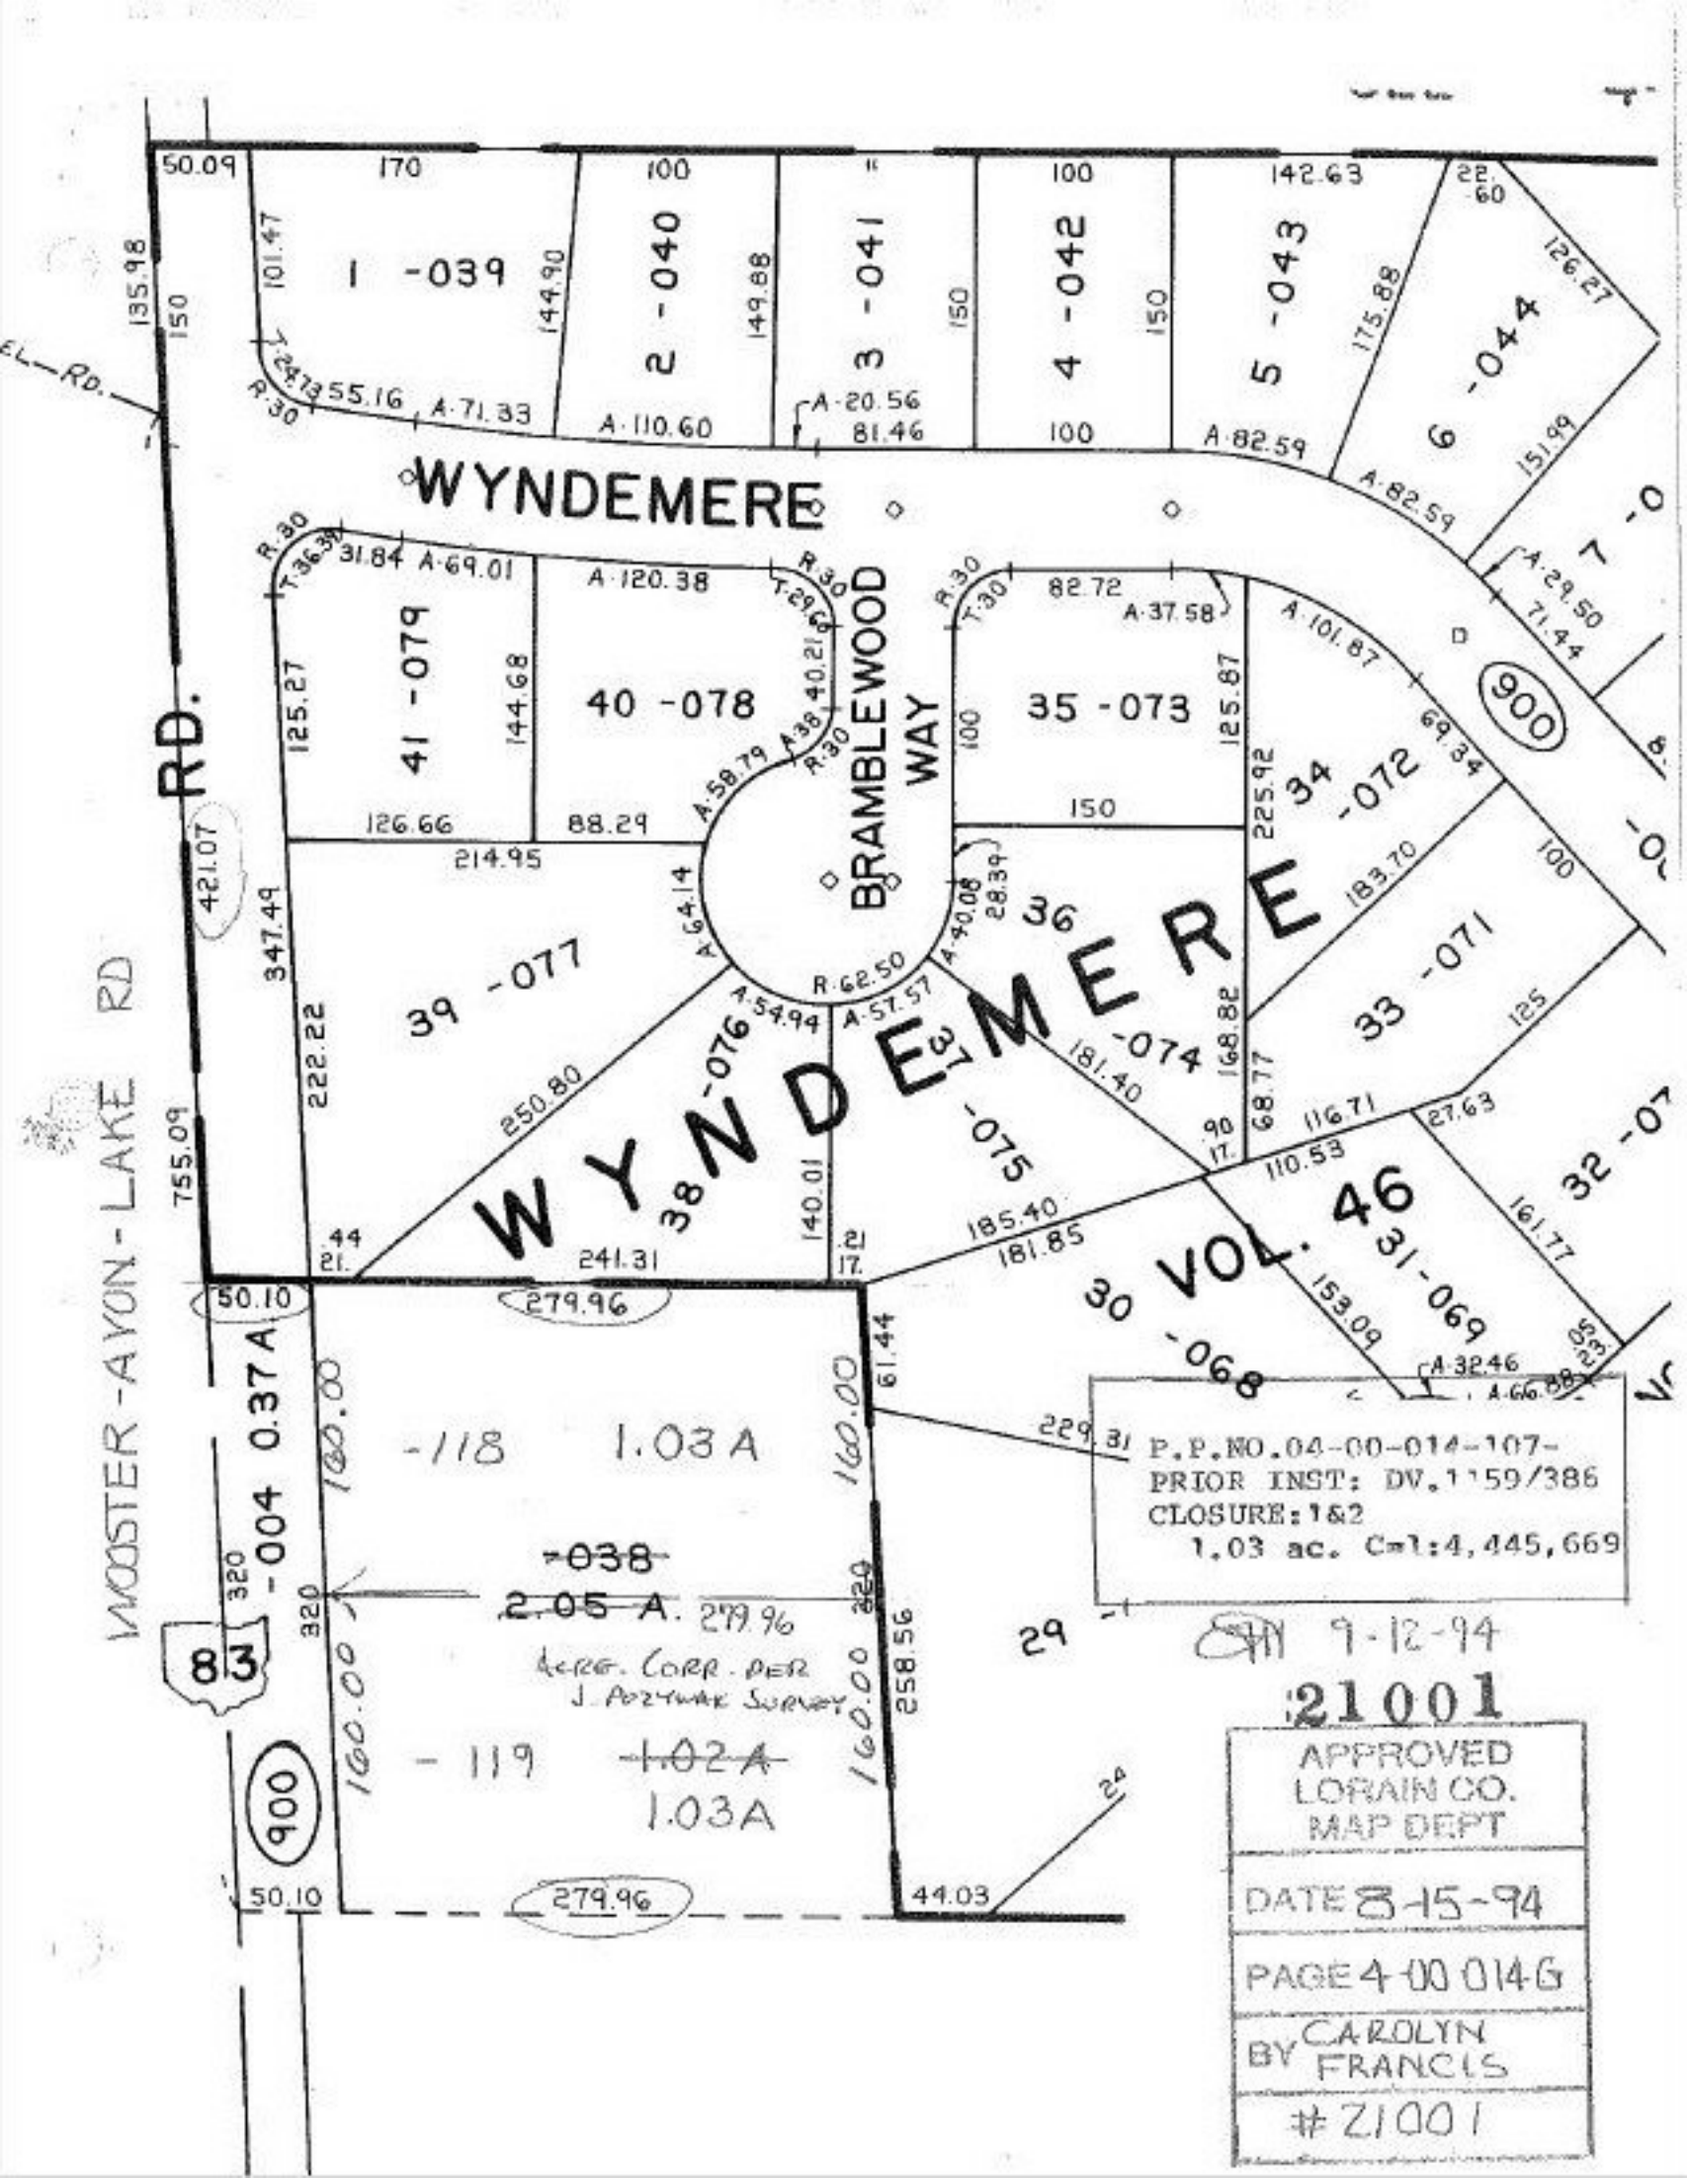
WYNDEMERE
BRAMBLEWOOD WAY
WYNDEMERE
RD.
WOOSTER-AVON-LAKE RD
1 -039
2 -040
3 -041
4 -042
5 -043
6 -044
7 -0
41 -079
40 -078
35 -073
34 -072
39 -077
38 -076
36 -074
33 -071
37 -075
32 -07
31 -069
30 -068
29
VOL. 46
900
-118 1.03A
-038
2.05 A. 279.96
-119 -102A
1.03A
-004 0.37A
P.P.NO.04-00-014-107-
PRIOR INST: DV.1159/386
CLOSURE:1&2
1.03 ac. Cml:4,445,669
9-12-94
21001
APPROVED
LORAIN CO.
MAP DEPT
DATE 8-15-94
PAGE 4-00 014-G
BY CAROLYN FRANCIS
#21001