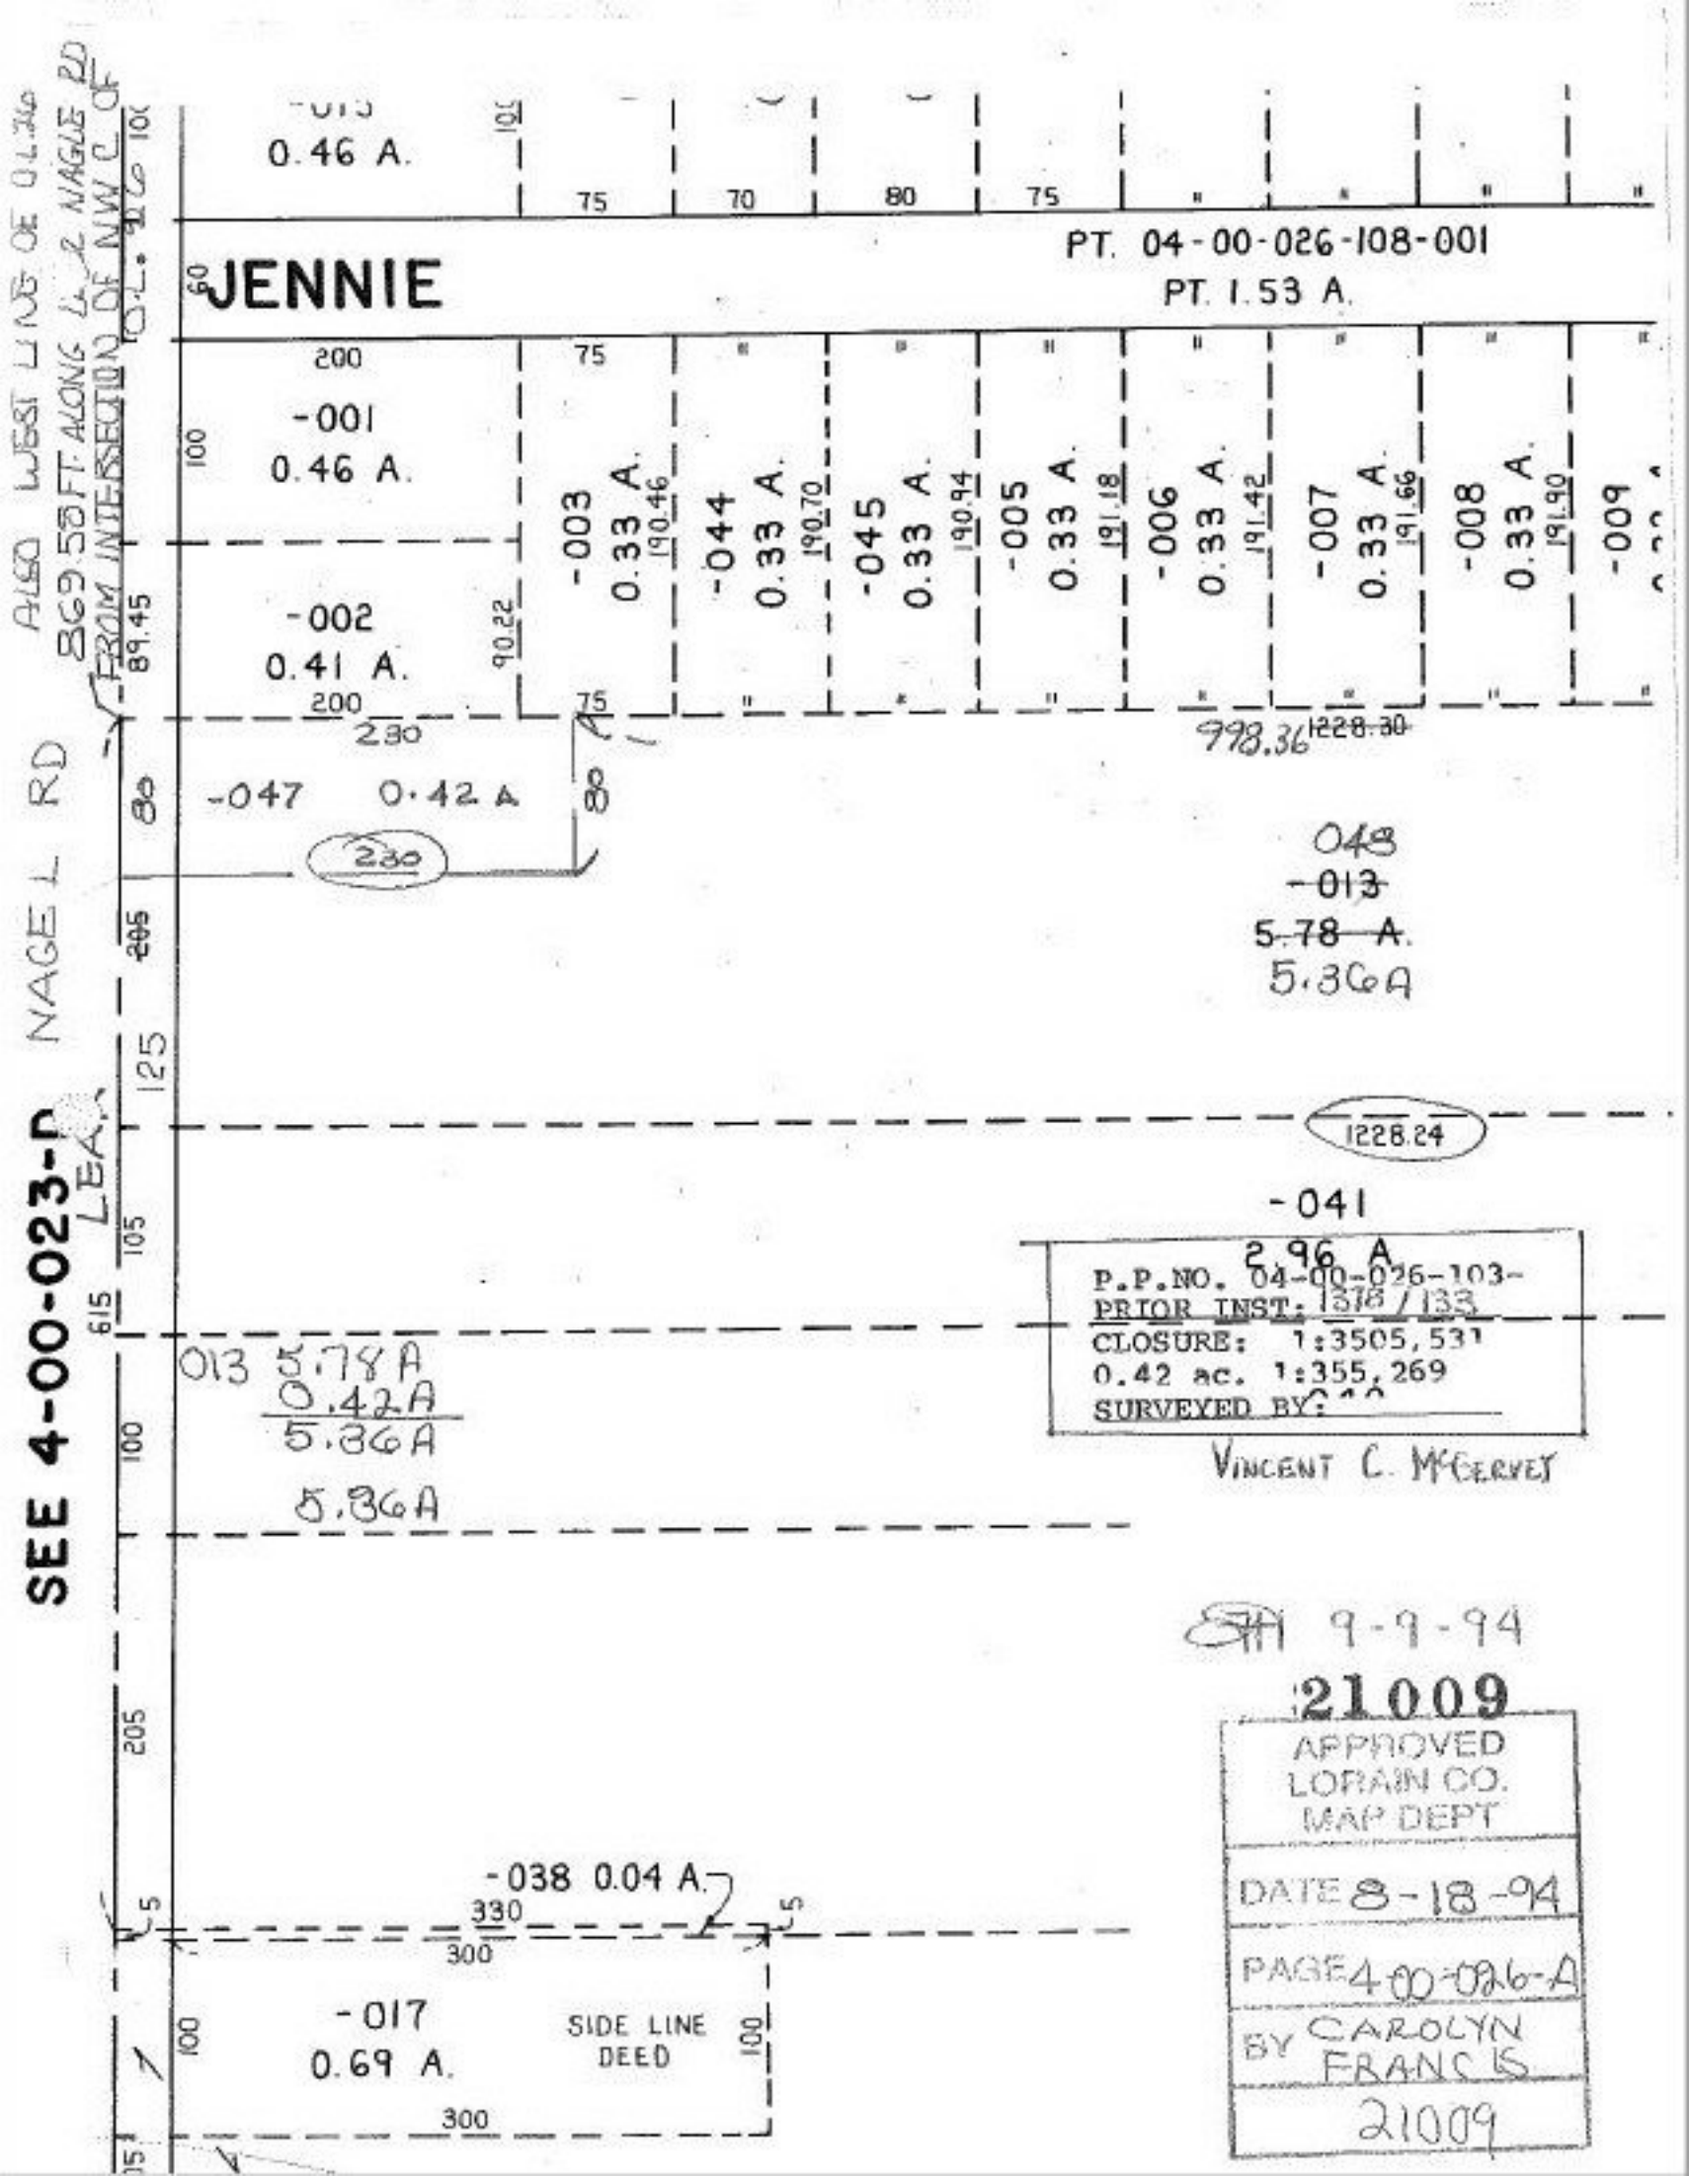
0.46 A.
PT. 04-00-026-108-001
PT. 1.53 A.
JENNIE
-001
0.46 A.
-002
0.41 A.
-003 0.33 A.
-044 0.33 A.
-045 0.33 A.
-005 0.33 A.
-006 0.33 A.
-007 0.33 A.
-008 0.33 A.
-009
-047 0.42 A
998.36
1228.30
1228.24
-041
2.96 A
P.P.NO. 04-00-026-103-
PRIOR INST: 1378 / 133
CLOSURE: 1:3505, 531
0.42 ac. 1:355, 269
SURVEYED BY:
VINCENT C. McGERVEY
-013
5.78 A.
5.36A
013 5.78A
0.42A
5.36A
5.36A
-038 0.04 A.
-017
0.69 A.
SIDE LINE DEED
SEE 4-00-023-D
NAGEL RD
ALSO WEST LINE OF 0.42ac
869.58 FT. ALONG LINE 2 NAGEL RD
FROM INTERSECTION OF N.W.C. OF
9-9-94
21009
APPROVED
LORAIN CO.
MAP DEPT
DATE 8-18-94
PAGE 4-00-026-A
BY CAROLYN FRANCIS
21009