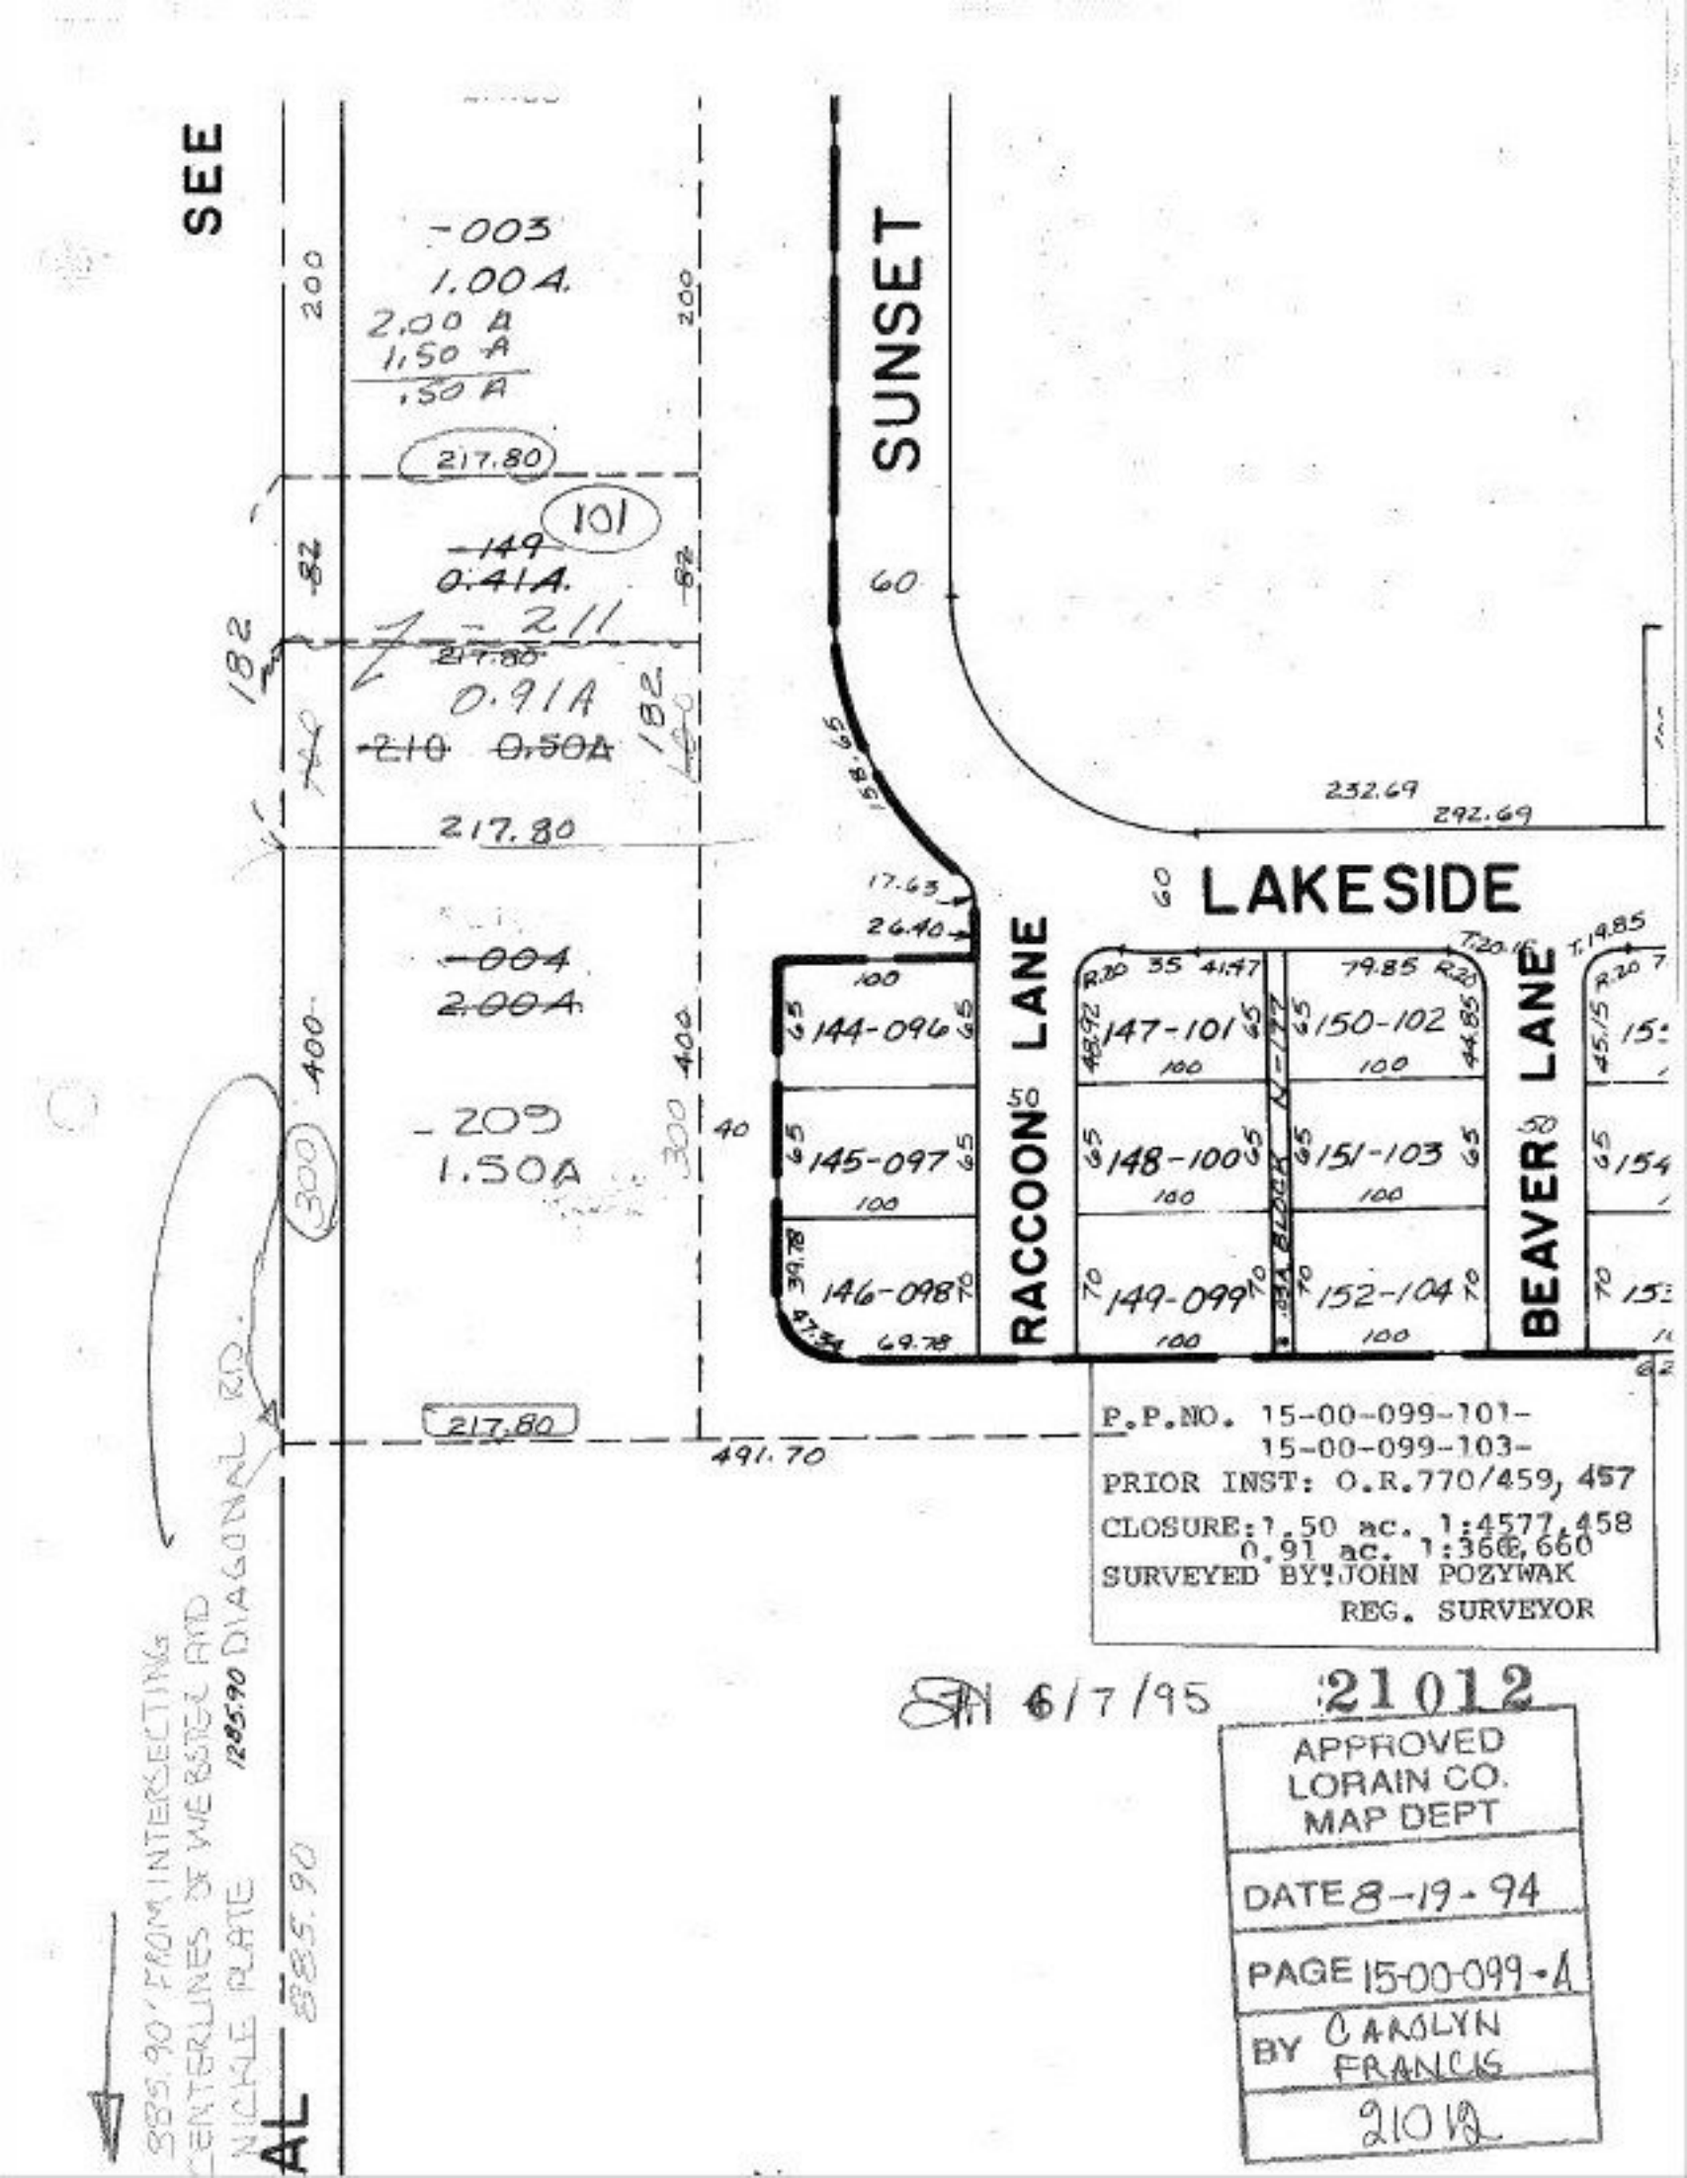

P.P.NO. 15-00-099-101-
15-00-099-103-
PRIOR INST: O.R.770/459, 457
CLOSURE: 1.50 ac. 1:4577.458
0.91 ac. 1:3666.660
SURVEYED BY: JOHN POZYWAK
REG. SURVEYOR

6/7/95

21012

APPROVED
LORAIN CO.
MAP DEPT

DATE 8-19-94

PAGE 15-00-099-A

BY CAROLYN FRANCIS

21012