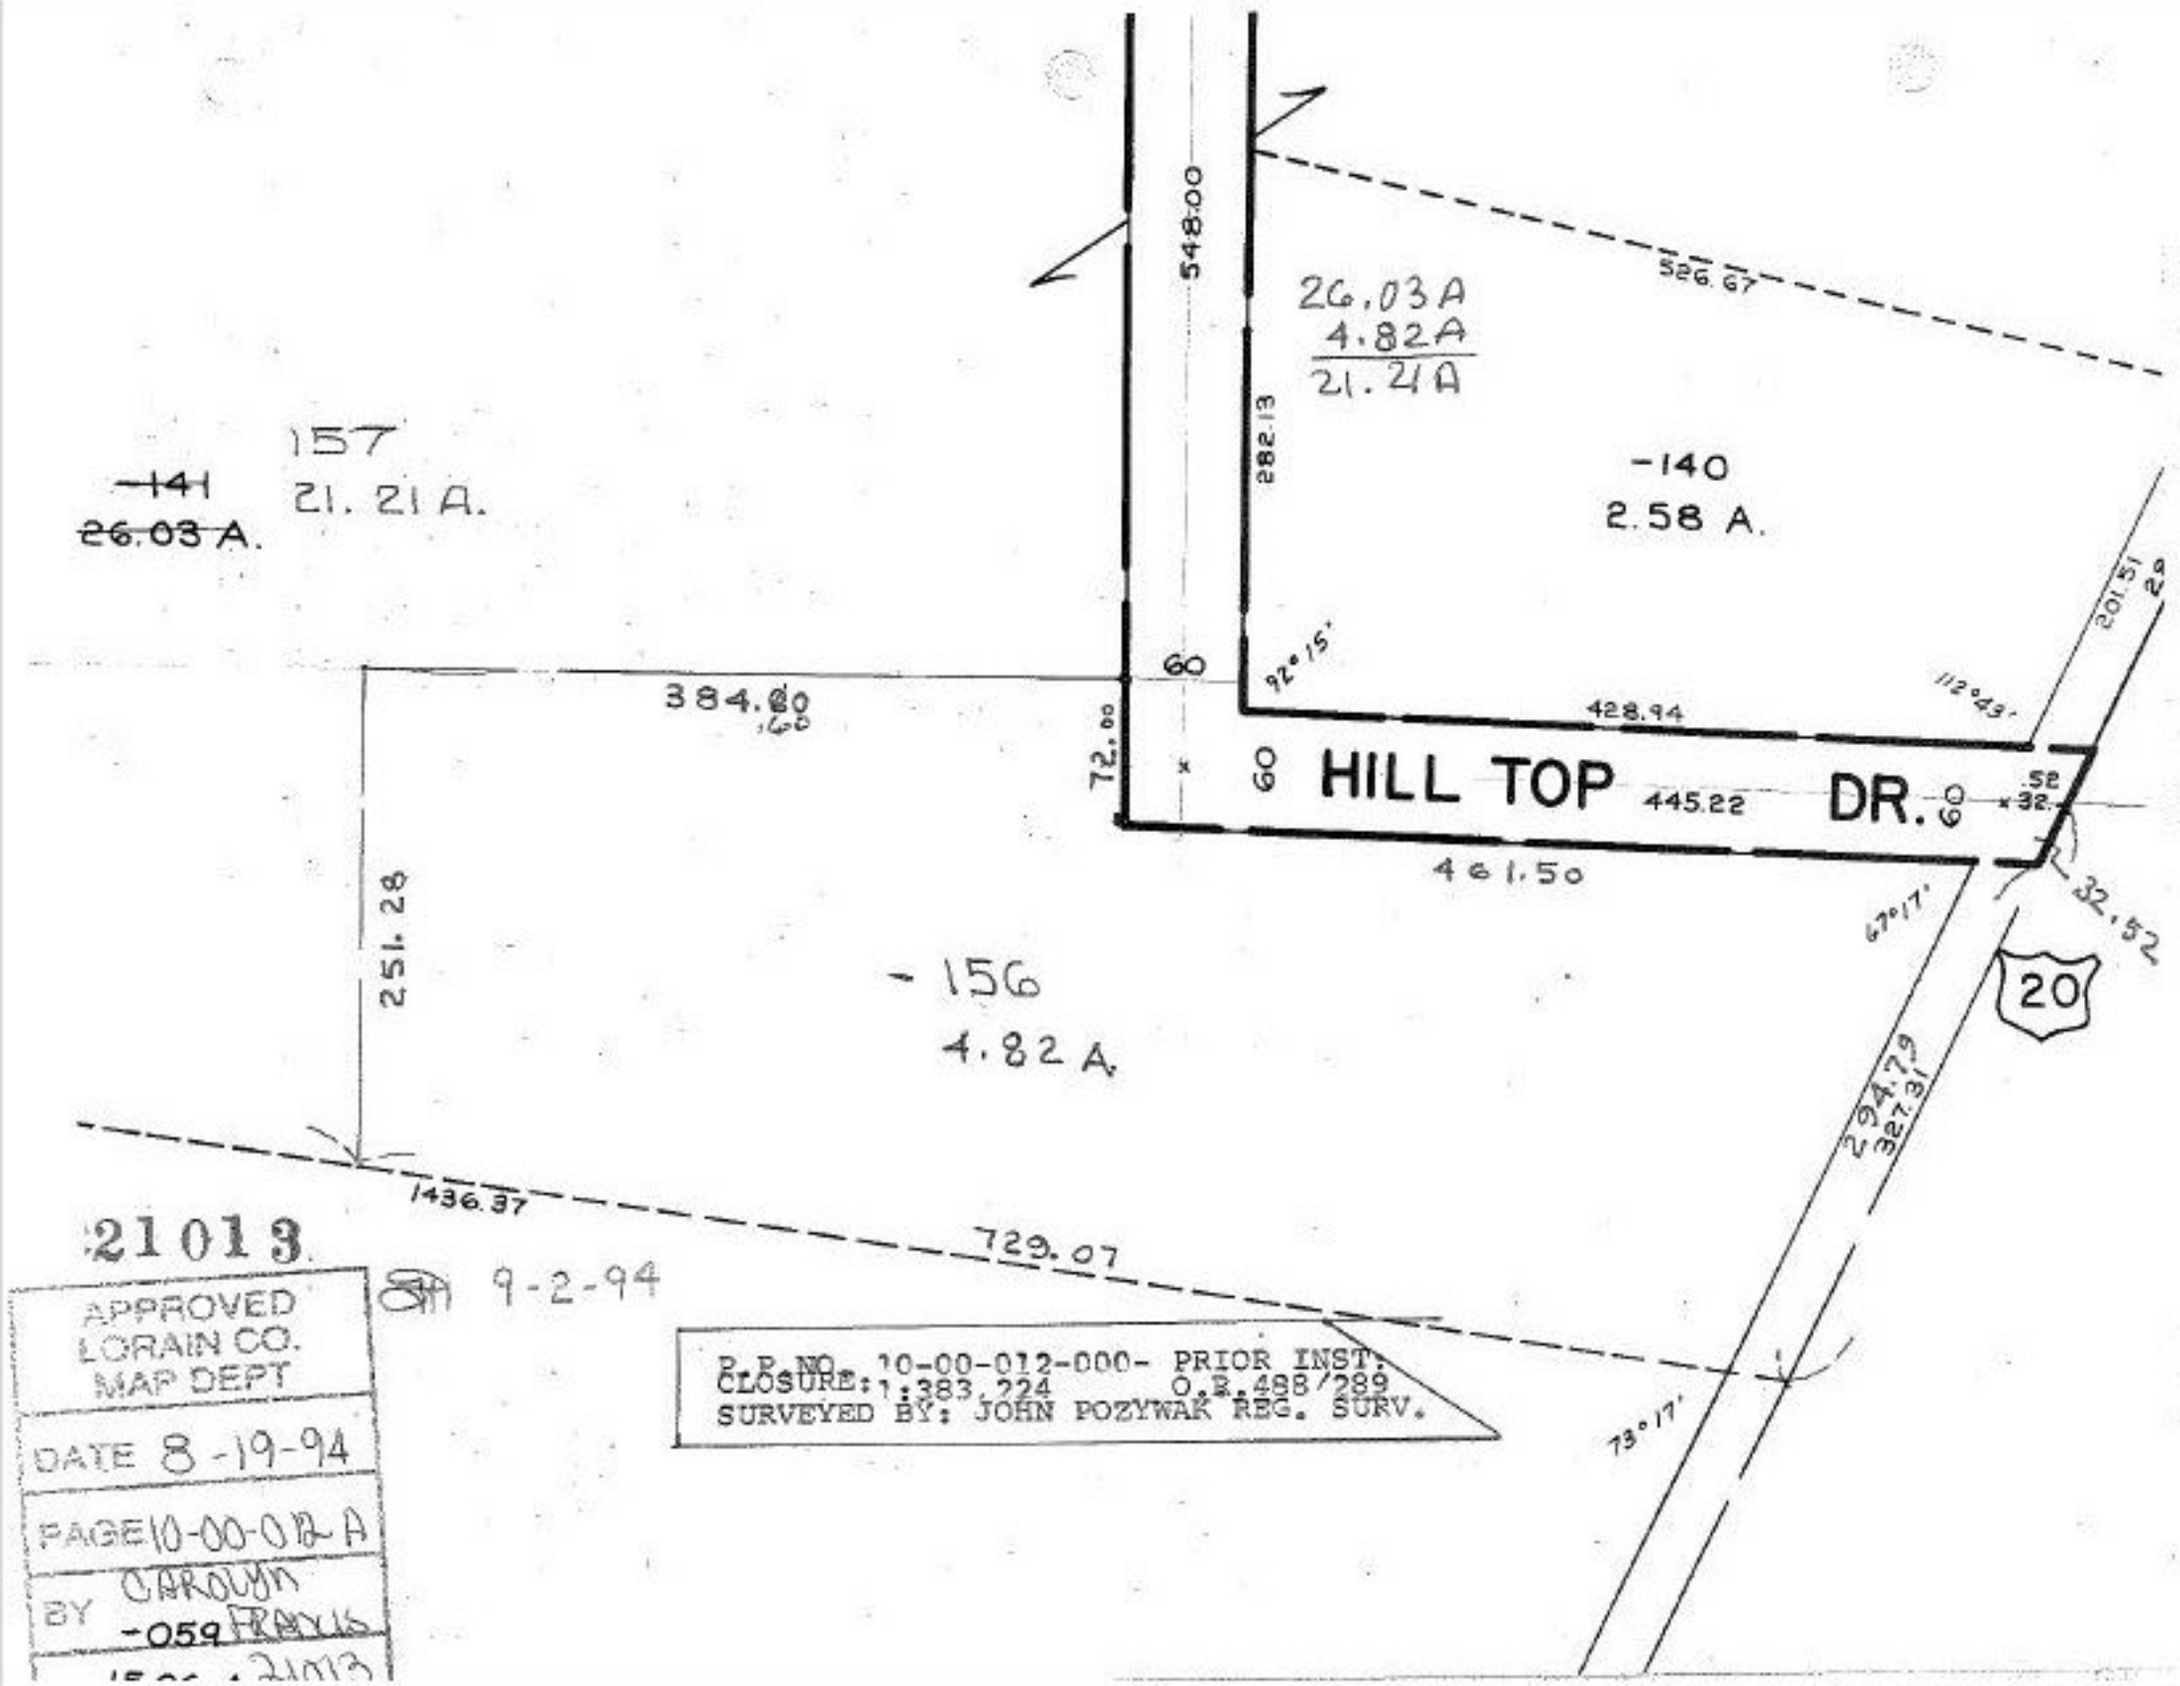

21013

9-2-94

APPROVED
LORAIN CO.
MAP DEPT

DATE 8-19-94

PAGE 10-00-012-A

BY CAROLYN FRANKLIN

-059

21013

P.P.NO. 10-00-012-000- PRIOR INST.
CLOSURE: 1:383,224 O.R. 488/289
SURVEYED BY: JOHN POZYWAK REG. SURV.