21020

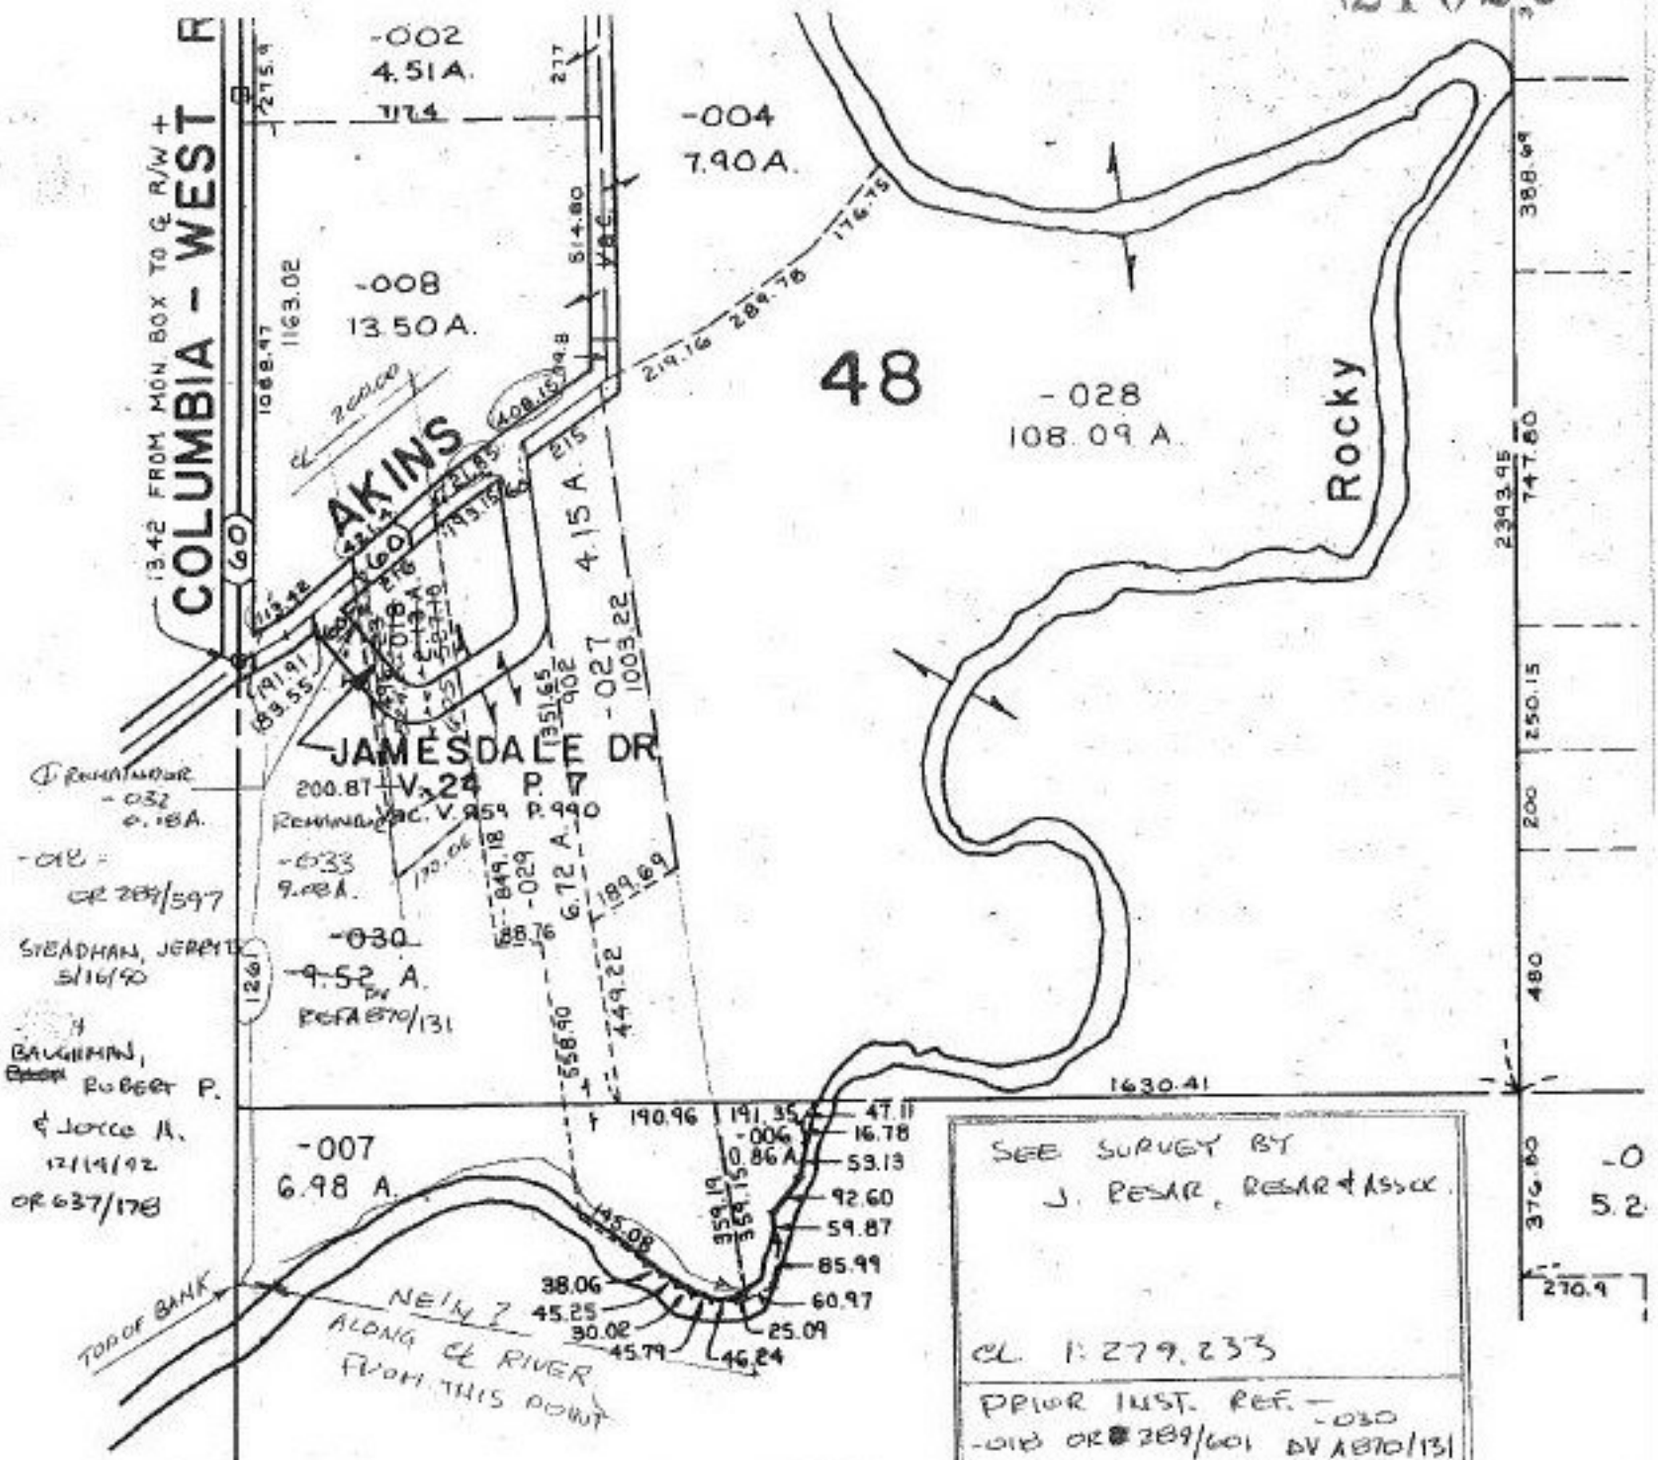

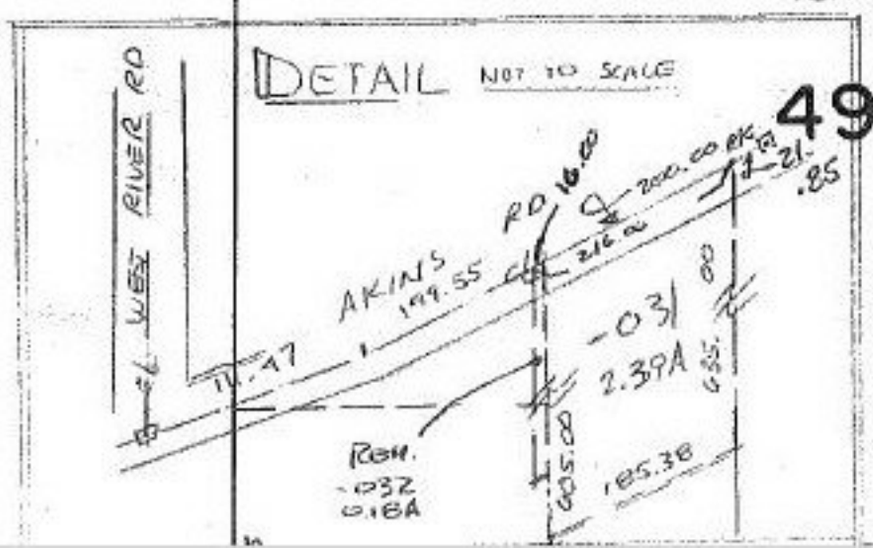

#21020

APPROVED
LORAIN CO.
MAP DEPT.
DATE 9-9-94
PAGE 12-G
BY T. McClain
VOID AFTER 21020