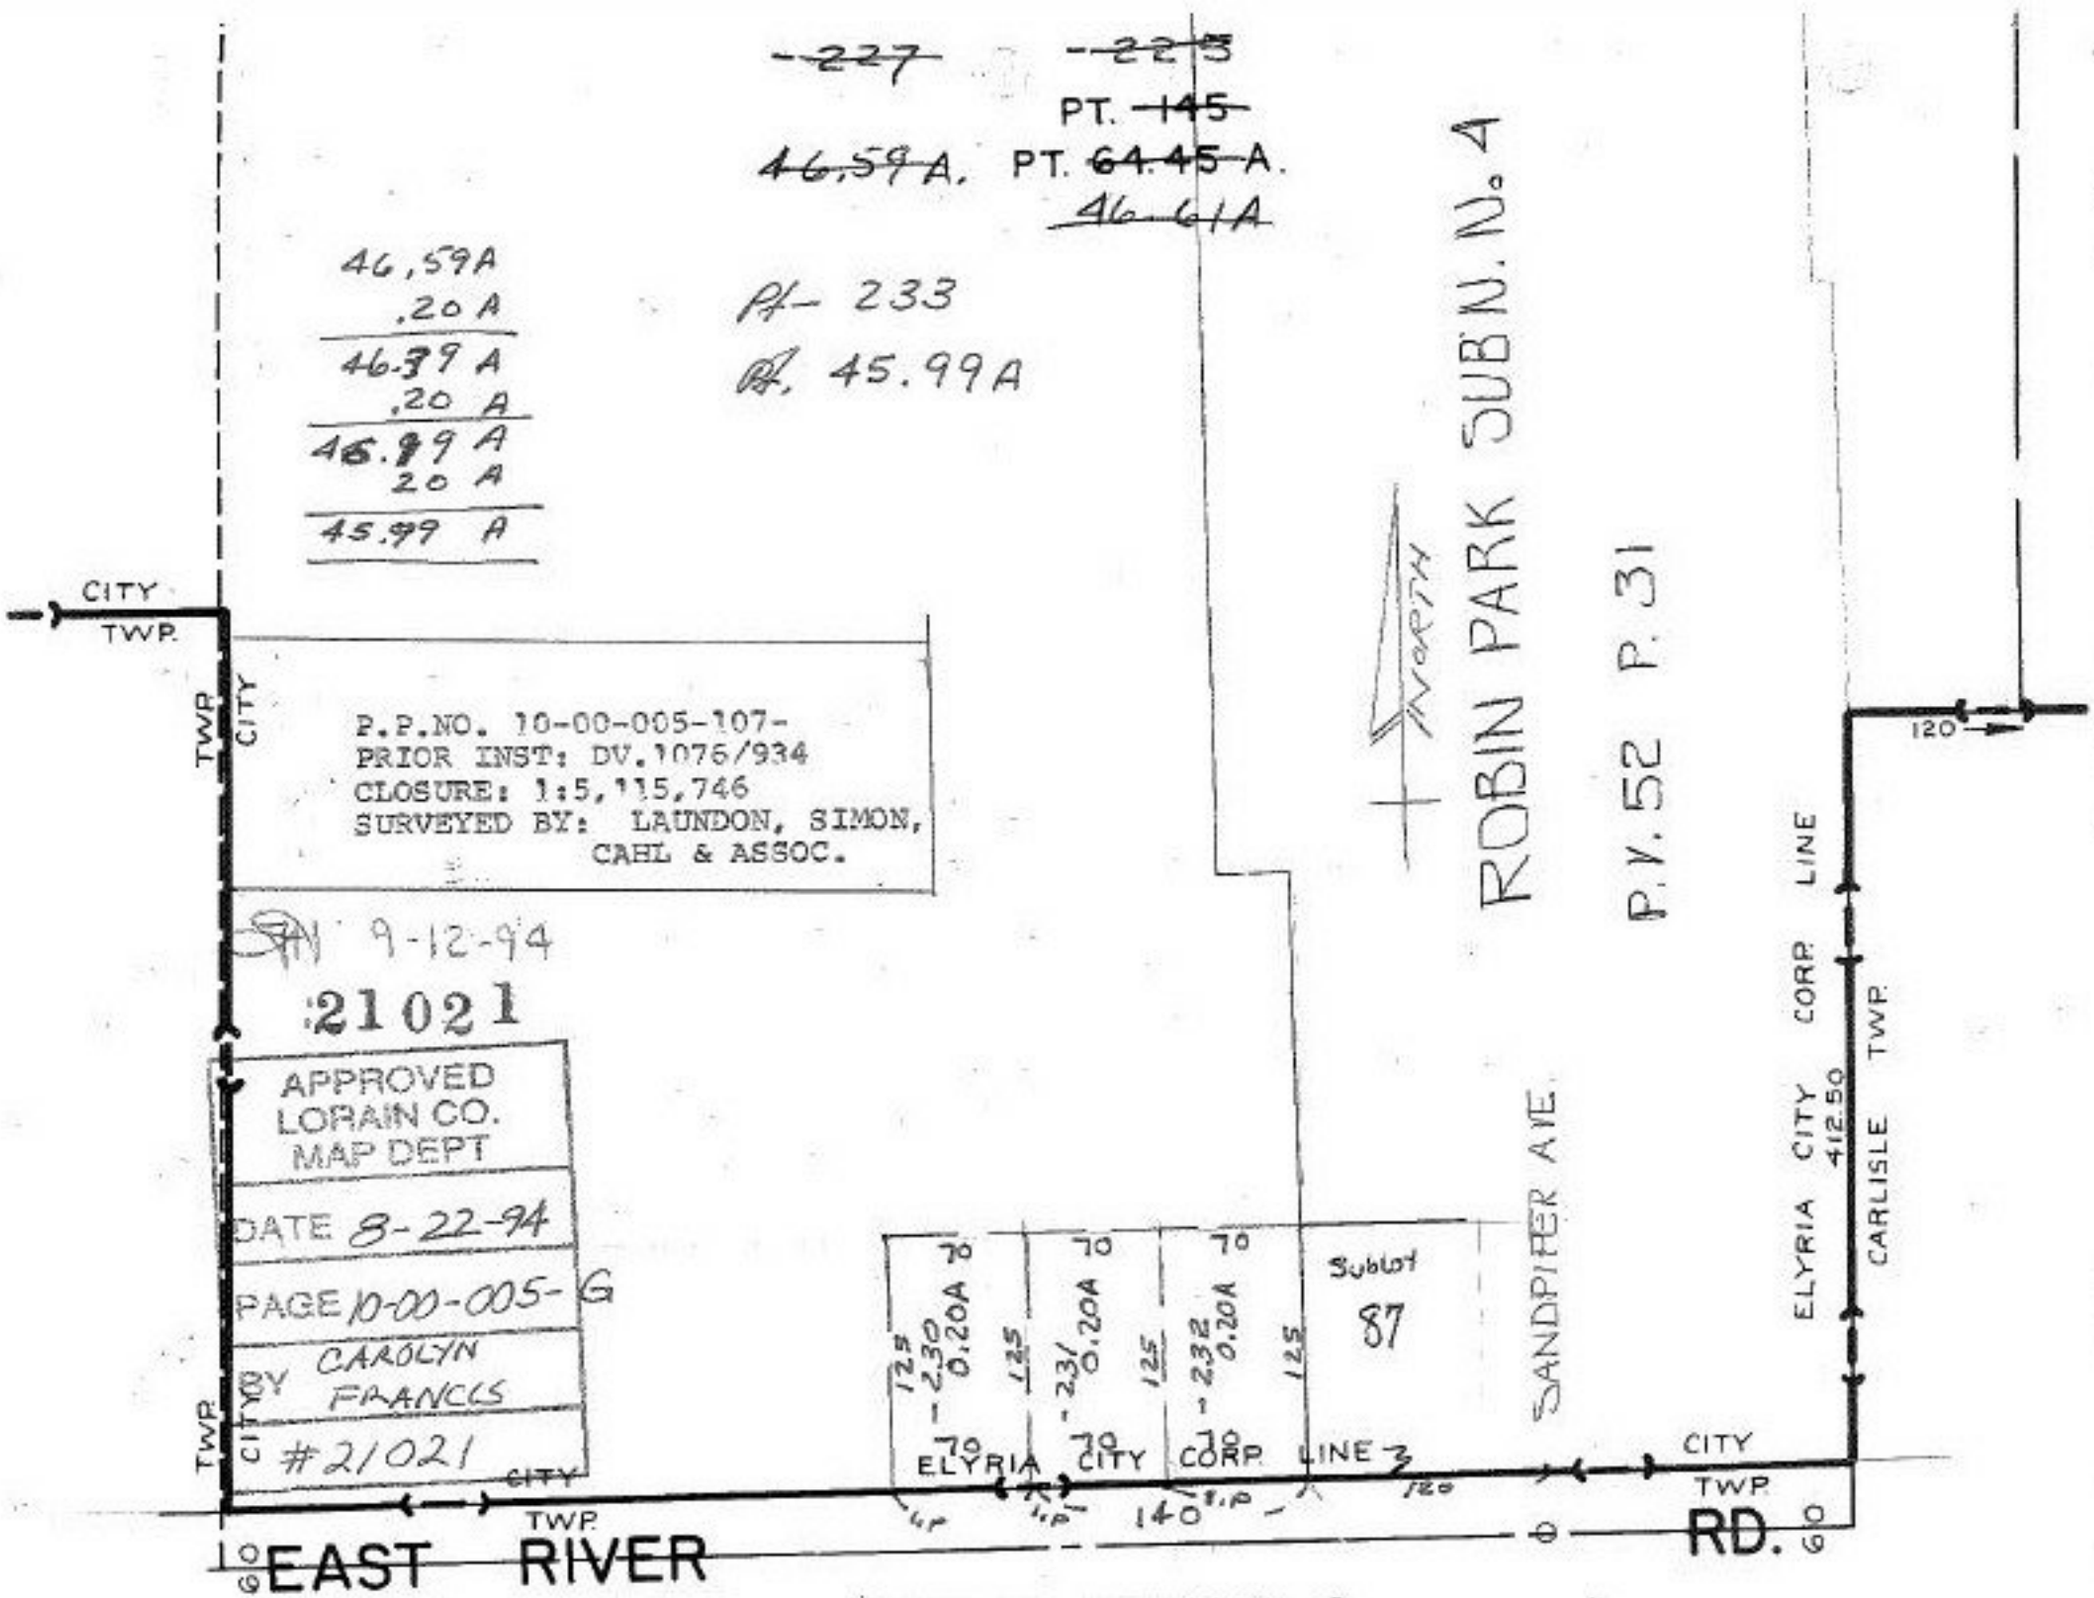

~~227~~
~~225~~
PT. ~~145~~
~~46.59~~ A.
PT. ~~64.45~~ A.
~~46.61A~~
46,59A
.20 A
46.39 A
.20 A
46.99 A
20 A
45.99 A
Pt- 233
Pt. 45.99A
NORTH
ROBIN PARK SUB'N. No. 4
P.V. 52 P. 31
CITY
TWP.
TWP
CITY
P.P.NO. 10-00-005-107-
PRIOR INST: DV.1076/934
CLOSURE: 1:5,115,746
SURVEYED BY: LAUNDON, SIMON,
CAHL & ASSOC.
9-12-94
21021
APPROVED
LORAIN CO.
MAP DEPT
DATE 8-22-94
PAGE 10-00-005-G
BY CAROLYN FRANCIS
#21021
120
ELYRIA CITY CORP. LINE
412.50
CARLISLE TWP.
SANDPIPER AVE.
70
125
230
0.20A
231
232
Sublot
87
ELYRIA CITY CORP. LINE
140
120
CITY
TWP.
EAST RIVER
RD.
60
SEE 10-00-006-C