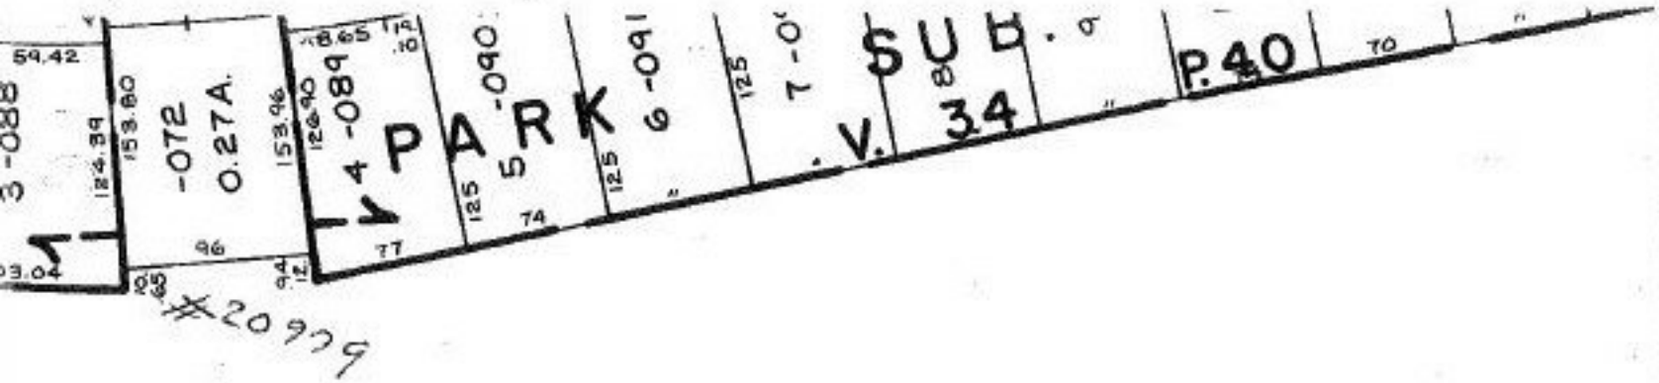

#20929

~~227~~
~~225~~
Pt. ~~145~~ - 233
Pt. ~~64.45A.~~ 45.99 A.
~~46.64A~~
~~46.63A~~
~~46.61~~
~~46.59A~~

P.P.NO. 10-00-005-107-
PRIOR INST: DV. 1076/934

SW 9-12-94
21021
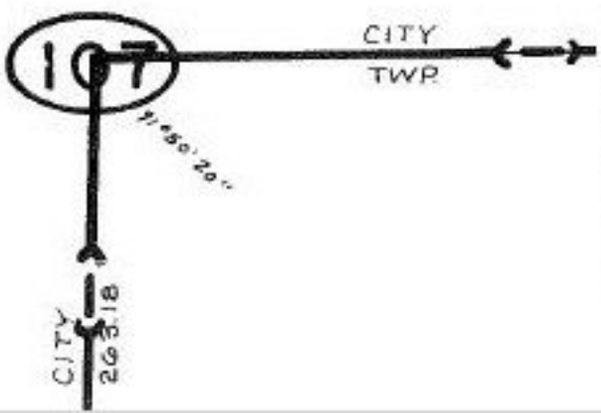
APPROVED
LORAIN CO.
MAP DEPT
DATE 8-22-94
PAGE 10-00-005H
BY CAROLYN FRANCIS
21021