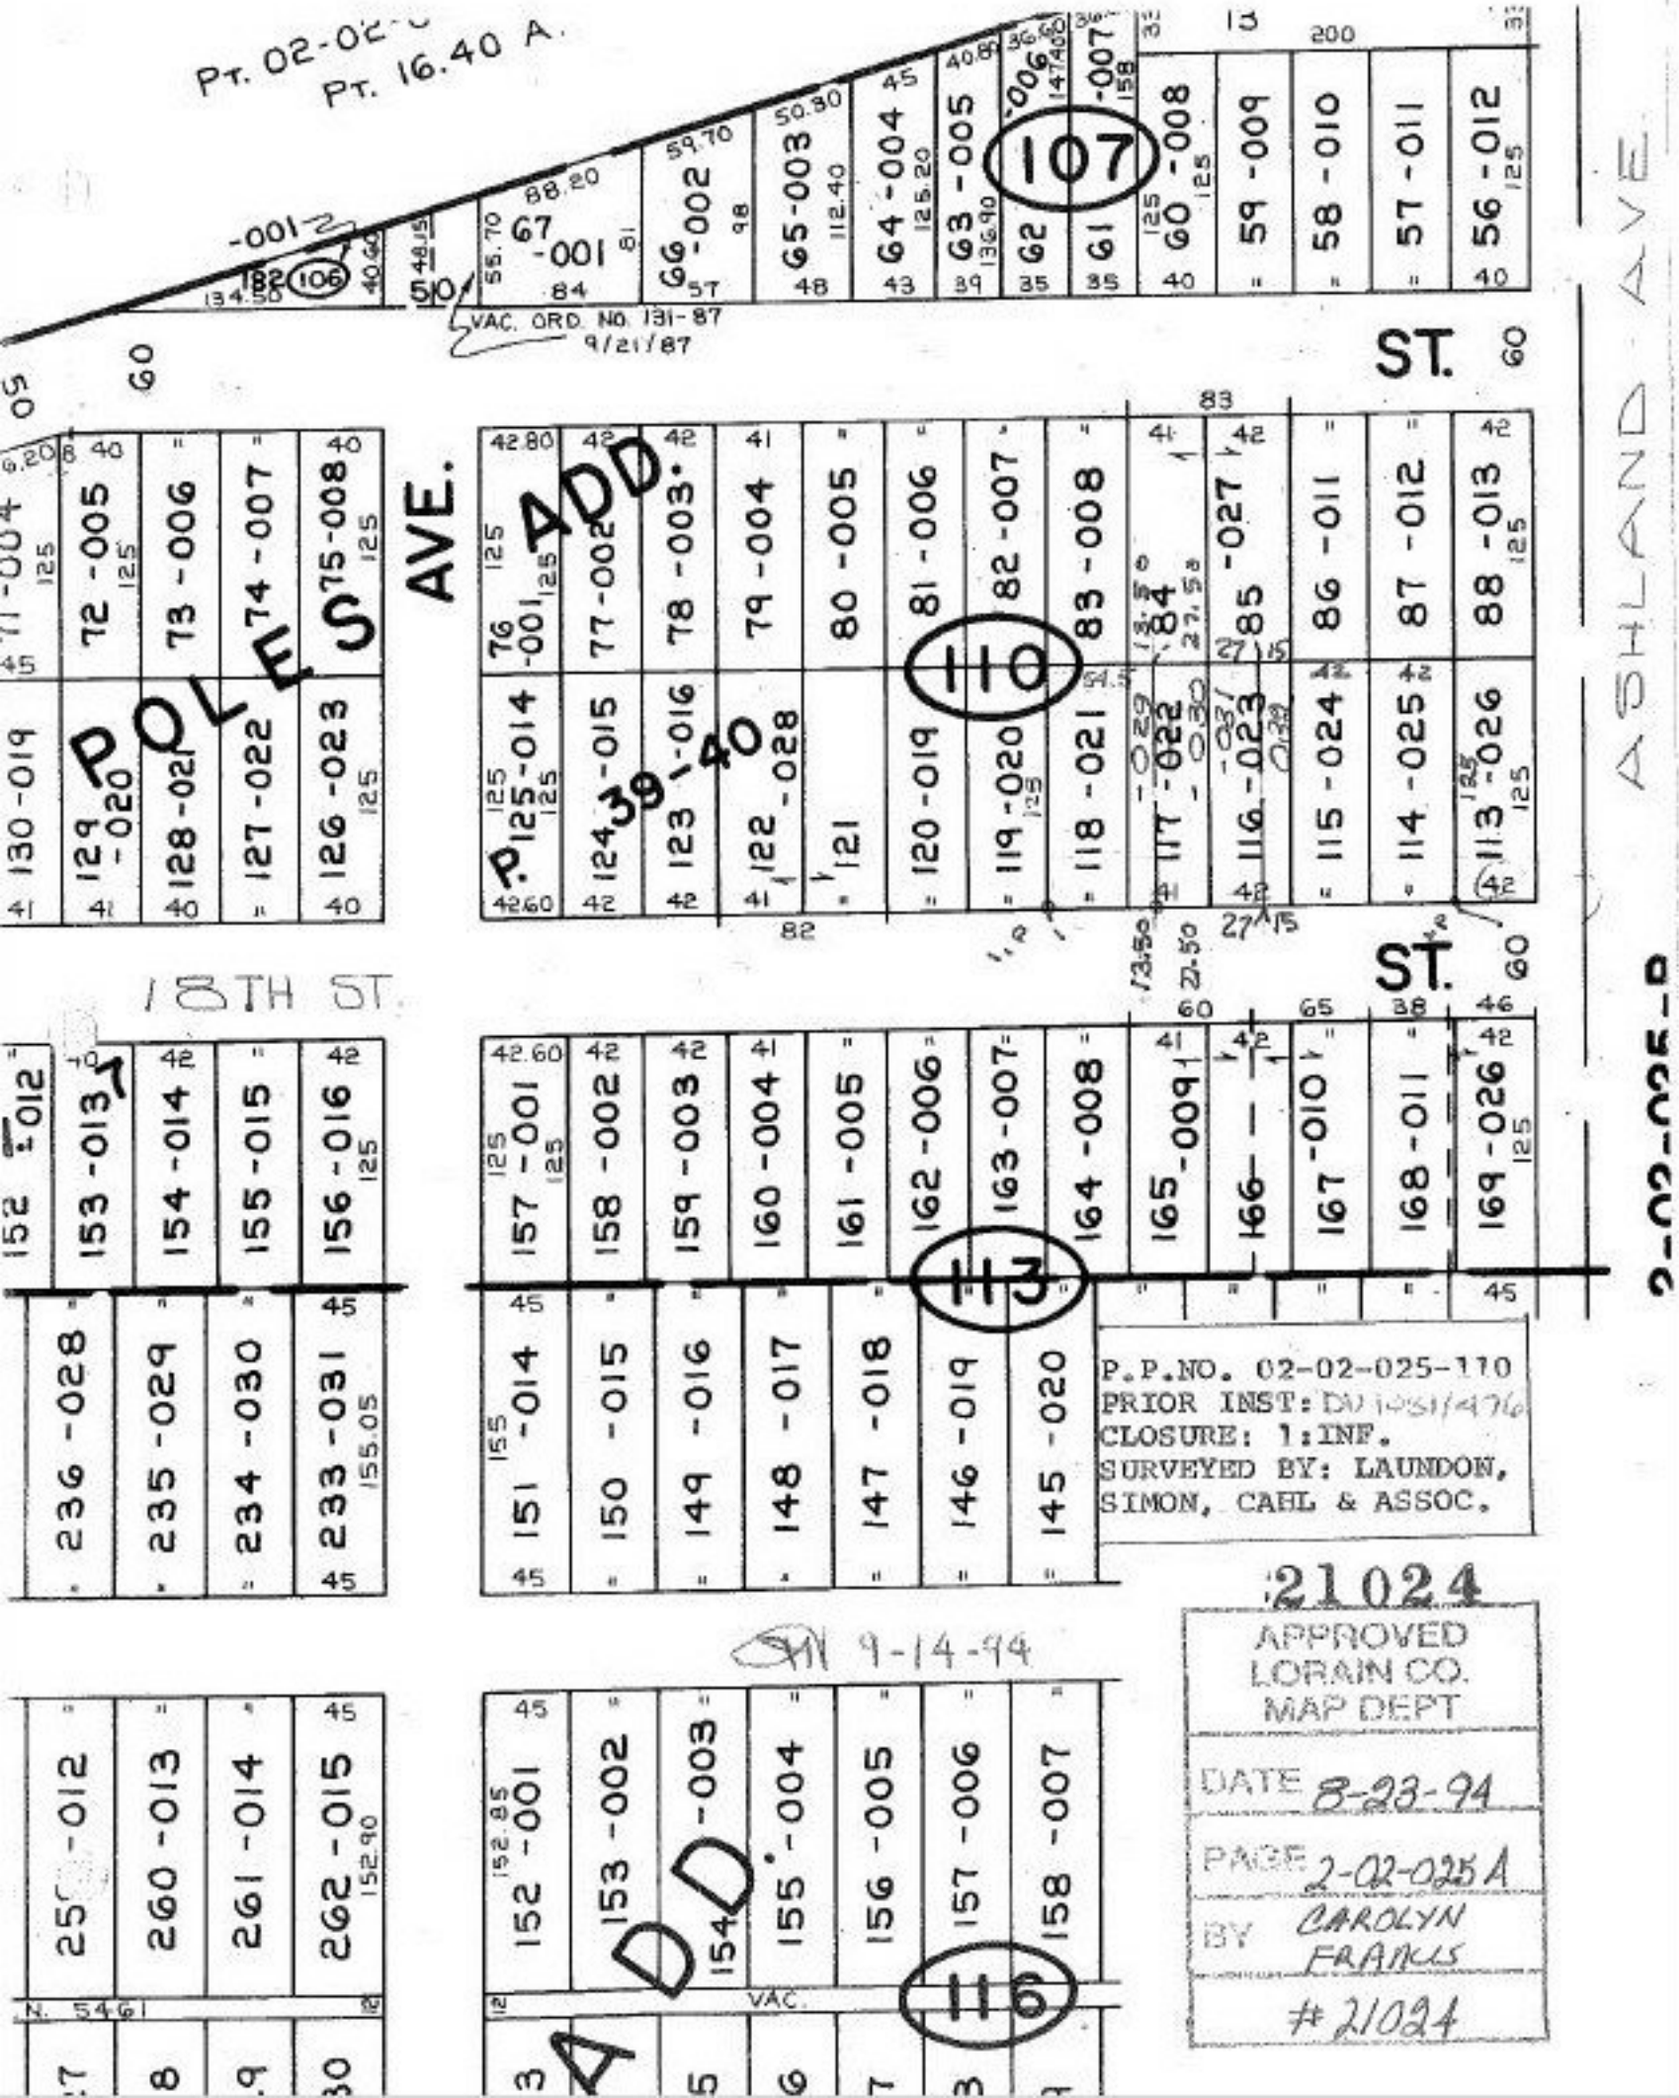

P.P.NO. 02-02-025-110
PRIOR INST: DV 1051/476
CLOSURE: 1:INF.
SURVEYED BY: LAUNDON, SIMON, CAHL & ASSOC.

21024

APPROVED
LORAIN CO.
MAP DEPT

DATE 8-23-94

PAGE 2-02-025 A

BY CAROLYN FRANCIS

#21024

9-14-94