21025

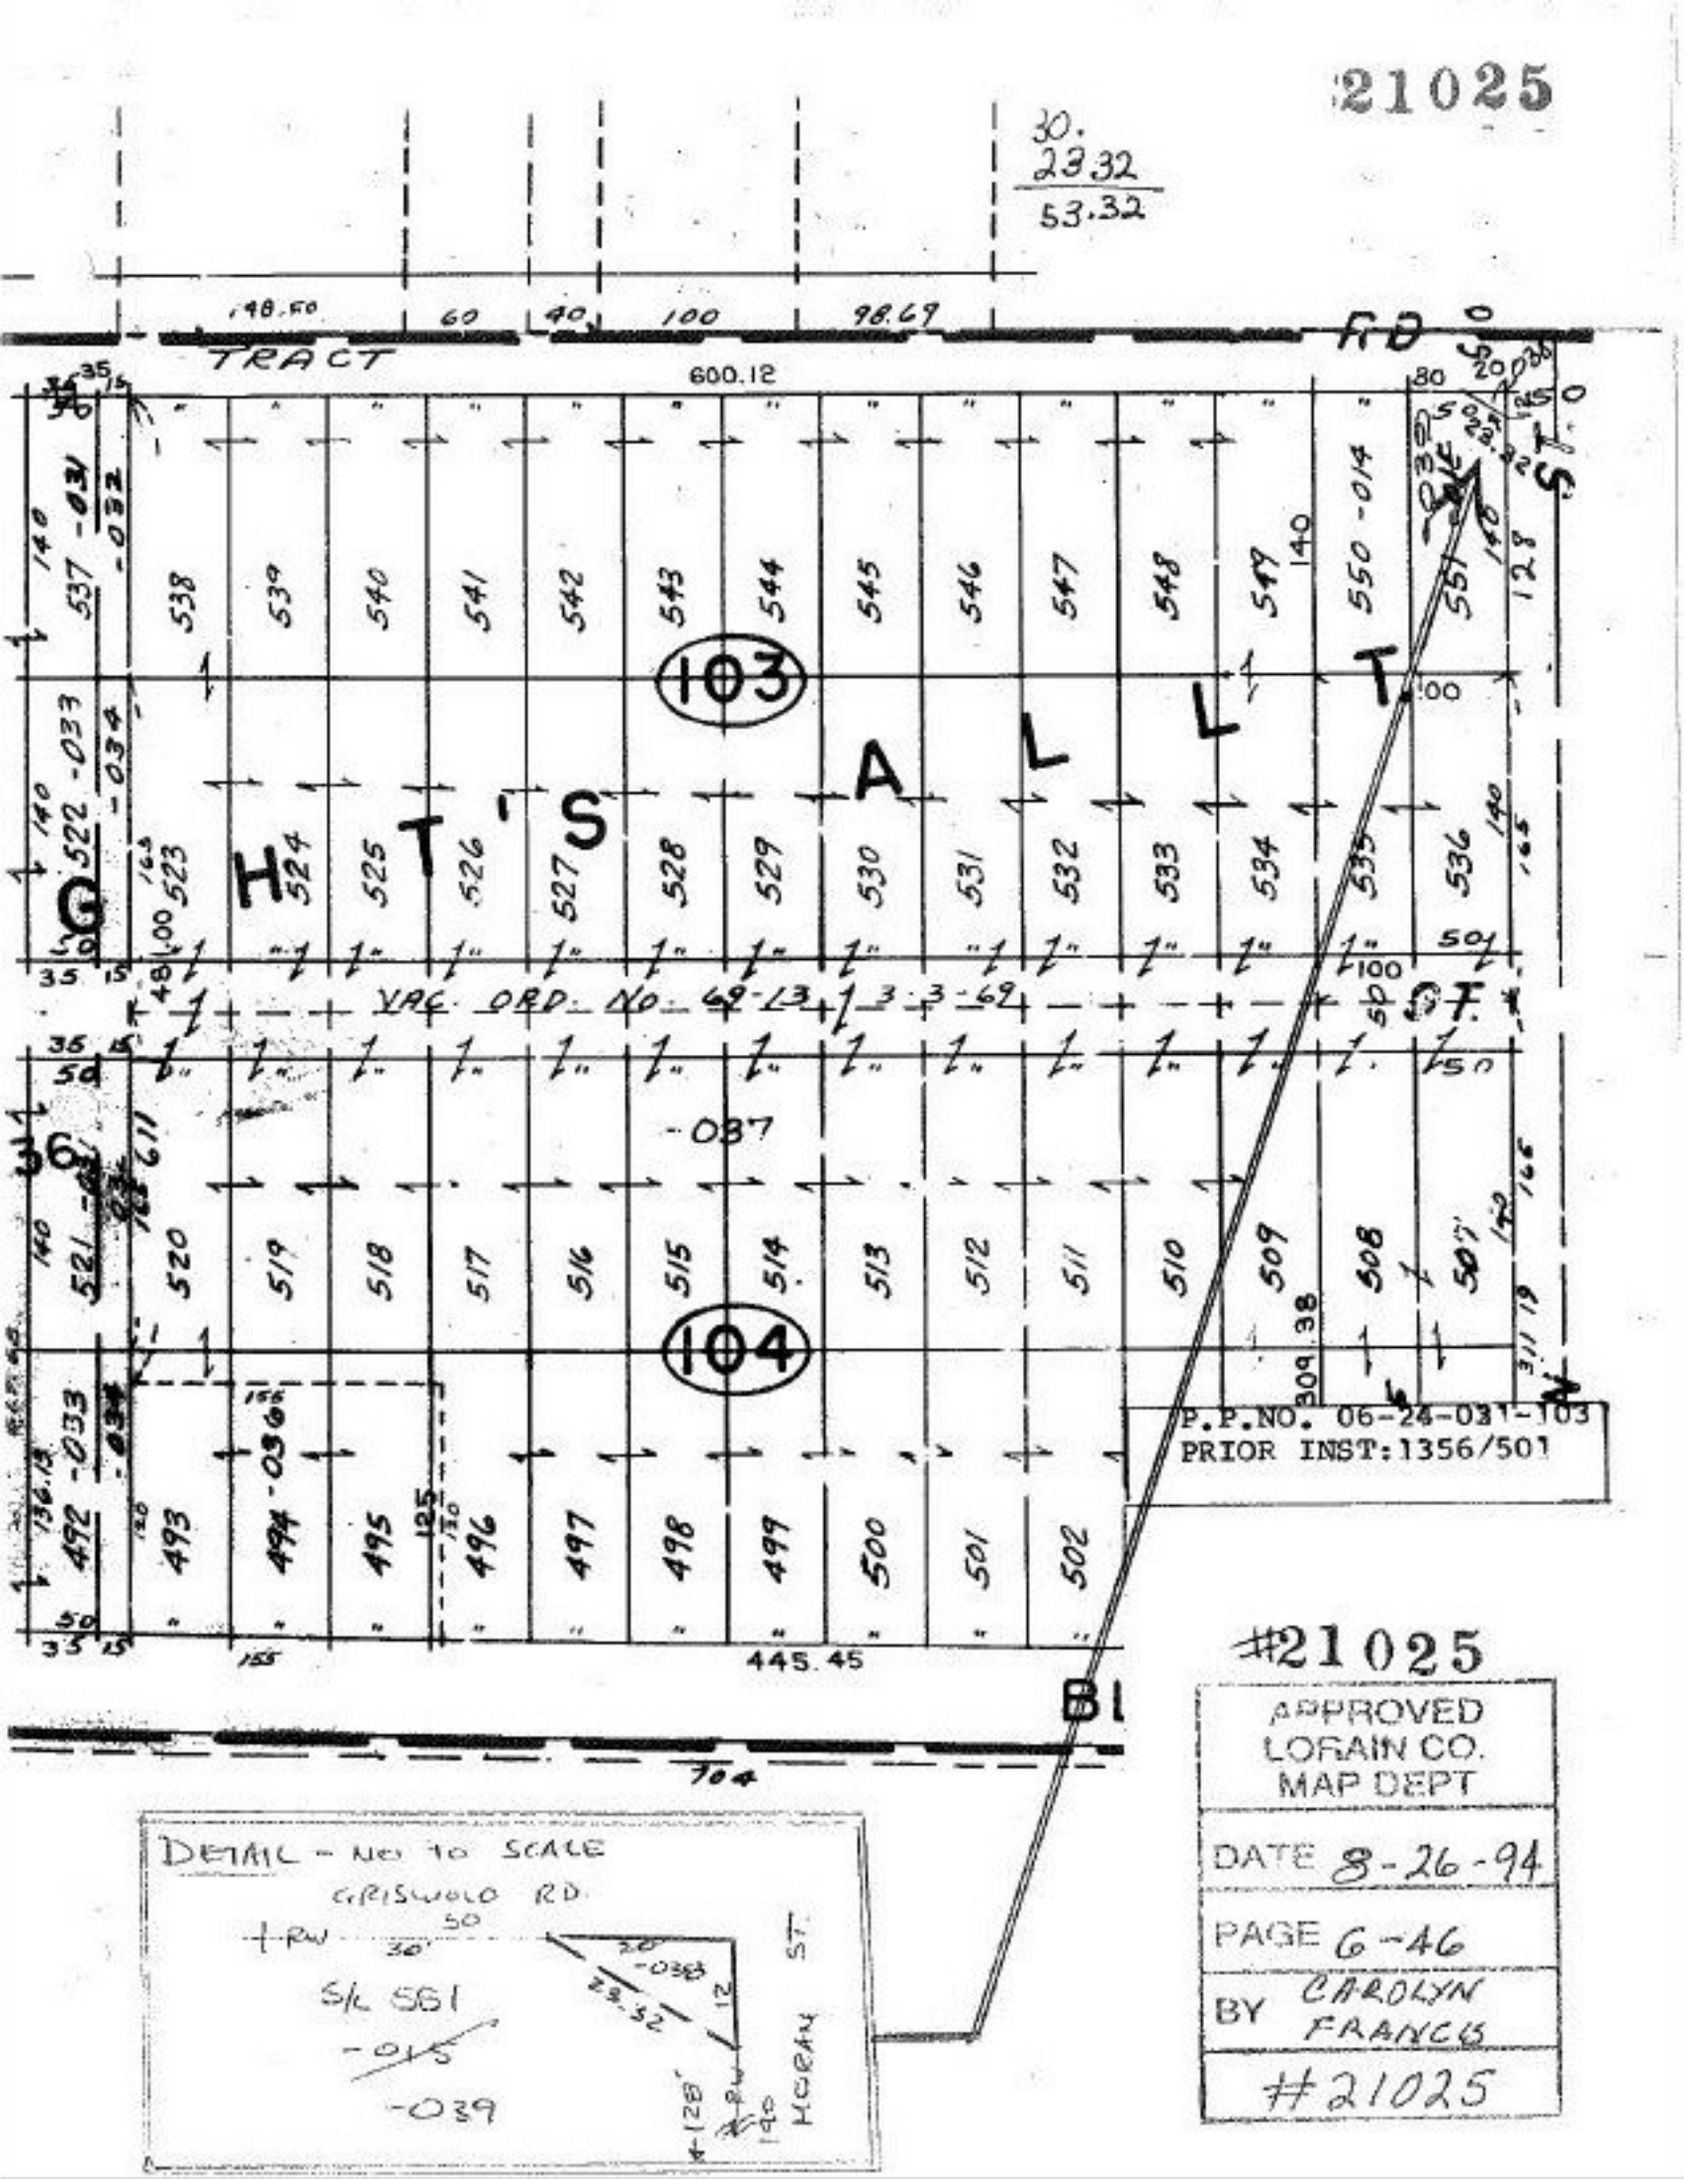
30.
23.32
53.32
198.50
60
40
100
98.69
TRACT
600.12
103
104
VAC. ORD. NO. 69-L3 3-3-69
445.45
P.P.NO. 06-24-031-103
PRIOR INST: 1356/501
#21025
APPROVED
LORAIN CO.
MAP DEPT
DATE 8-26-94
PAGE 6-46
BY CAROLYN FRANCIS
#21025
DETAIL - NO TO SCALE
GRISWOLD RD.
+RW
50
30'
S/L 561
-039
HOBART ST.
+128'