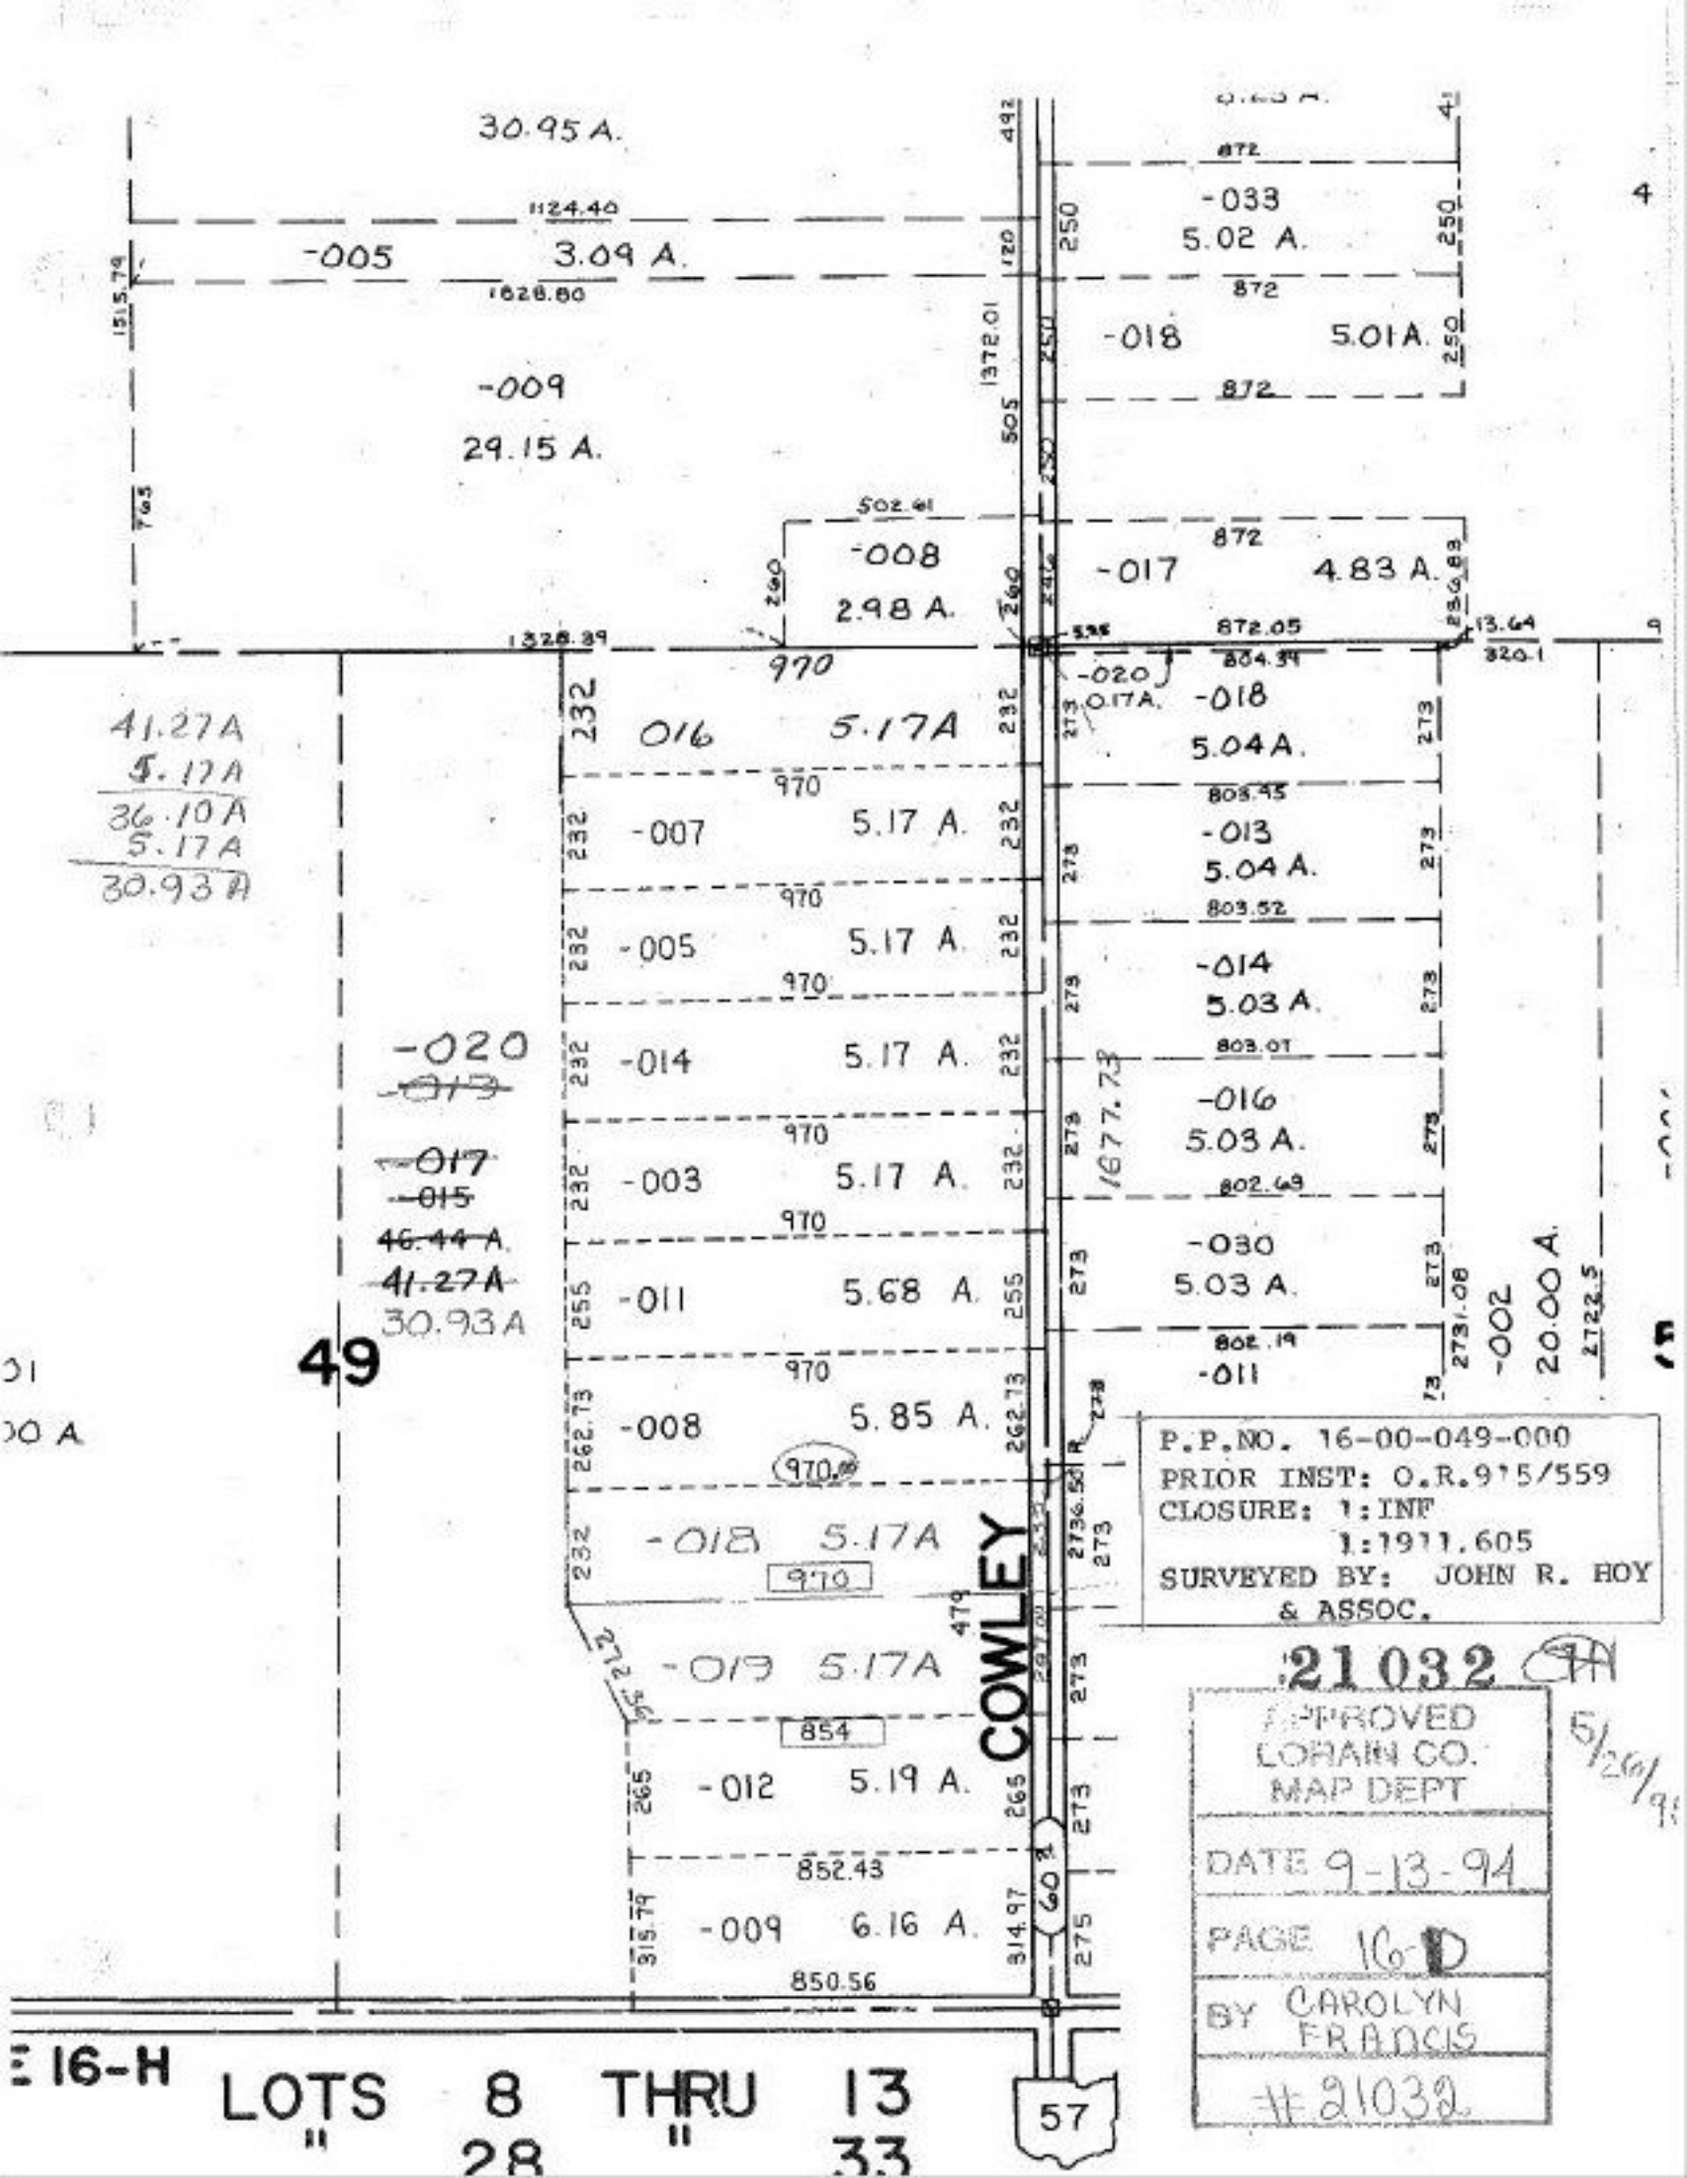
30.95 A.
-005 3.09 A.
-009 29.15 A.
-033 5.02 A.
-018 5.01A.
-008 2.98 A.
-017 4.83 A.
-020 0.17A.
-018 5.04 A.
-013 5.04 A.
-014 5.03 A.
-016 5.03 A.
-030 5.03 A.
-011
-002 20.00 A.
016 5.17A
-007 5.17 A.
-005 5.17 A.
-014 5.17 A.
-003 5.17 A.
-011 5.68 A.
-008 5.85 A.
-018 5.17A
-019 5.17A
-012 5.19 A.
-009 6.16 A.
41.27A
5.17A
36.10A
5.17A
30.93A
-020
-019
-017
-015
46.44 A.
41.27A
30.93A
49
COWLEY
P.P.NO. 16-00-049-000
PRIOR INST: O.R.915/559
CLOSURE: 1:INF
1:1911.605
SURVEYED BY: JOHN R. HOY & ASSOC.
21032
APPROVED LORAIN CO. MAP DEPT
DATE 9-13-94
PAGE 16-D
BY CAROLYN FRANCIS
#21032
5/26/94
E 16-H
LOTS 8 THRU 13
= 28 = 33
57