21037

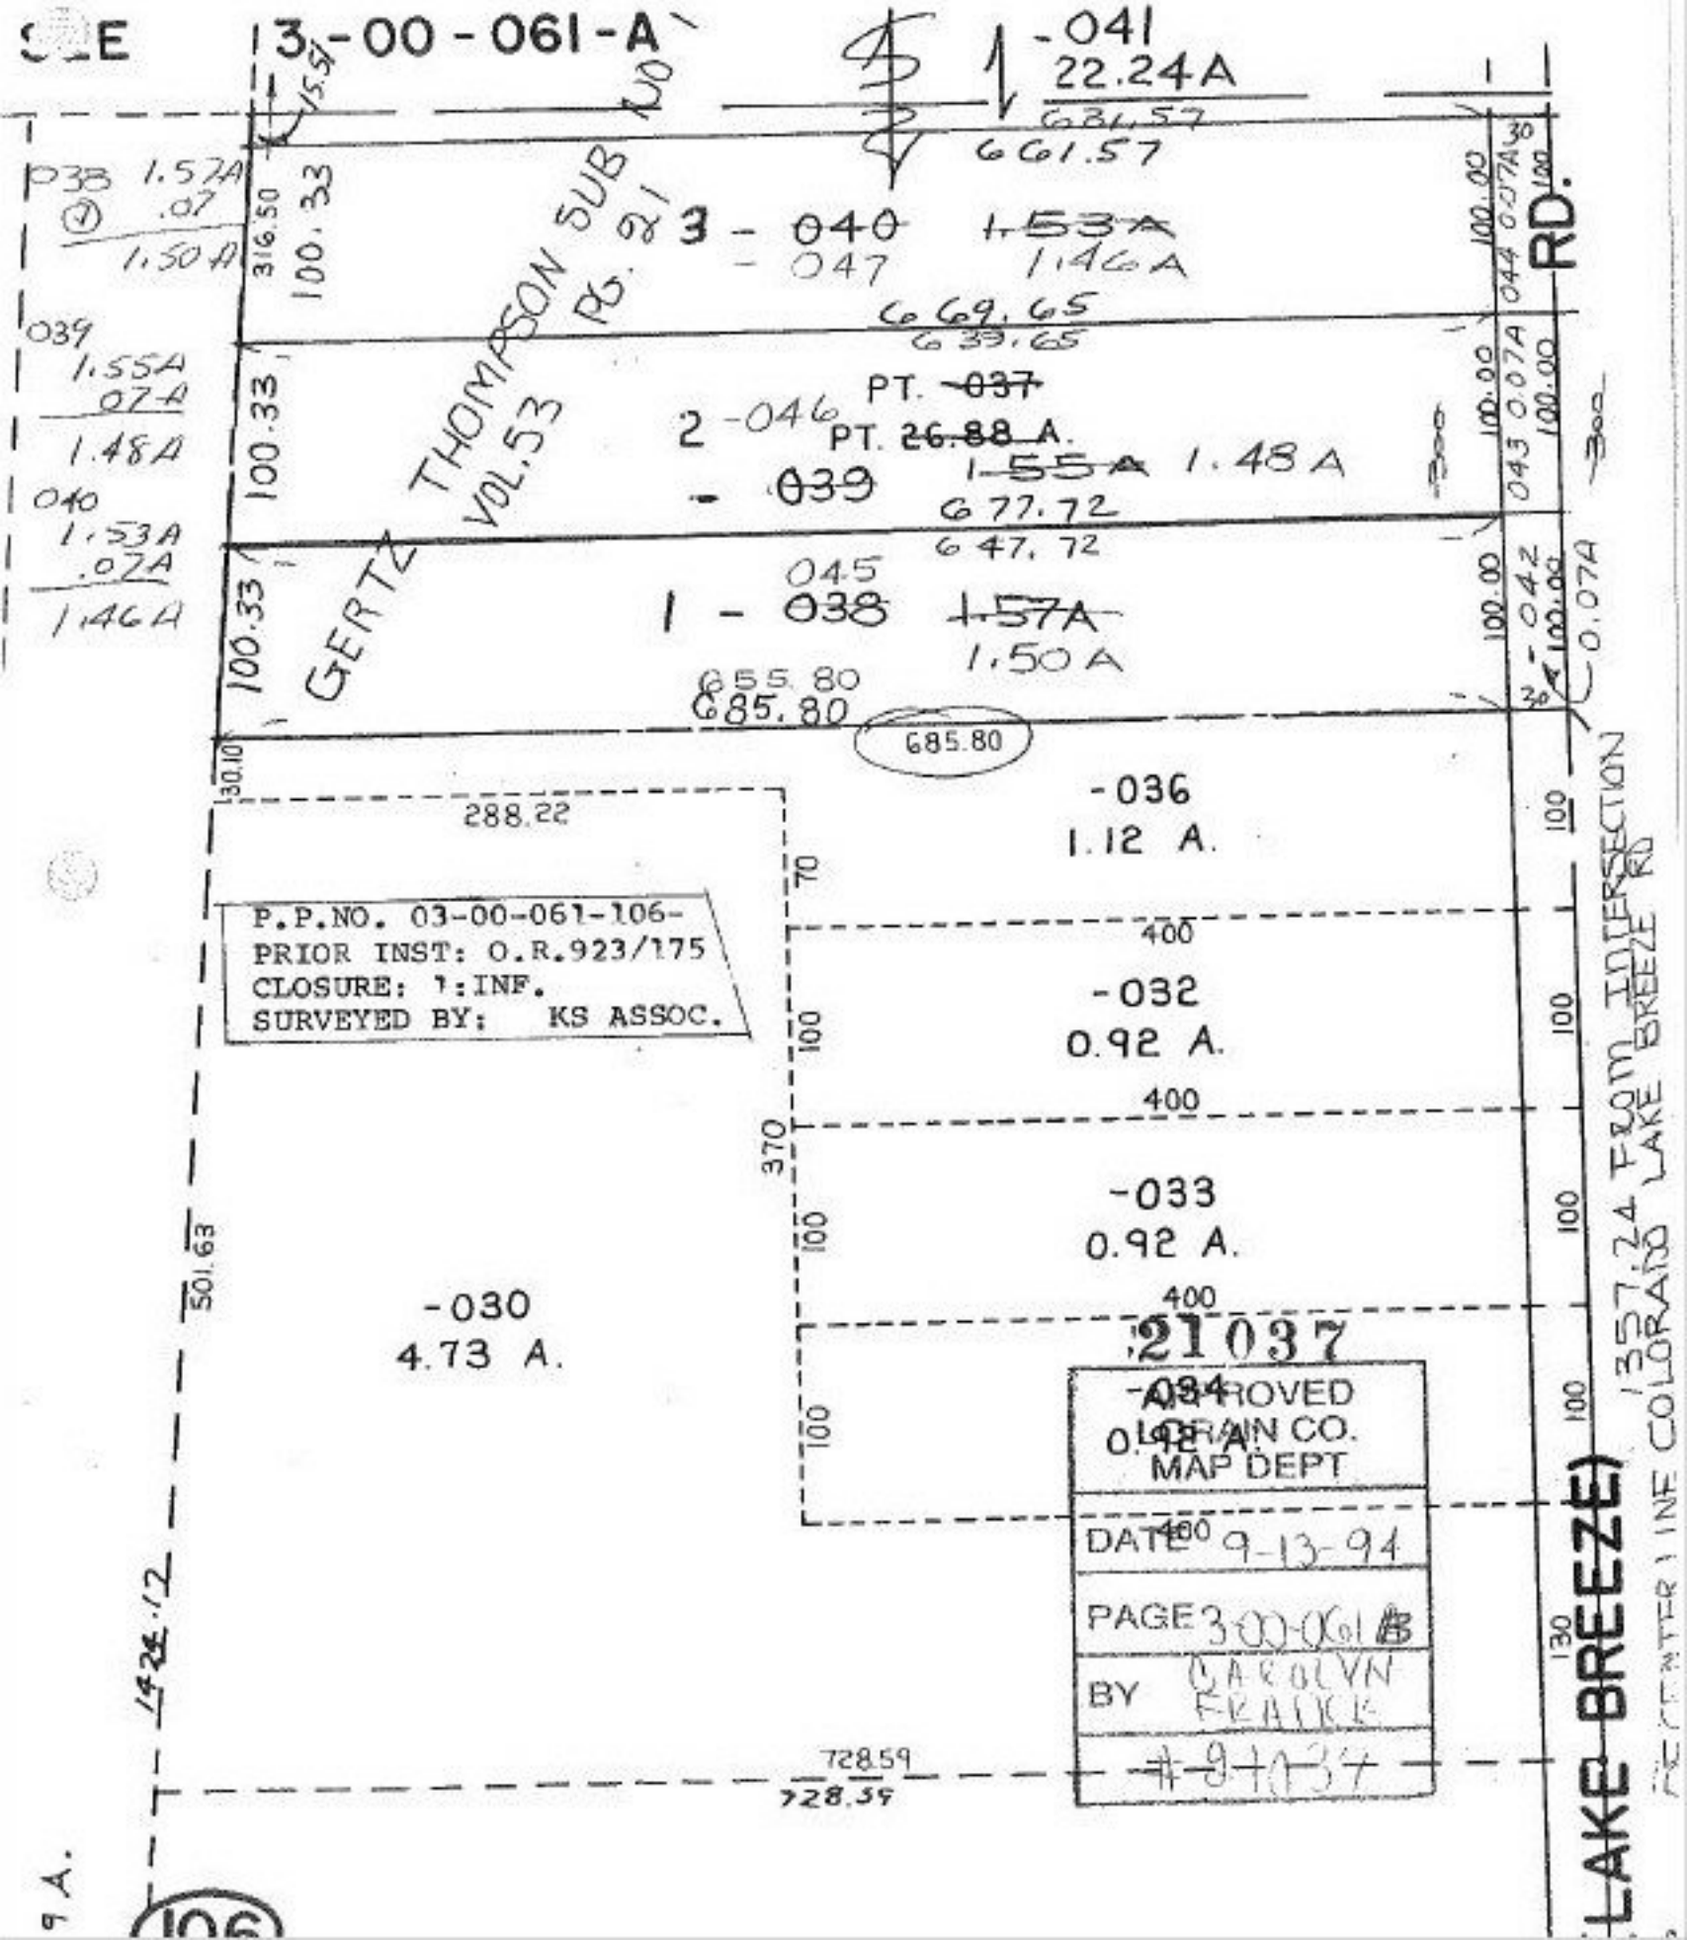
E 13-00-061-A
-041
22.24A
661.57
681.57
P38 1.57A .07 1.50A
316.50
100.33
THOMPSON SUB PG. 21
3 - 040 1.53A
- 047 1.46A
669.65
639.65
039 1.55A .07A 1.48A
PT. 037
2 -046 PT. 26.88 A.
- 039 1.55A 1.48A
677.72
647.72
040 1.53A .07A 1.46A
GERTZ VOL. 53
045
1 - 038 1.57A
1.50A
685.80
685.80
685.80
288.22
-036
1.12 A.
P.P.NO. 03-00-061-106-
PRIOR INST: O.R.923/175
CLOSURE: 1:INF.
SURVEYED BY: KS ASSOC.
-032
0.92 A.
-033
0.92 A.
-030
4.73 A.
-034
0.92 A.
21037
APPROVED
MAP DEPT
DATE 9-13-94
PAGE 3-00-061 AB
BY CAROLYN FRANCK
#-9-1037
1357.24 FROM INTERSECTION OF CENTER LINE COLORADO & LAKE BREEZE RD
LAKE BREEZE RD.
1425.12
728.59
728.39
100.00
100.33
100.00
100.00
100.00