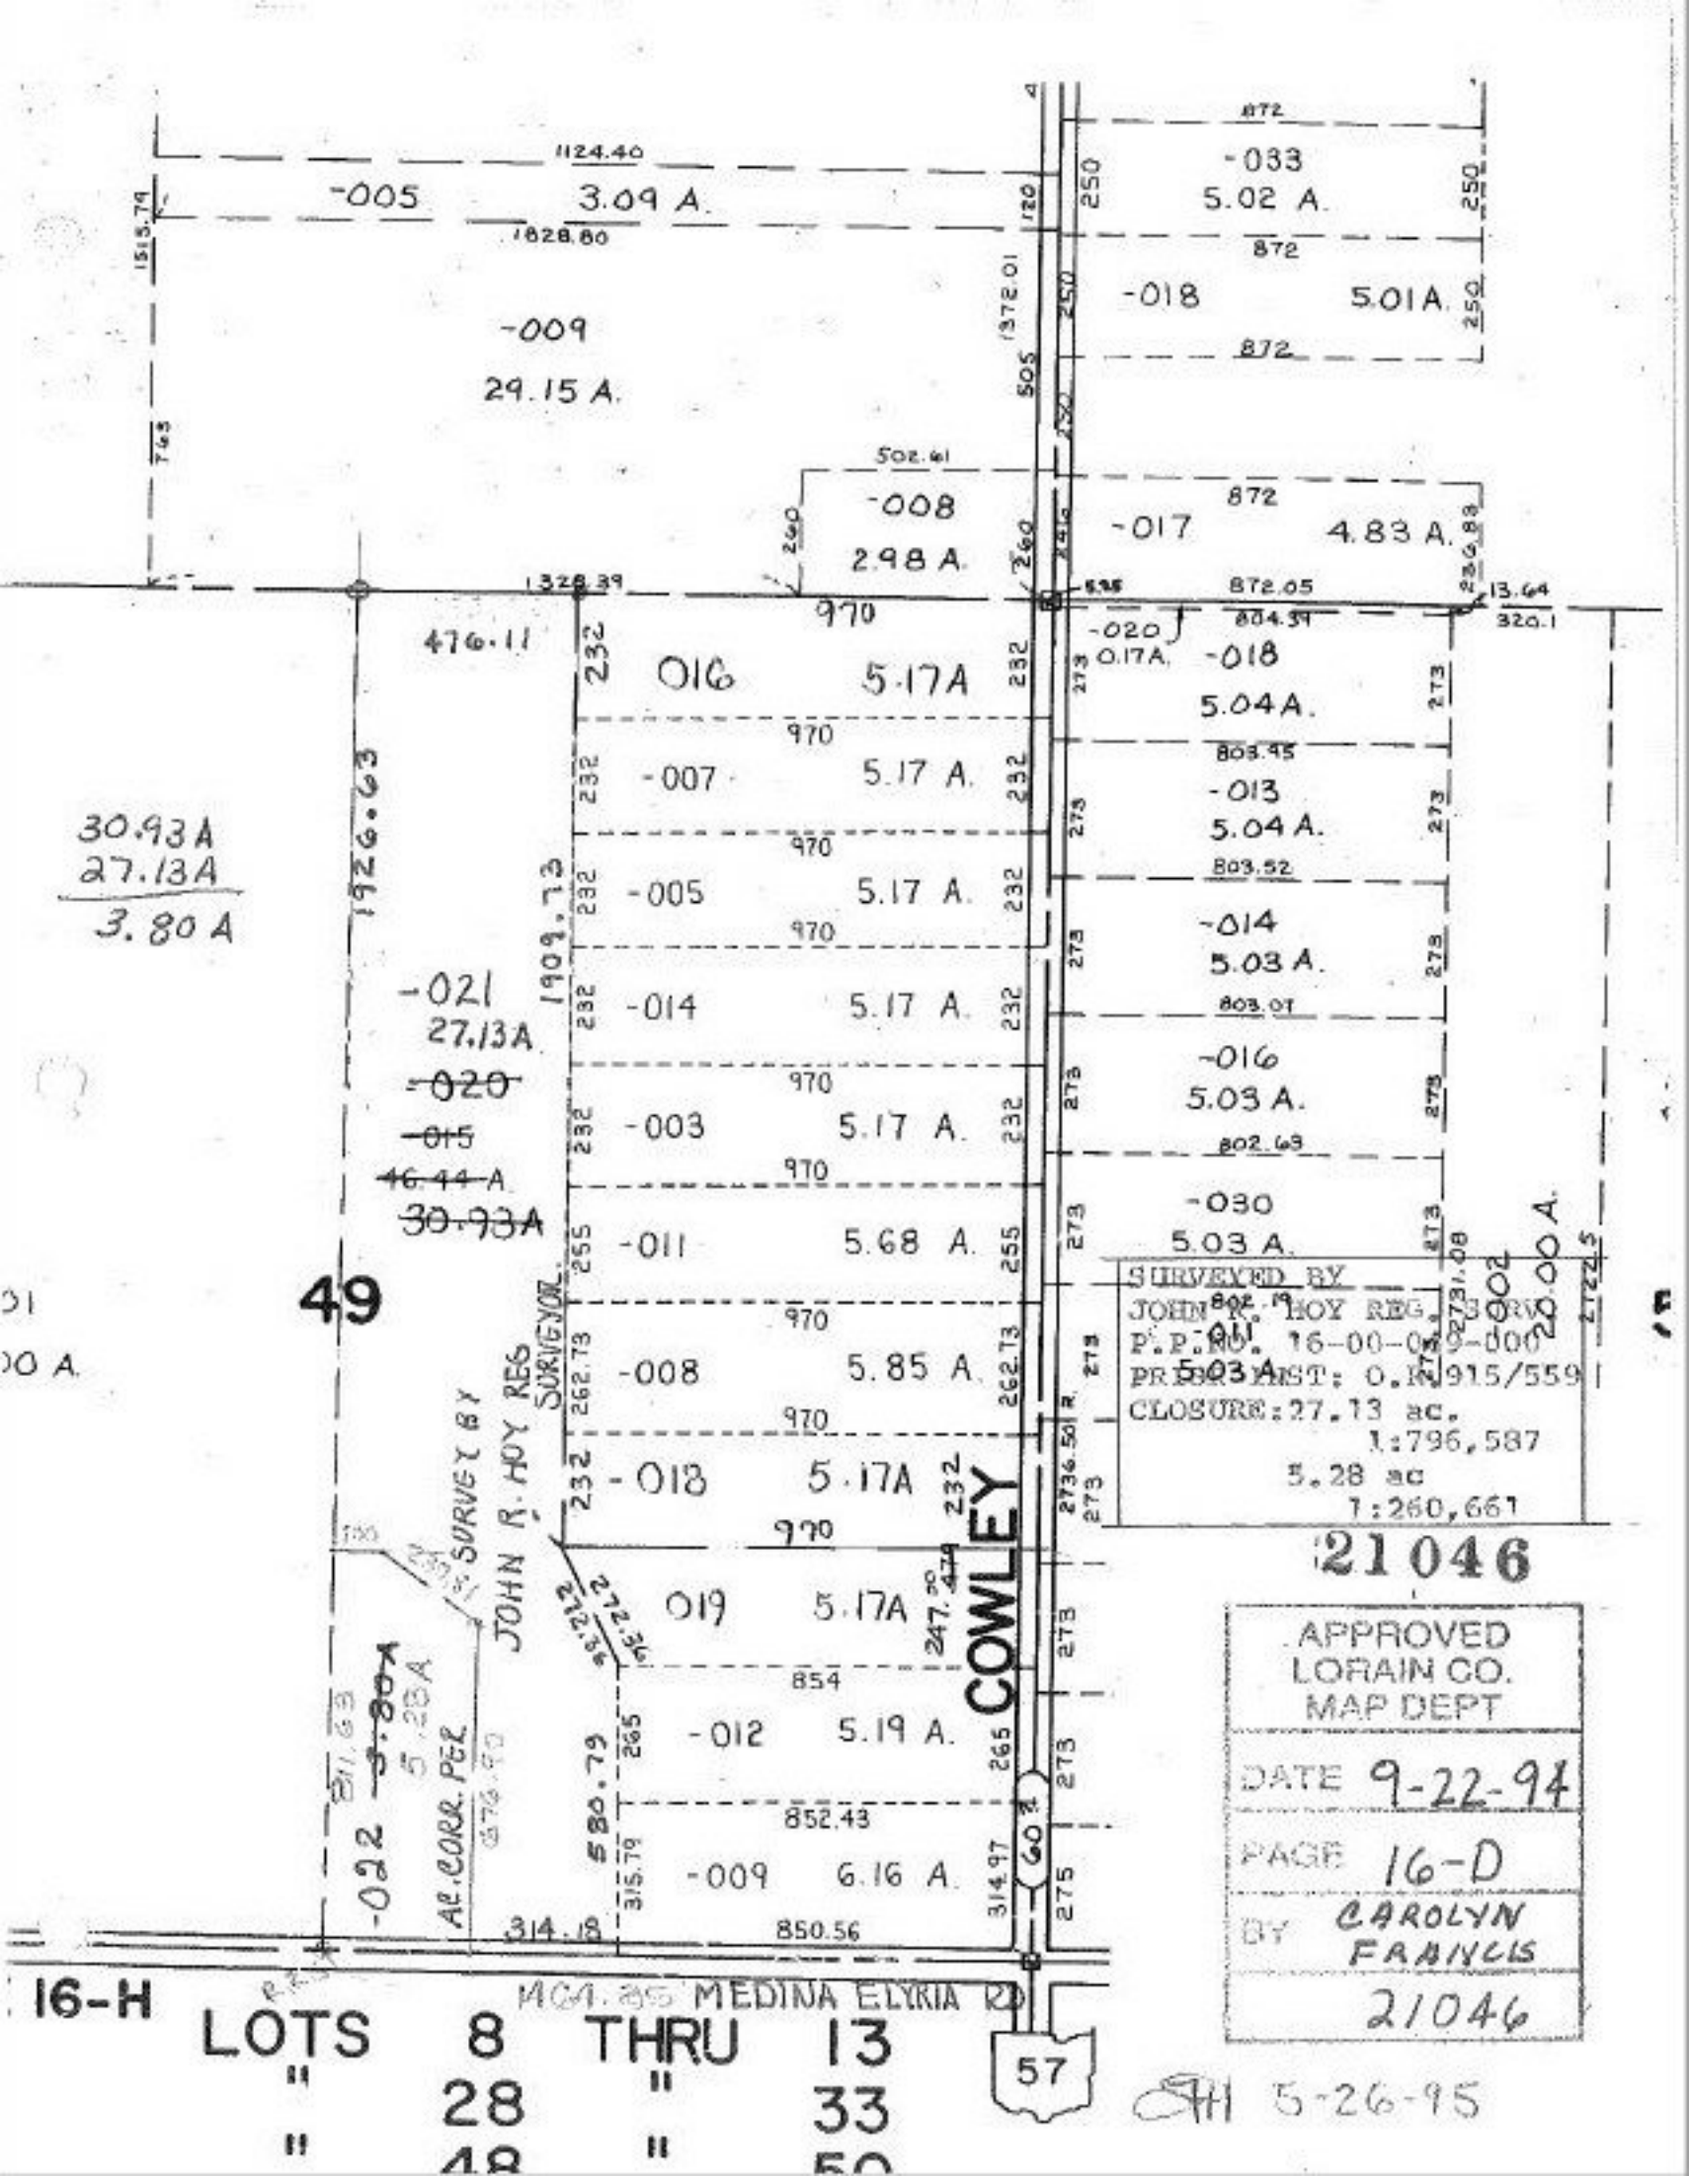

-005 3.09 A.
-009 29.15 A.
-008 2.98 A.
-033 5.02 A.
-018 5.01 A.
-017 4.83 A.
-020 0.17 A.
-018 5.04 A.
-013 5.04 A.
-014 5.03 A.
-016 5.03 A.
-030 5.03 A.
-002 20.00 A.
-016 5.17 A
-007 5.17 A.
-005 5.17 A.
-014 5.17 A.
-003 5.17 A.
-011 5.68 A.
-008 5.85 A.
-018 5.17 A
-019 5.17 A
-012 5.19 A.
-009 6.16 A.
30.93 A
27.13 A
3.80 A
-021 27.13 A
~~-020~~
~~-015~~
~~46.44 A~~
~~30.93 A~~
-022 ~~3.80 A~~ 5.28 A
AC. CORR. PER
SURVEY BY JOHN R. HOY REG SURVEYOR
COWLEY
49
16-H
MEDINA ELYRIA RD
57
SURVEYED BY
JOHN R. HOY REG. SURV.
P.P. NO. 16-00-019-000
PRIOR INST: O.R. 915/559
CLOSURE: 27.13 ac.
1:796,587
5.28 ac
1:260,661
21046
APPROVED
LORAIN CO.
MAP DEPT
DATE 9-22-94
PAGE 16-D
BY CAROLYN FRANCIS
21046
LOTS 8 THRU 13
" 28 " 33
" 48 " 50
5-26-95