21051

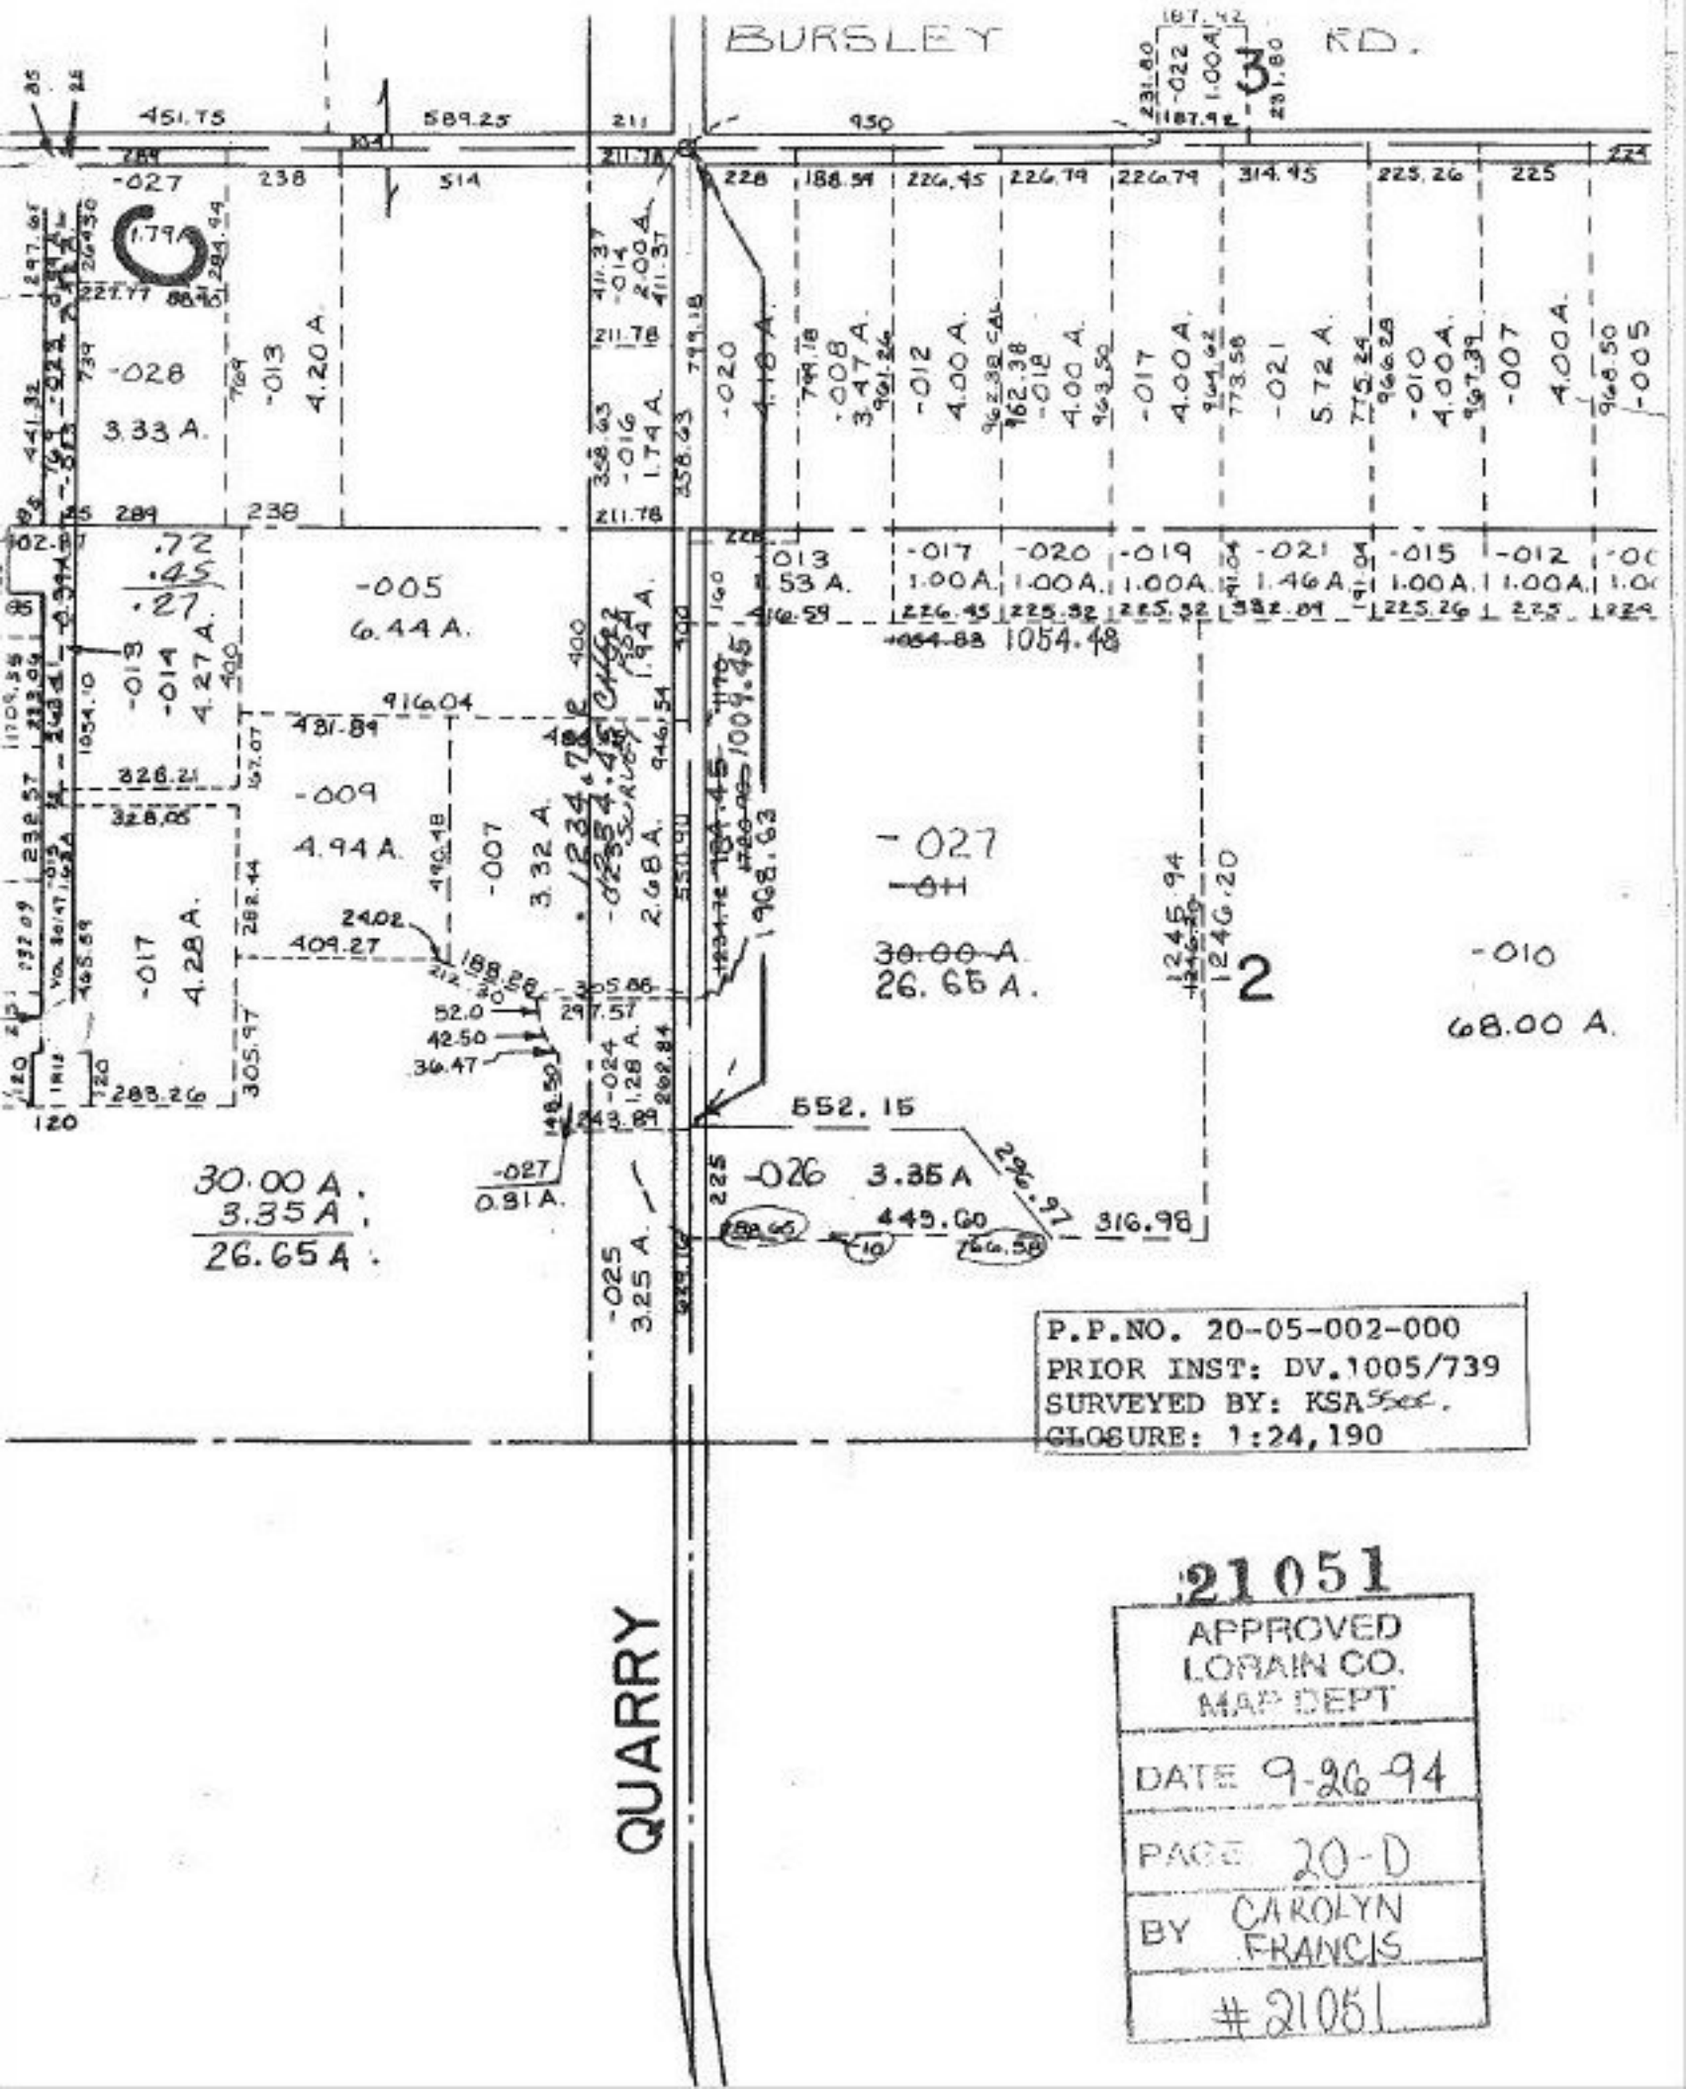

P.P.NO. 20-05-002-000
PRIOR INST: DV.1005/739
SURVEYED BY: KSA Sec.
CLOSURE: 1:24,190

21051

APPROVED
LORAIN CO.
MAP DEPT

DATE 9-26-94

PAGE 20-D

BY CAROLYN FRANCIS

#21051