#21055

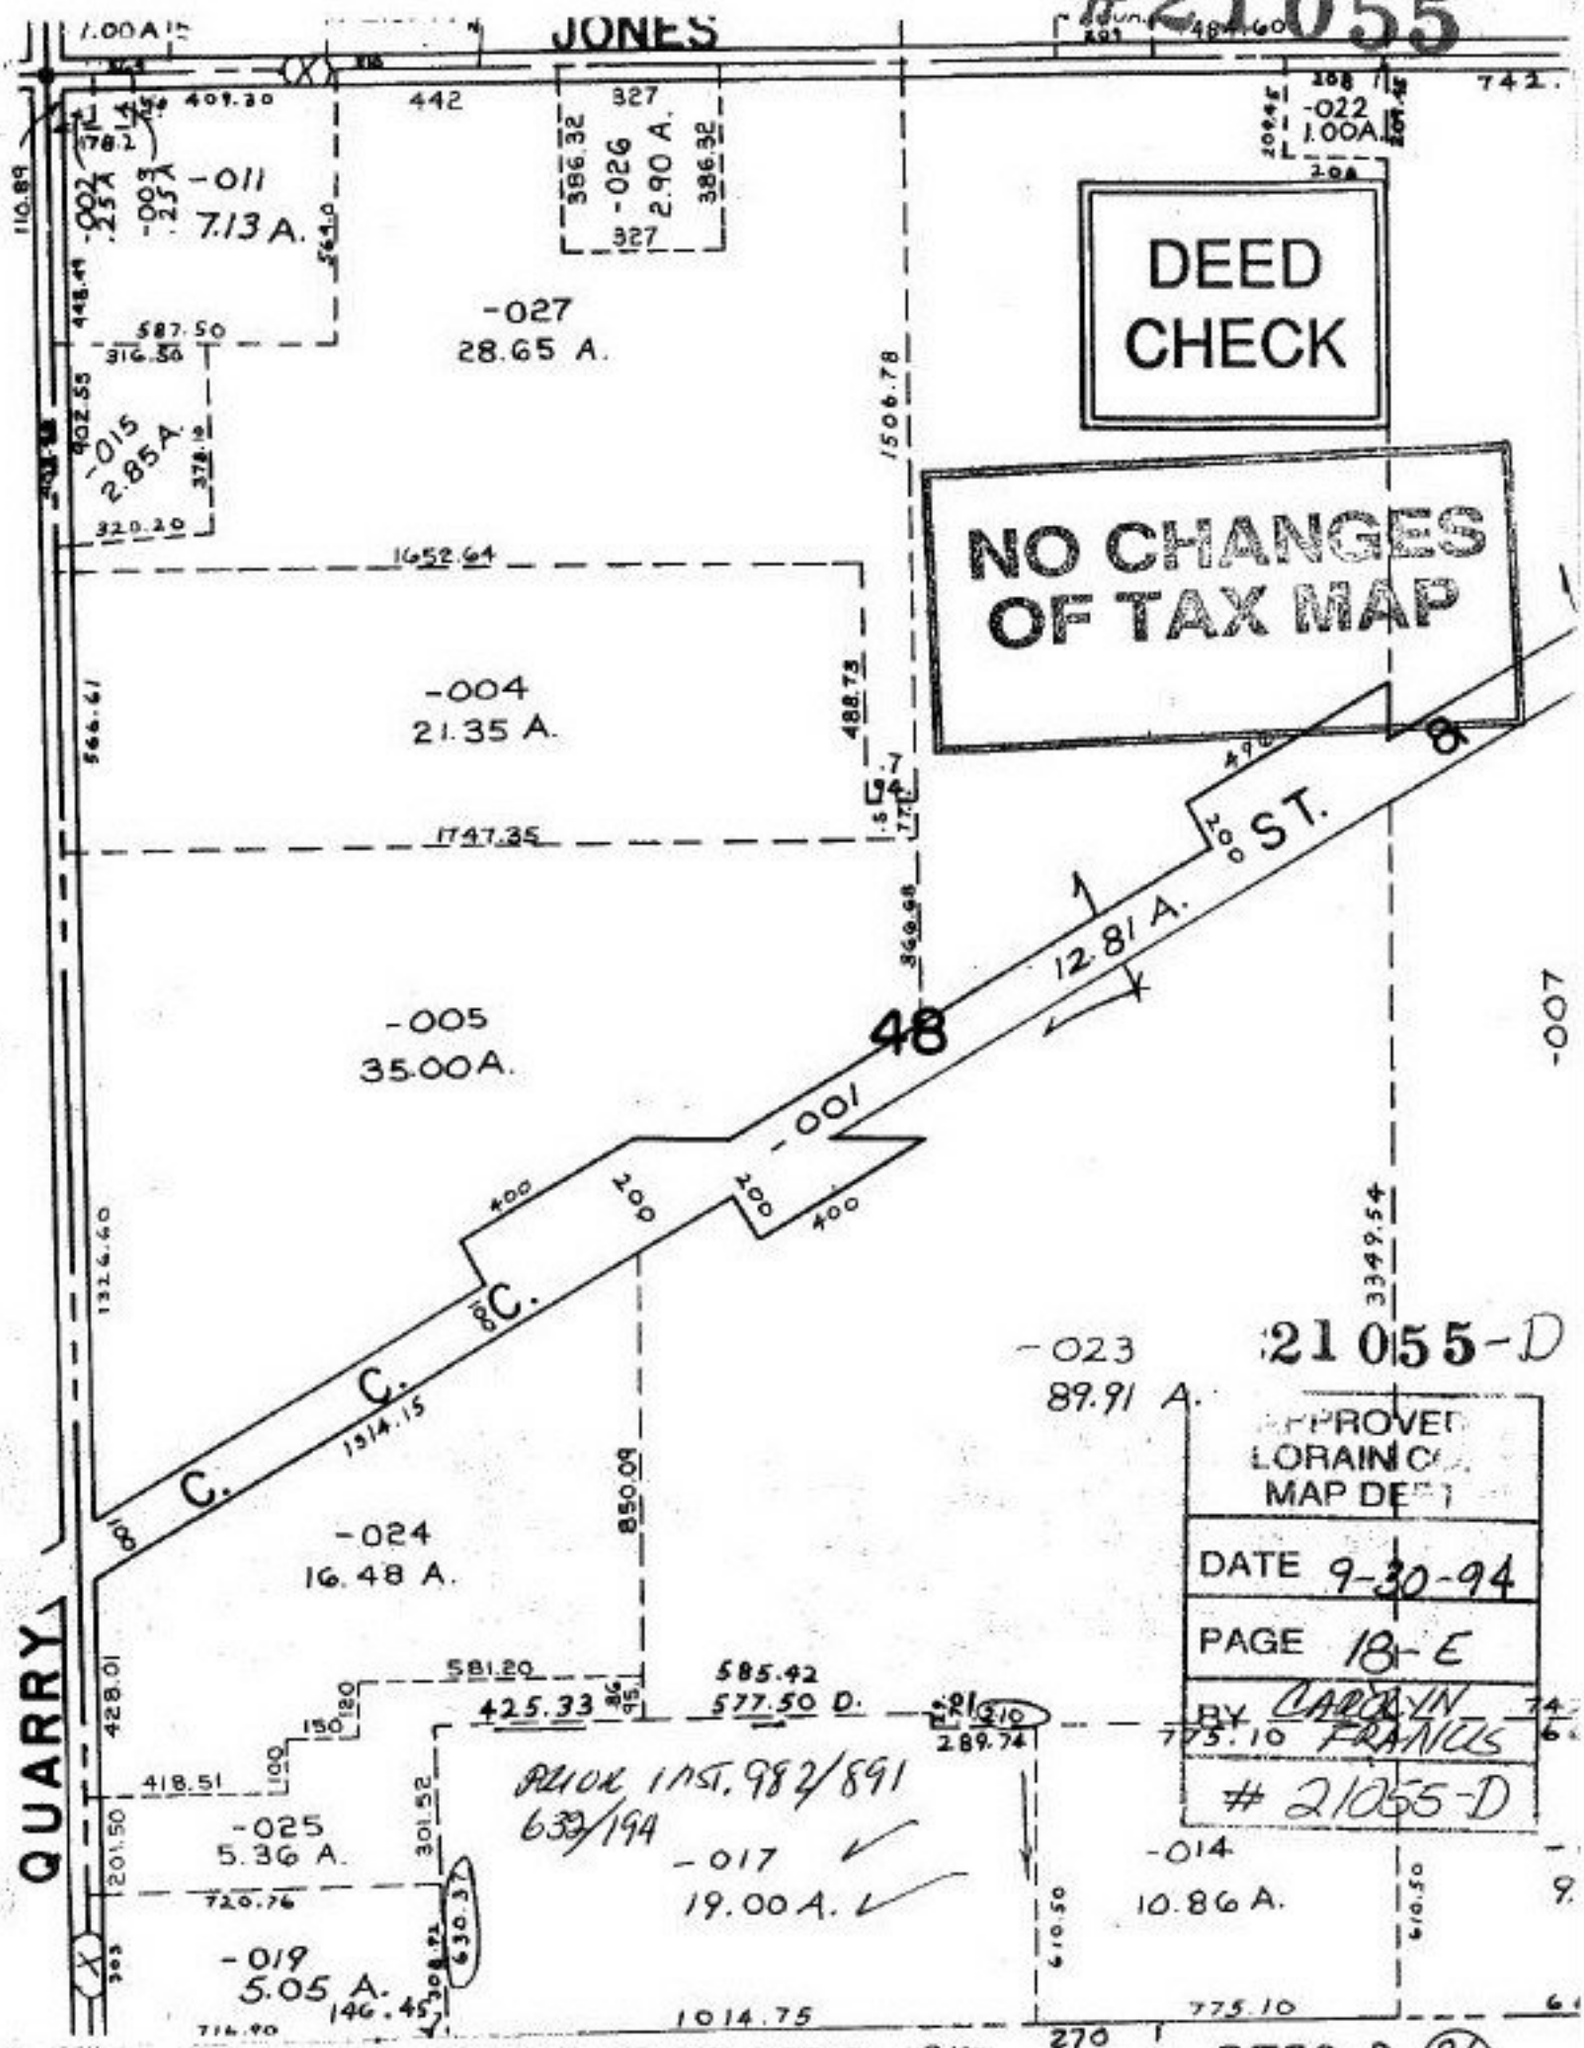


18-E

18-00-048-000-017 DEED 2 (2/2)