21055-D
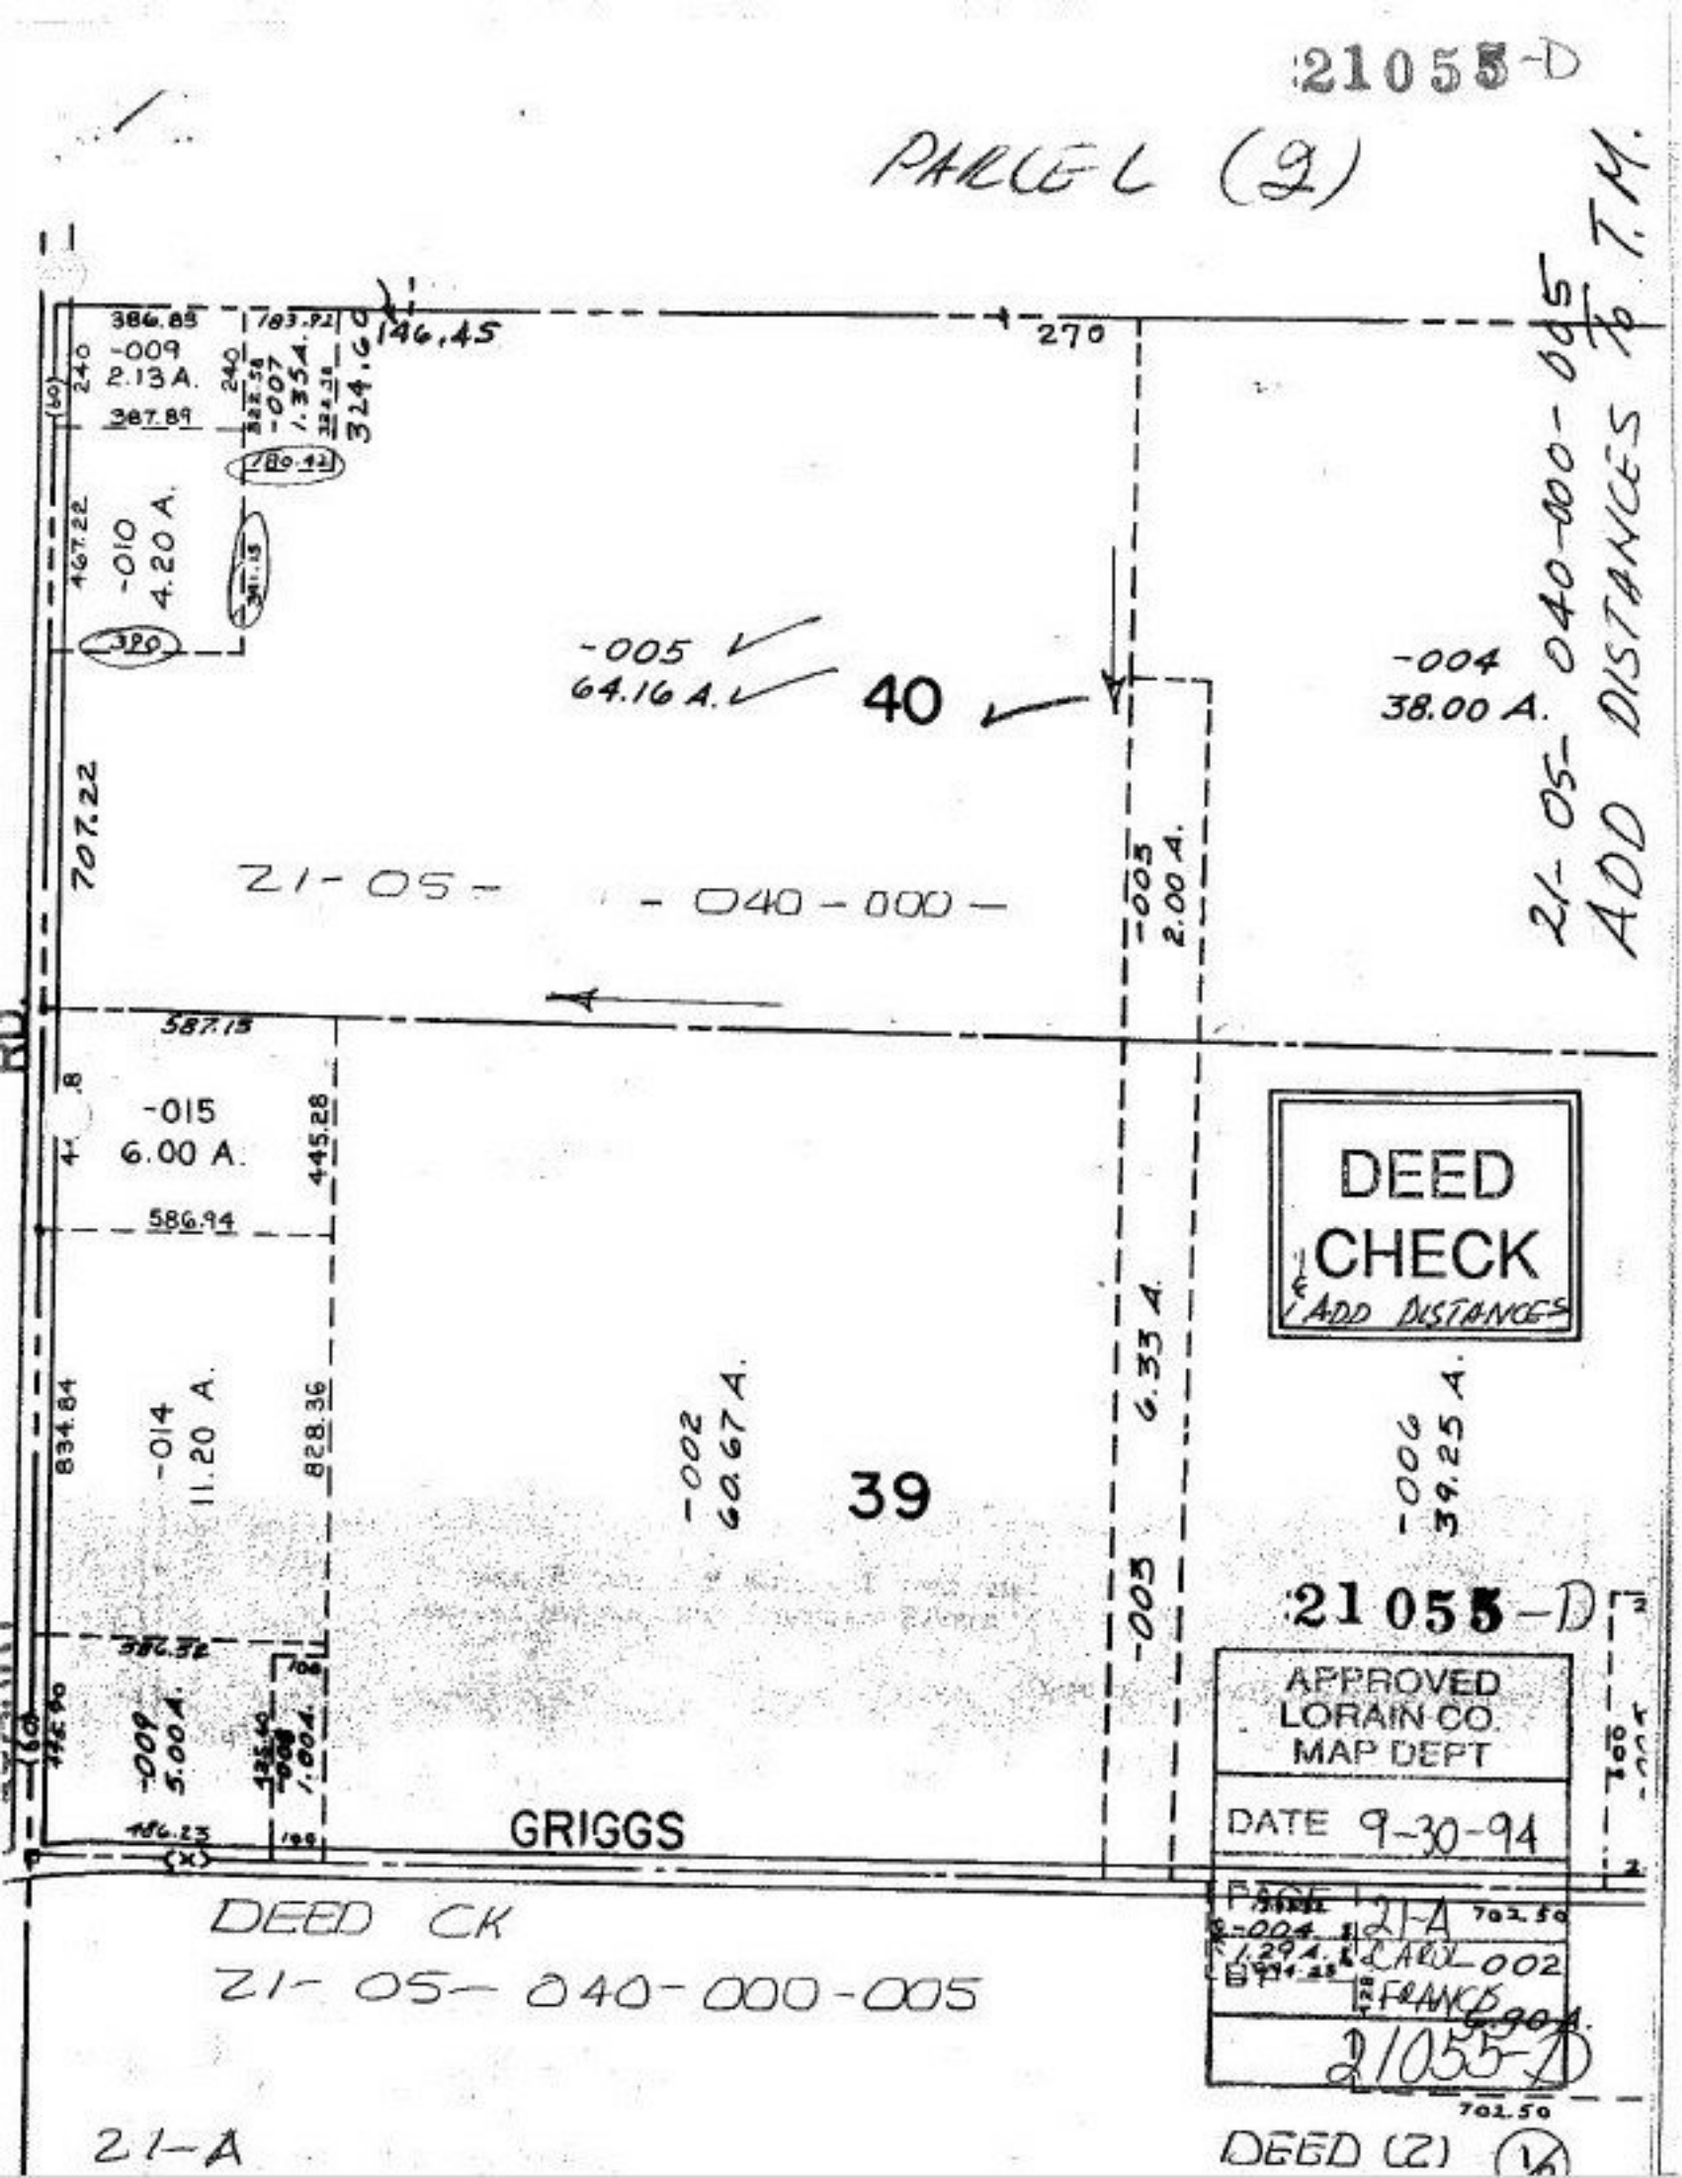
PARCEL (2)