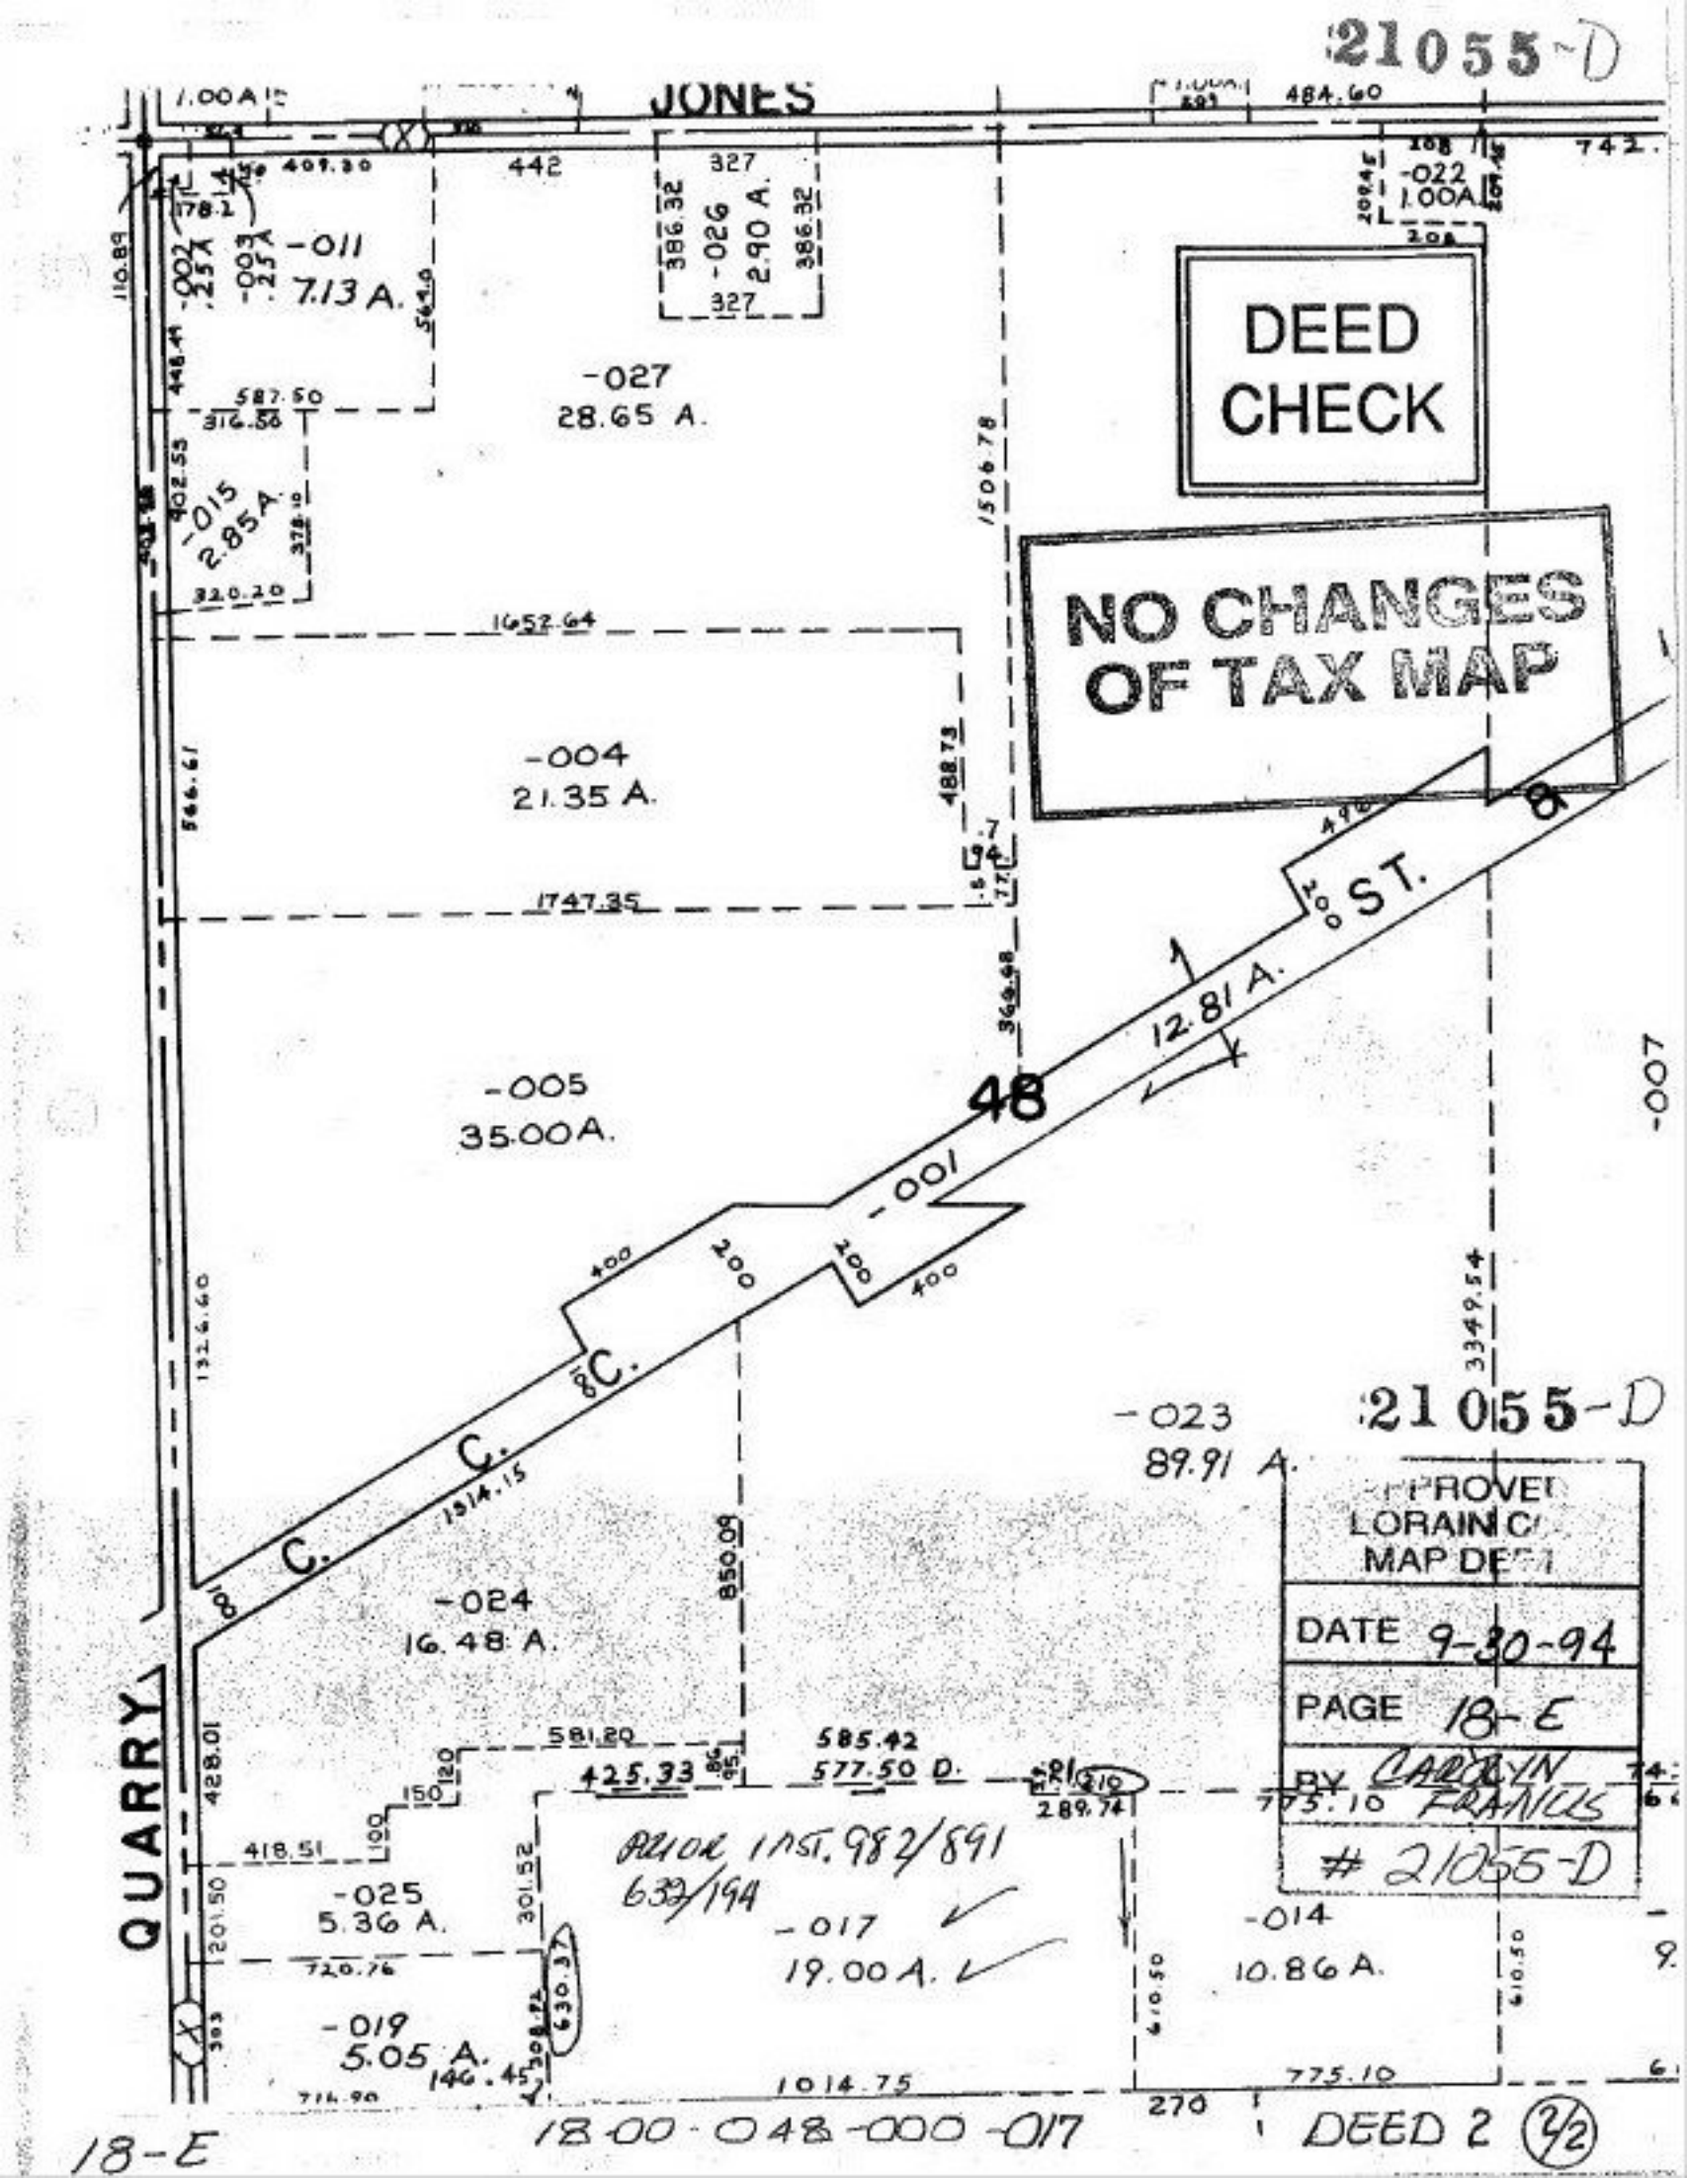
21055-D
JONES
1.00A
484.60
742.
-022
1.00A
-011
7.13 A.
-002
2.5A
-003
2.5A
-026
2.90 A.
-027
28.65 A.
DEED
CHECK
NO CHANGES
OF TAX MAP
-015
2.85A.
-004
21.35 A.
1652.64
1747.35
1506.78
-005
35.00A.
12.81 A.
48
ST.
-001
-007
-023
89.91 A.
21055-D
-024
16.48 A.
QUARRY
8' C.
1314.15
850.09
3349.54
1324.60
425.33
577.50 D.
585.42
581.20
775.10
289.74
PRIOR INST. 982/891
633/194
-017
19.00 A.
-025
5.36 A.
-019
5.05 A.
-014
10.86 A.
1014.75
714.90
630.37
140.45
IMPROVED
LORAIN CO.
MAP DEPT.
DATE 9-30-94
PAGE 18-E
BY CAROLYN FRANCIS
# 21055-D
18-00-048-000-017
DEED 2 (2/2)
18-E