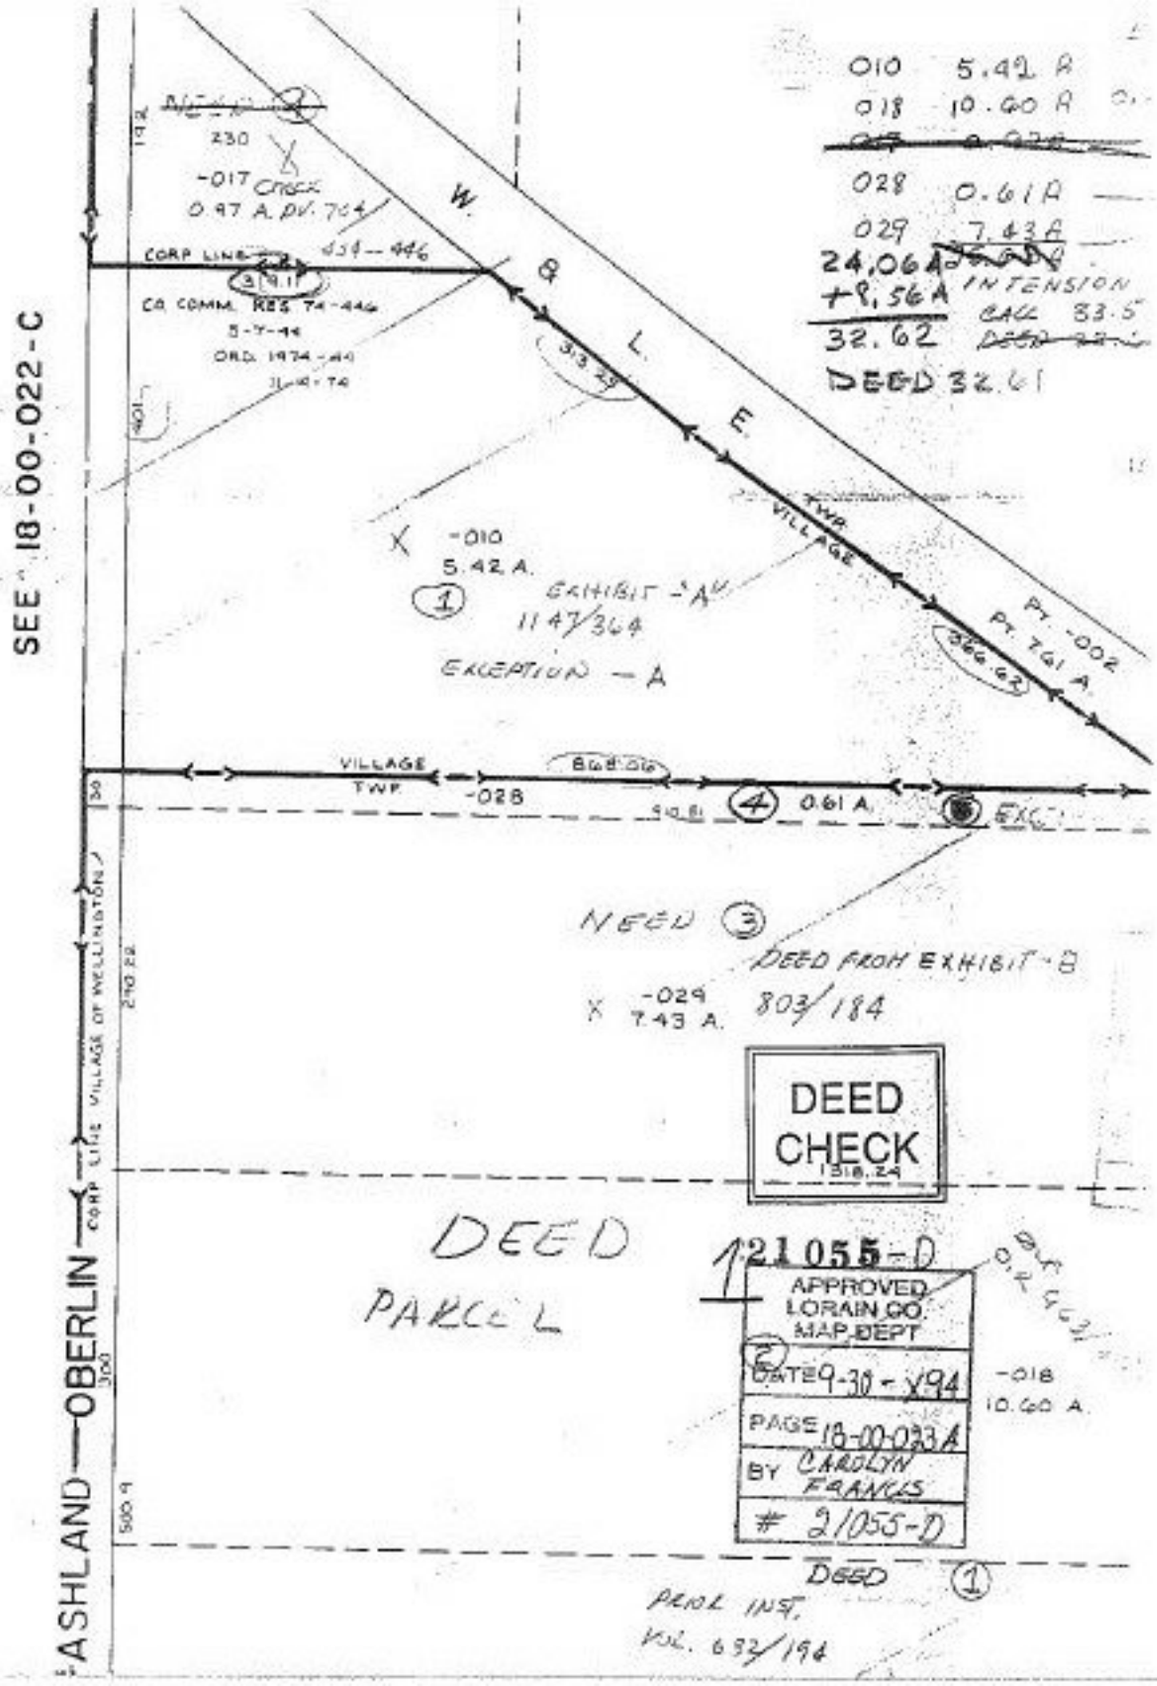
SEE 18-00-022-C
010 5.42 A
018 10.60 A
028 0.61A
029 7.43A
24,064
+8.56A INTENSION
32.62
DEED 32.61
W. & L. E.
CORP LINE
CO. COMM. RES 74-446
5-7-74
ORD. 1974-40
-017 CHECK
0.97 A. PV. 704
-010
5.42 A.
EXHIBIT "A"
1147/364
EXCEPTION - A
VILLAGE TWP.
PT. -002
PT. 7.61 A.
-028
0.61 A.
EXC.
NEED (3)
DEED FROM EXHIBIT-B
-029
7.43 A.
803/184
DEED CHECK
1318.24
DEED
PARCEL
121055-D
APPROVED
LORAIN CO.
MAP DEPT
DATE 9-30-94
PAGE 18-00-033A
BY CAROLYN FRANCIS
# 21055-D
-018
10.60 A.
DEED
PERC INST.
VOL. 693/194
ASHLAND — OBERLIN
CORP LINE VILLAGE OF WELLINGTON

21055-D