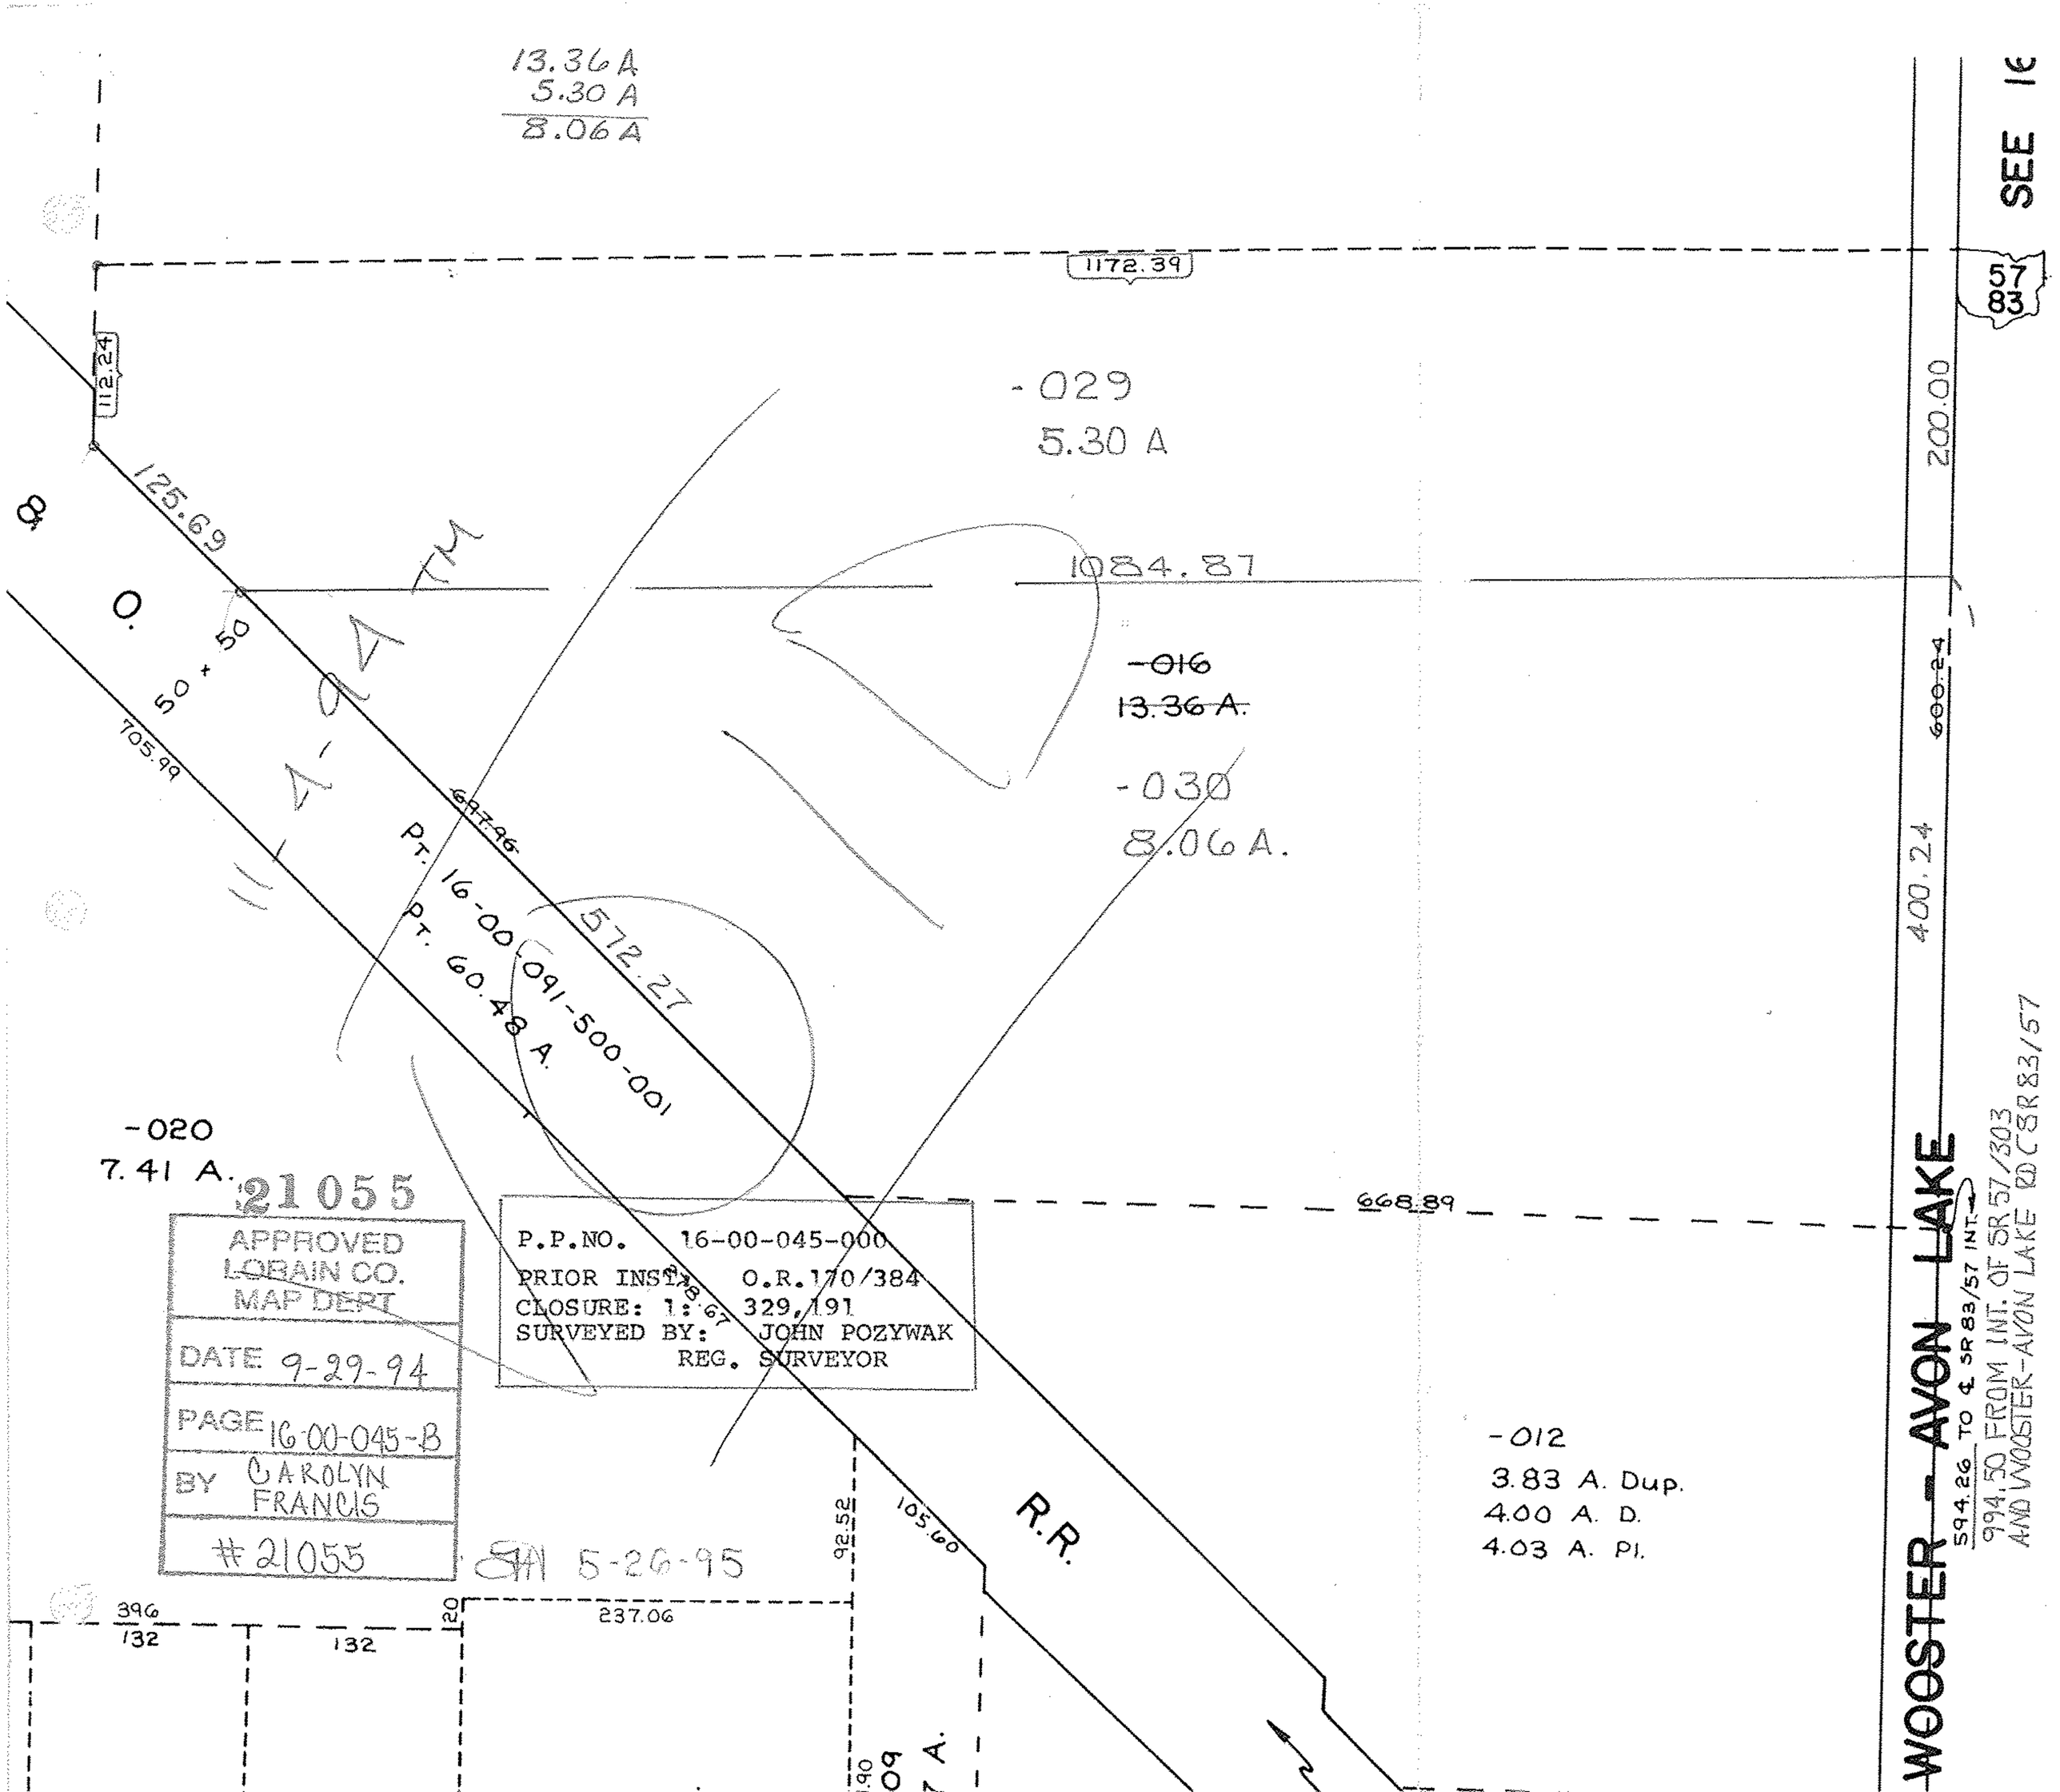
13.36 A
5.30 A
8.06 A
1172.39
112.24
125.69
-029
5.30 A
1084.87
-016
13.36 A.
-030
8.06 A.
50 x 50
705.99
697.96
PT. 16-00-091-500-001
PT. 60.48 A.
572.27
-020
7.41 A.
21055
APPROVED
LORAIN CO.
MAP DEPT
DATE 9-29-94
PAGE 16-00-045-B
BY CAROLYN FRANCIS
#21055
P.P.NO. 16-00-045-000
PRIOR INST. O.R.170/384
CLOSURE: 1: 329,191
SURVEYED BY: JOHN POZYWAK
REG. SURVEYOR
668.89
-012
3.83 A. Dup.
4.00 A. D.
4.03 A. Pl.
R.R.
105.60
92.52
237.06
396
132
132
200.00
600.24
400.24
SEE 16
57
83
WOOSTER - AVON LAKE
594.26 TO ℄ SR 83/57 INT.
994.50 FROM INT. OF SR 57/303
AND WOOSTER-AVON LAKE RD C SR 83/57