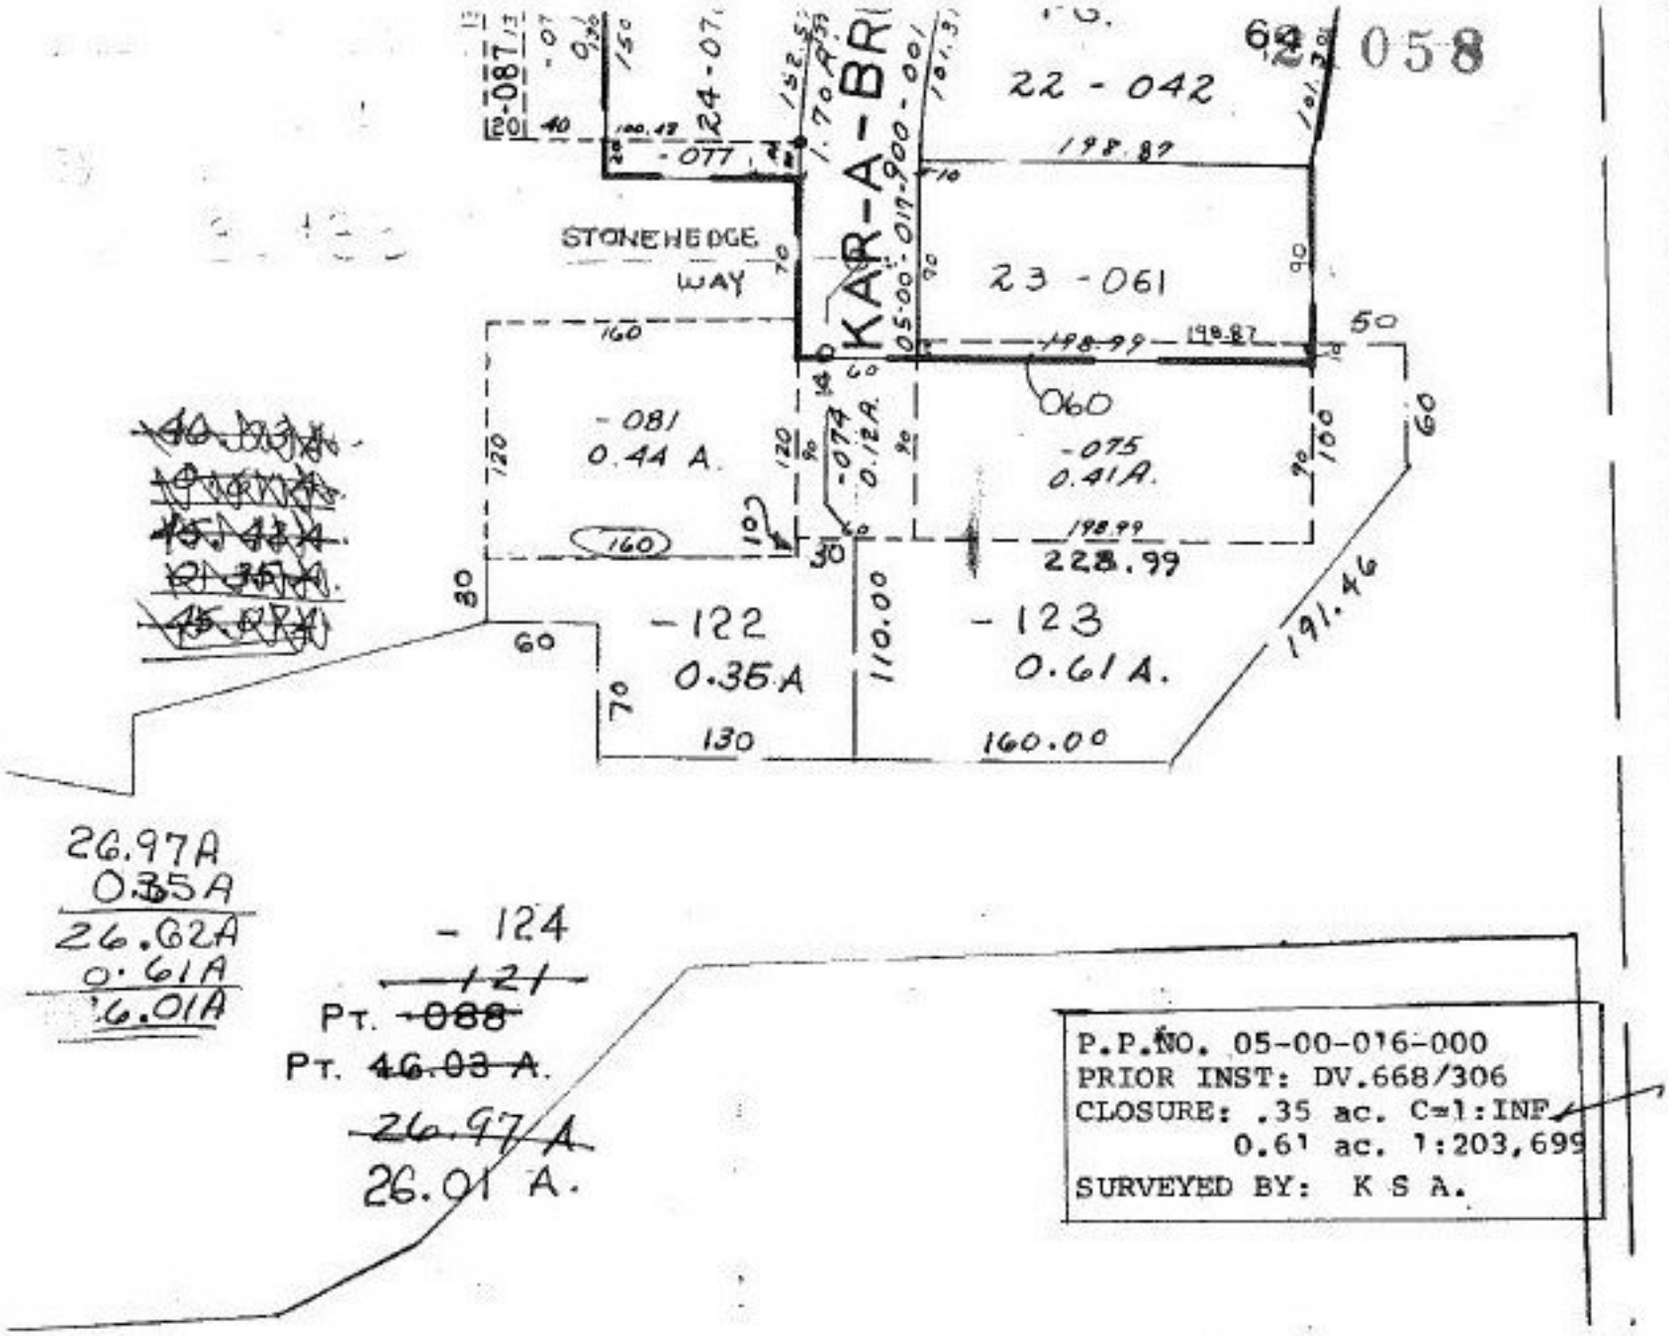

21058

APPROVED
LORAIN CO.
MAP DEPT

DATE 10-11-94

PAGE 5-00-016A

BY CAROLYN FRANCIS

21058