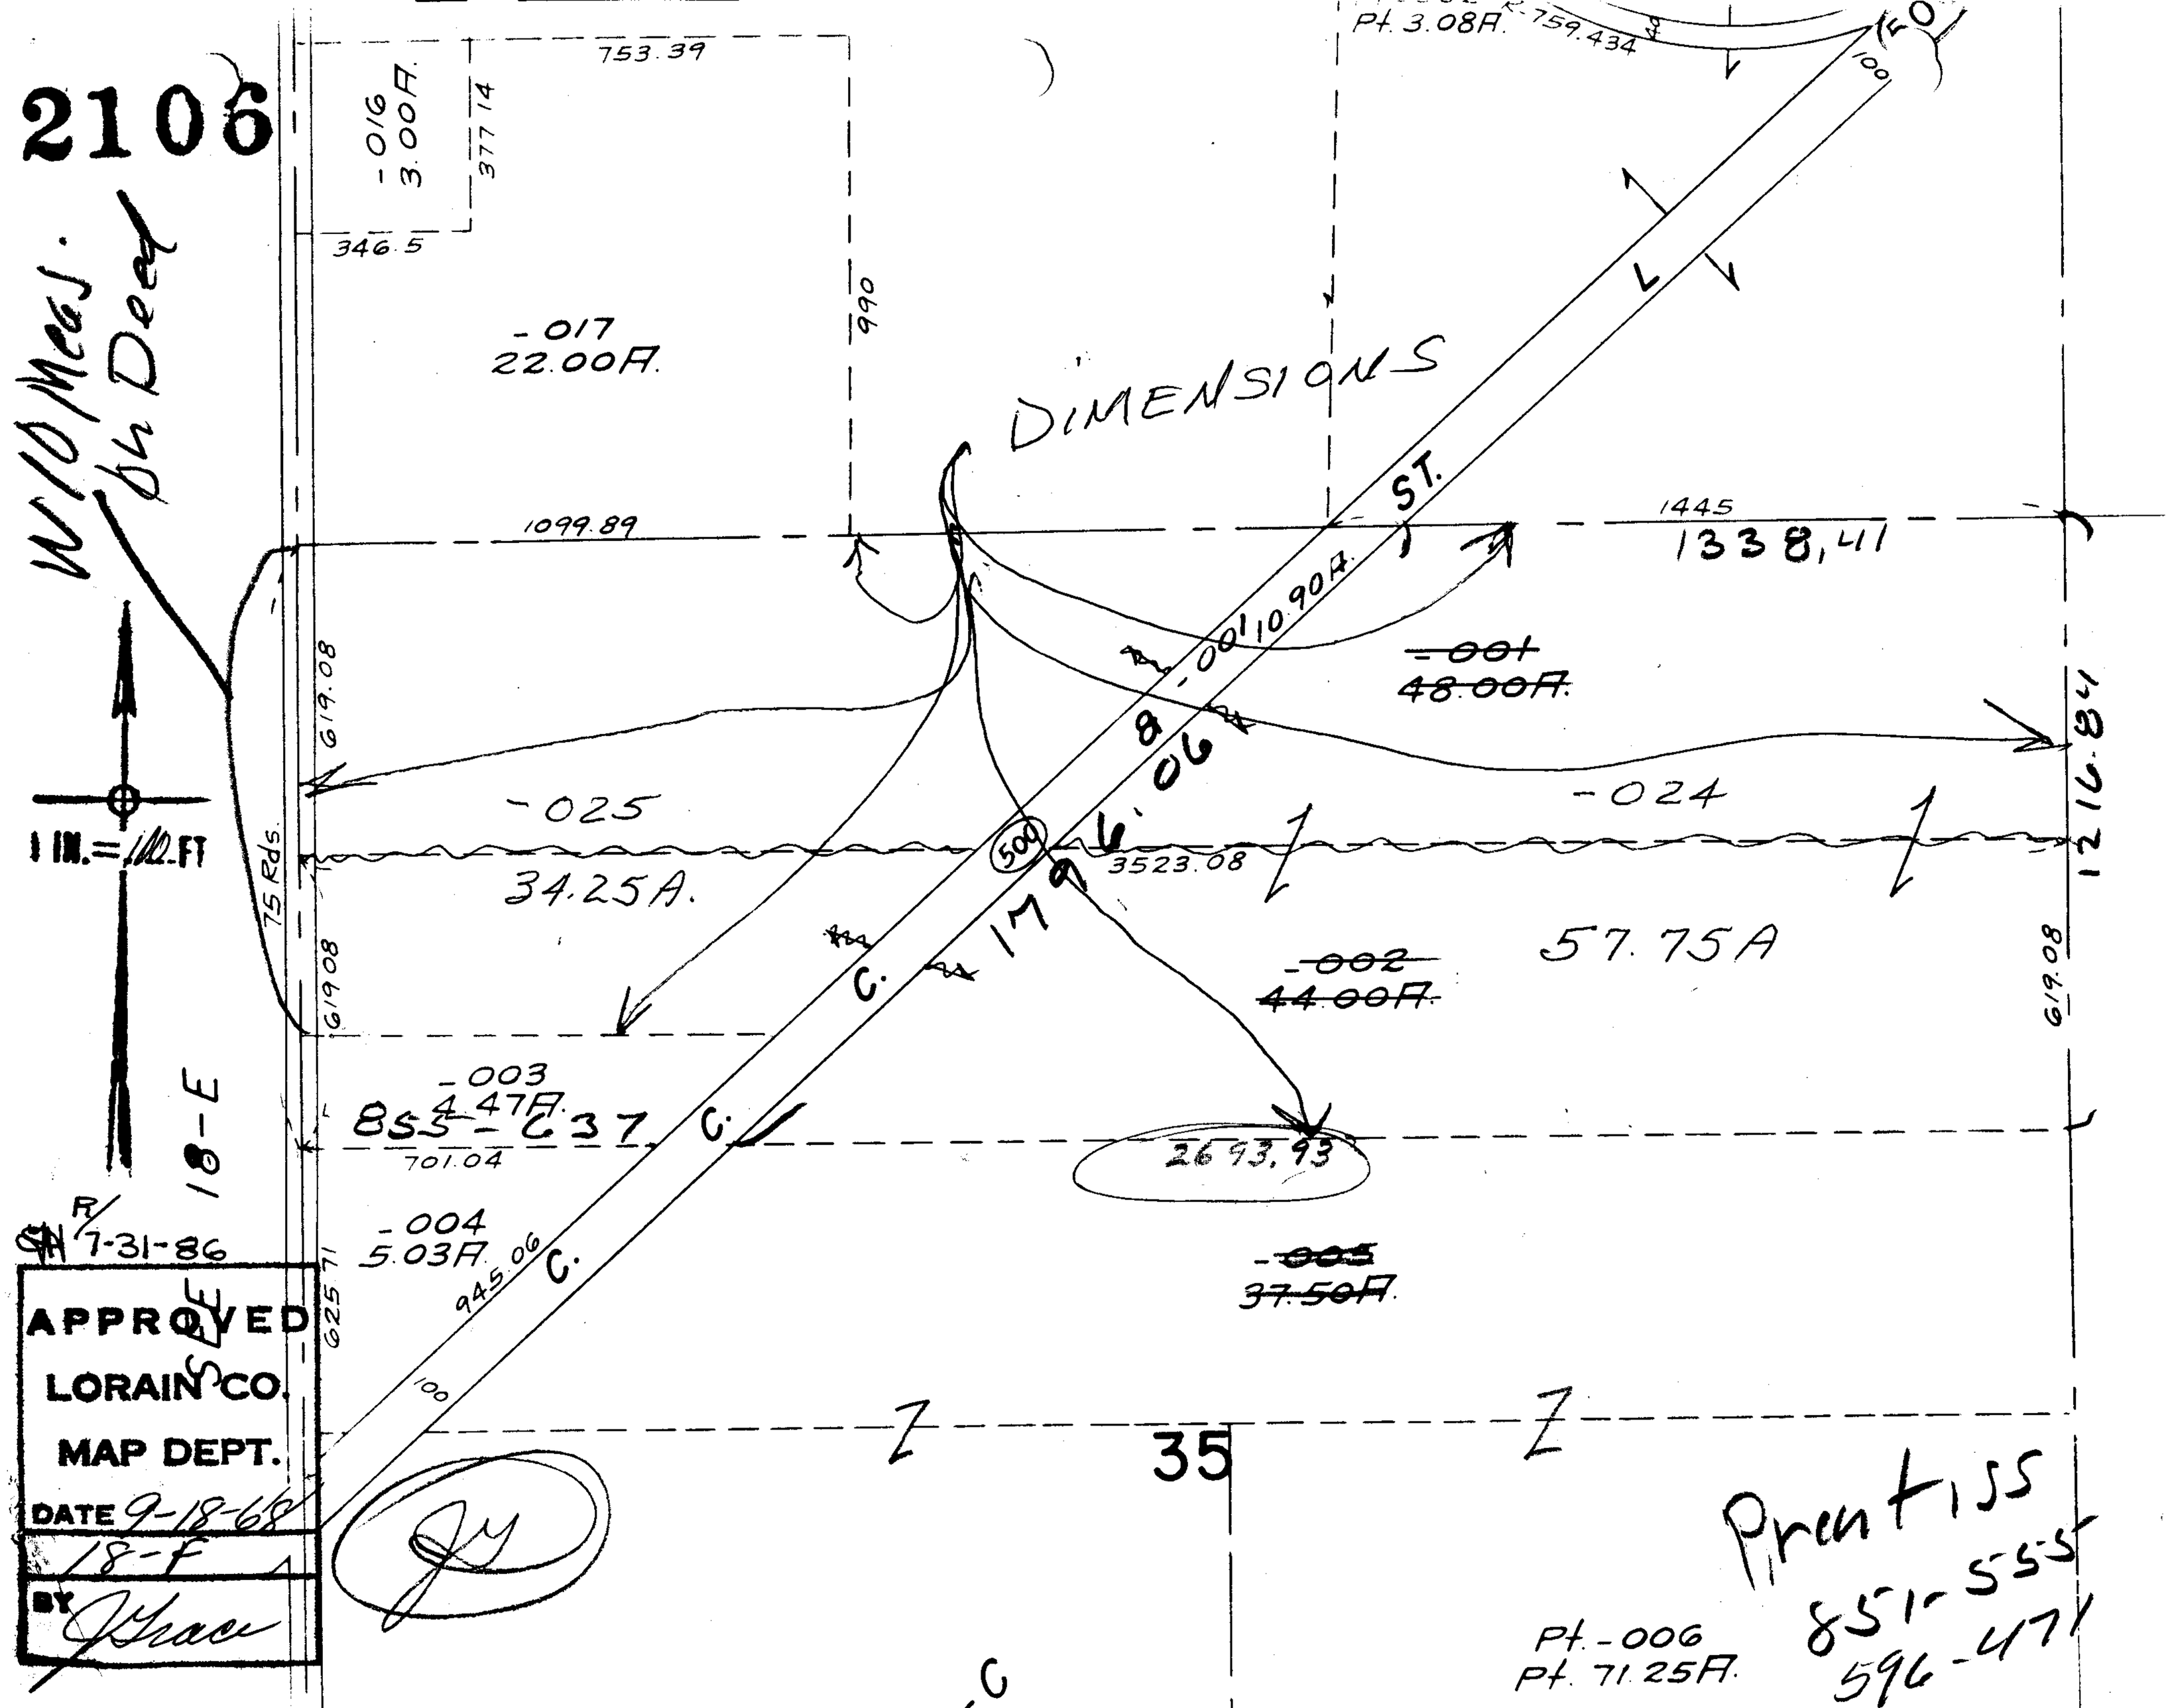
2106
W/O Meas. on Deed
1 IN. = 100 FT
753.39
-016
3.00A.
377.14
346.5
-017
22.00A.
990
DIMENSIONS
Pt. 3.08A.
759.434
100
L
ST.
1099.89
1445
1338.41
-001
10.90A.
-001
48.00A.
619.08
-025
-024
1796.06
500
3523.08
34.25A.
57.75A
1216.84
619.08
-002
44.00A.
-003
4.47A.
855-637
701.04
2693.93
-004
5.03A.
945.06
-005
37.50A.
625.71
100
35
Z
Z
Pt. -006
Pt. 71.25A.
Prentiss
851-555
596-471
18-E
SEE
R/
7-31-86
APPROVED
LORAIN CO.
MAP DEPT.
DATE 9-18-68
18-F
BY J Grace