#21062

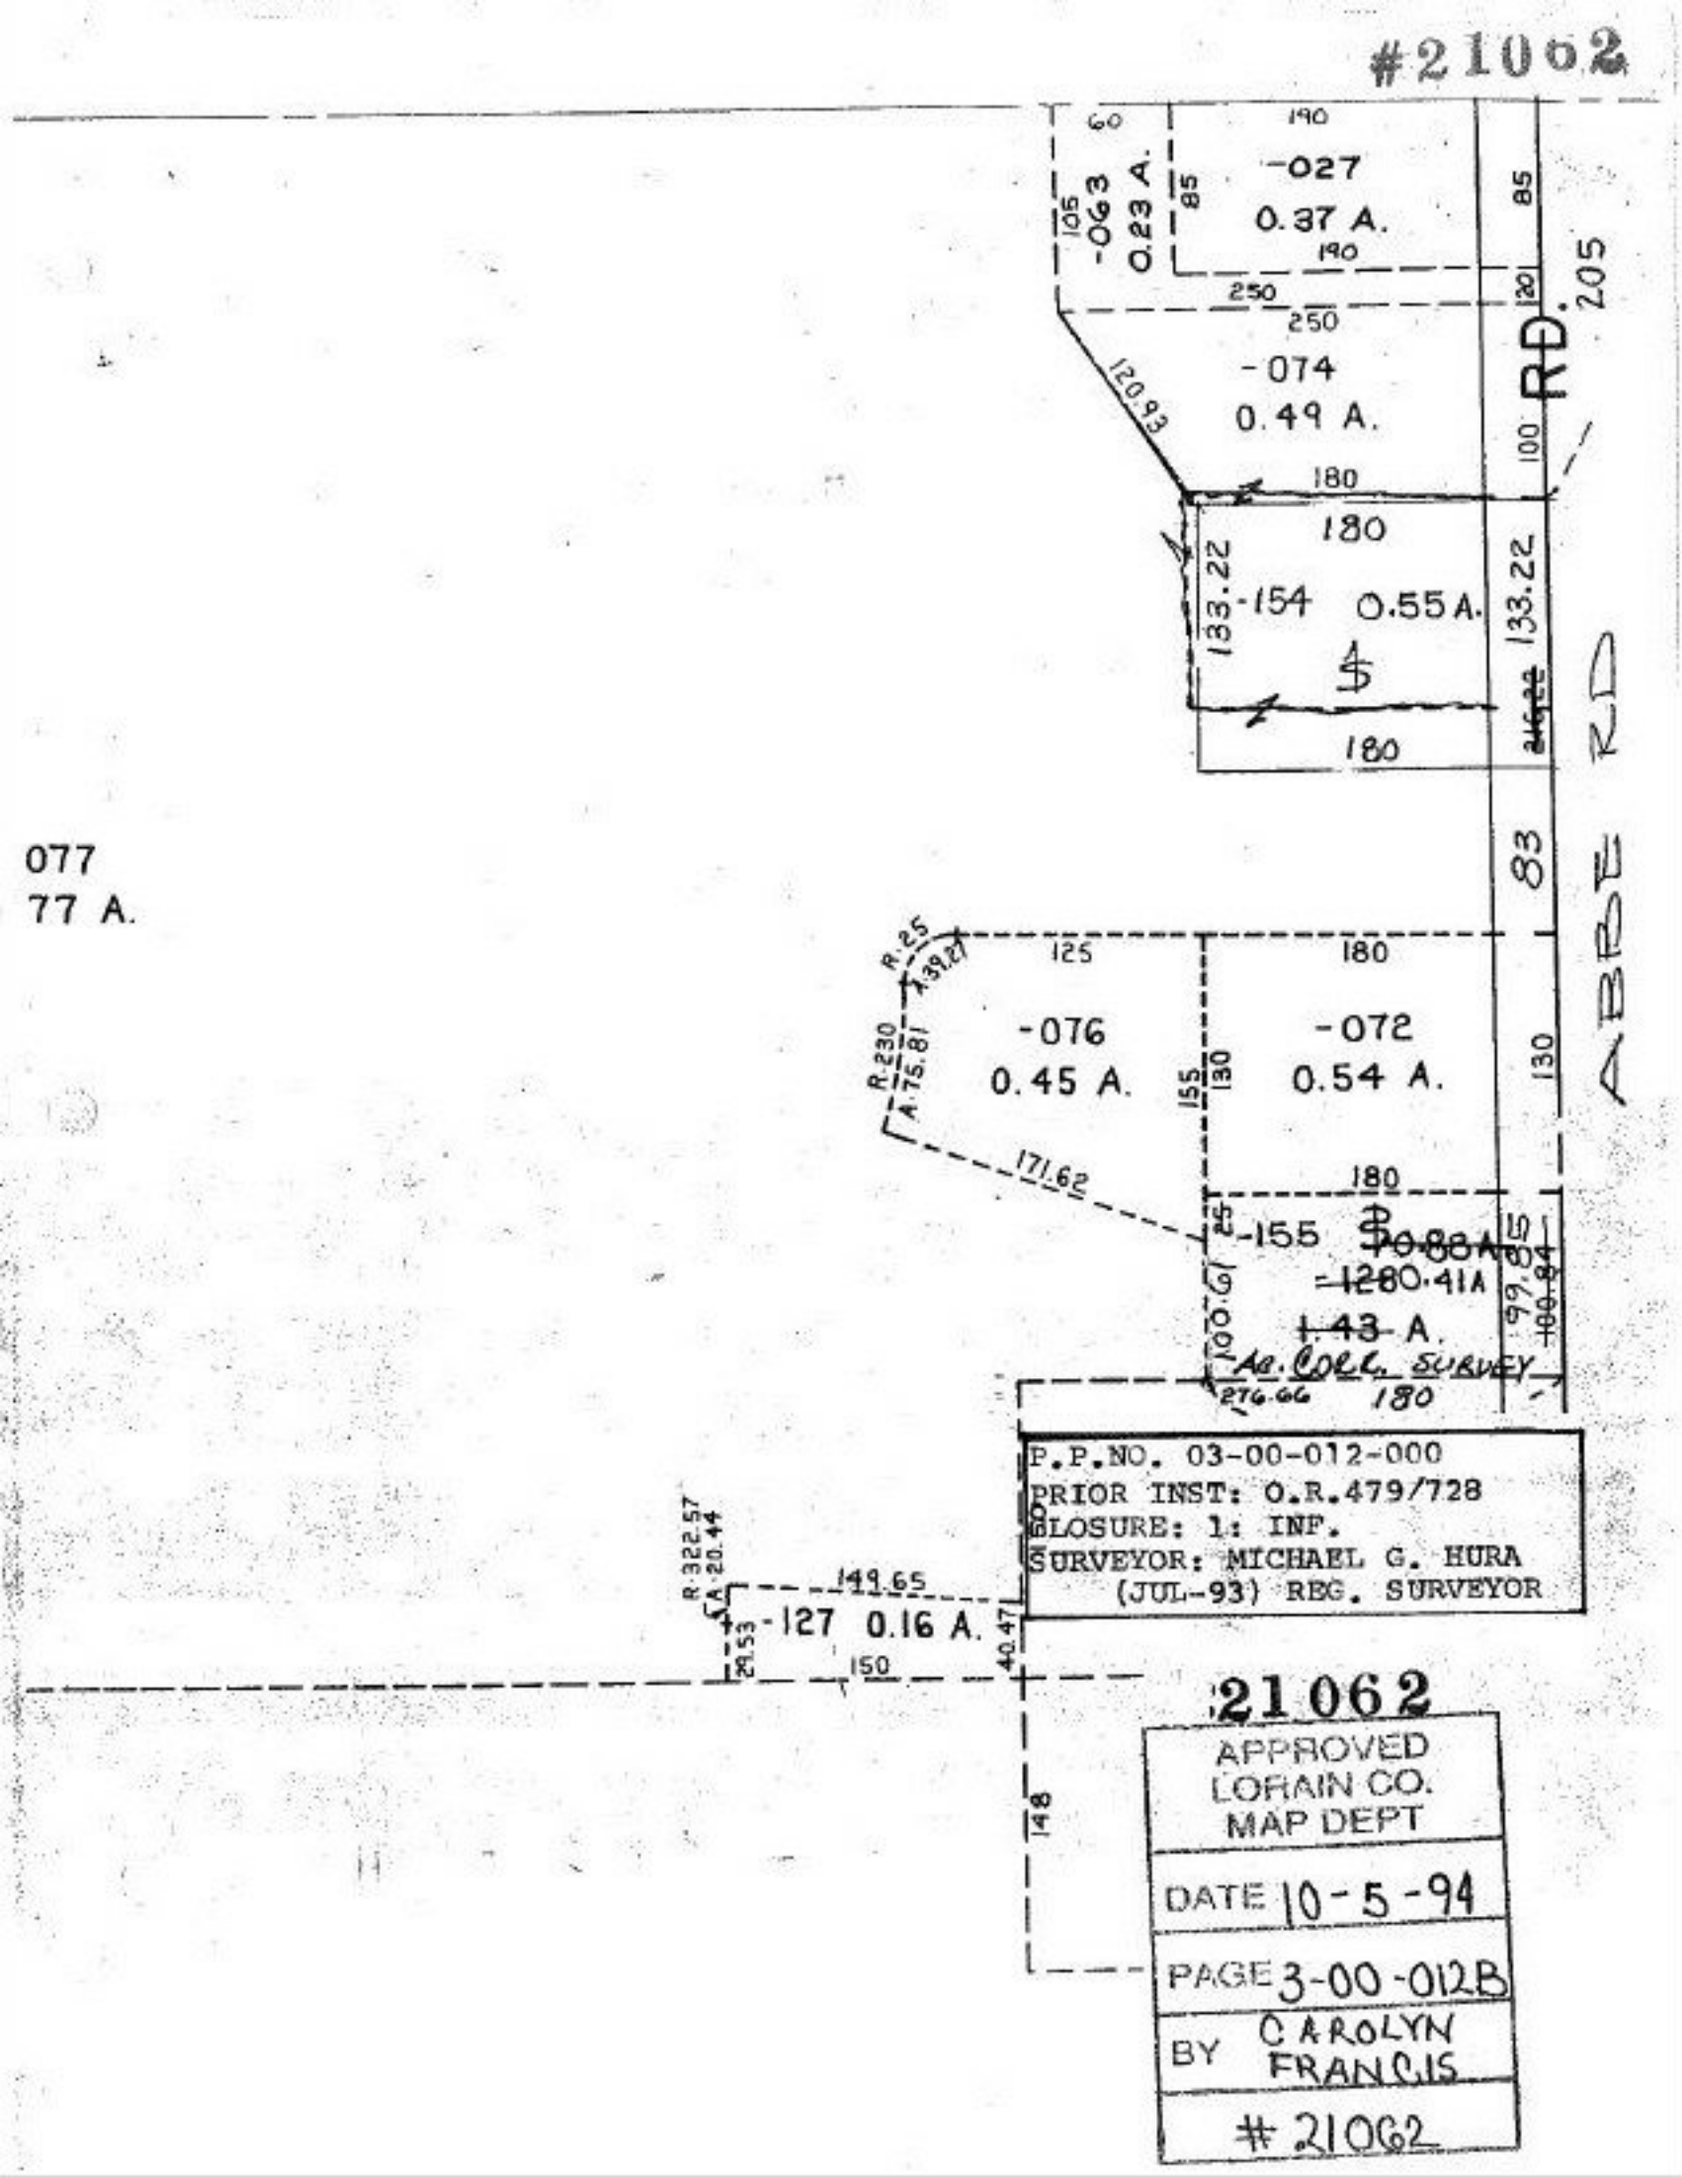

#21062

APPROVED
LORAIN CO.
MAP DEPT

DATE 10-5-94

PAGE 3-00-012B

BY CAROLYN FRANCIS

#21062