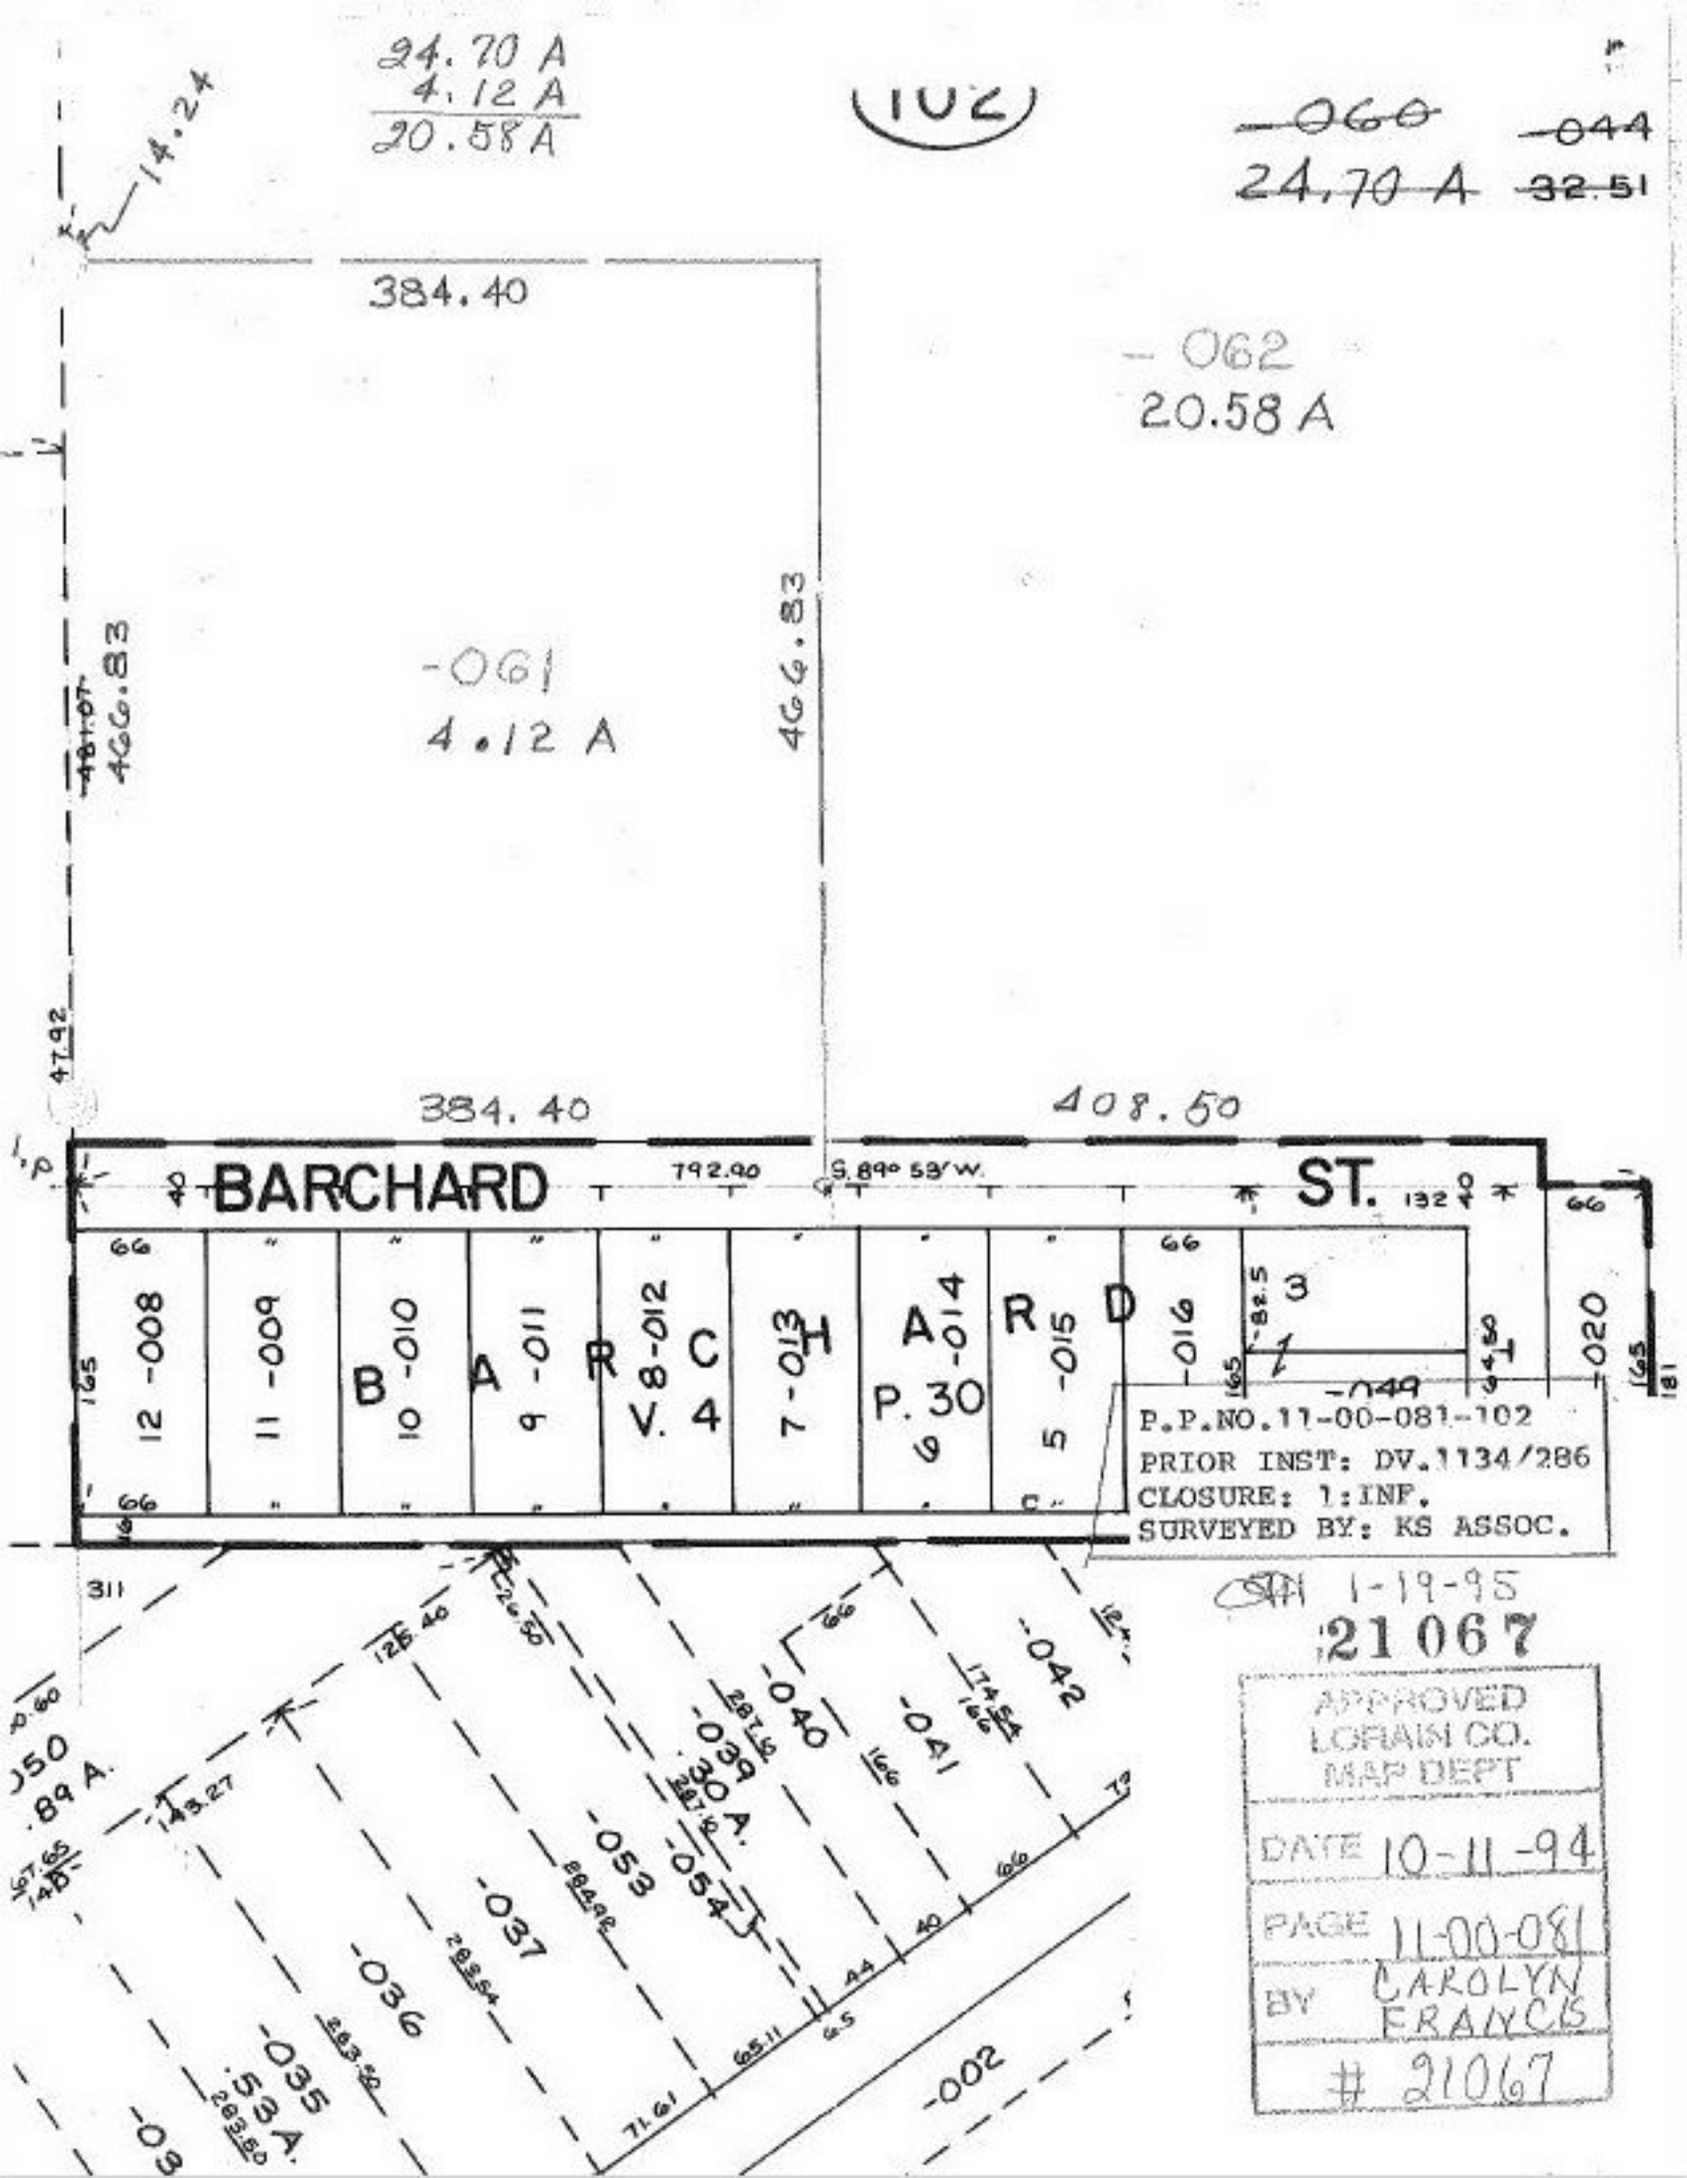
24.70 A
4.12 A
20.58 A
(102)
-060
24.70 A
-044
32.51
14.24
384.40
-062
20.58 A
-061
4.12 A
466.83
481.07
466.83
47.92
384.40
408.50
BARCHARD
792.90
S. 89° 58' W.
ST.
132.0
12 -008
11 -009
10 -010
9 -011
8-012
7-013
6 -014
5 -015
-016
3
-020
-049
P.P.NO.11-00-081-102
PRIOR INST: DV.1134/286
CLOSURE: 1:INF.
SURVEYED BY: KS ASSOC.
1-19-95
21067
APPROVED
LORAIN CO.
MAP DEPT
DATE 10-11-94
PAGE 11-00-081
BY CAROLYN FRANCIS
21067
-042
-041
-040
-039
-054
-053
-037
-036
-035
-002