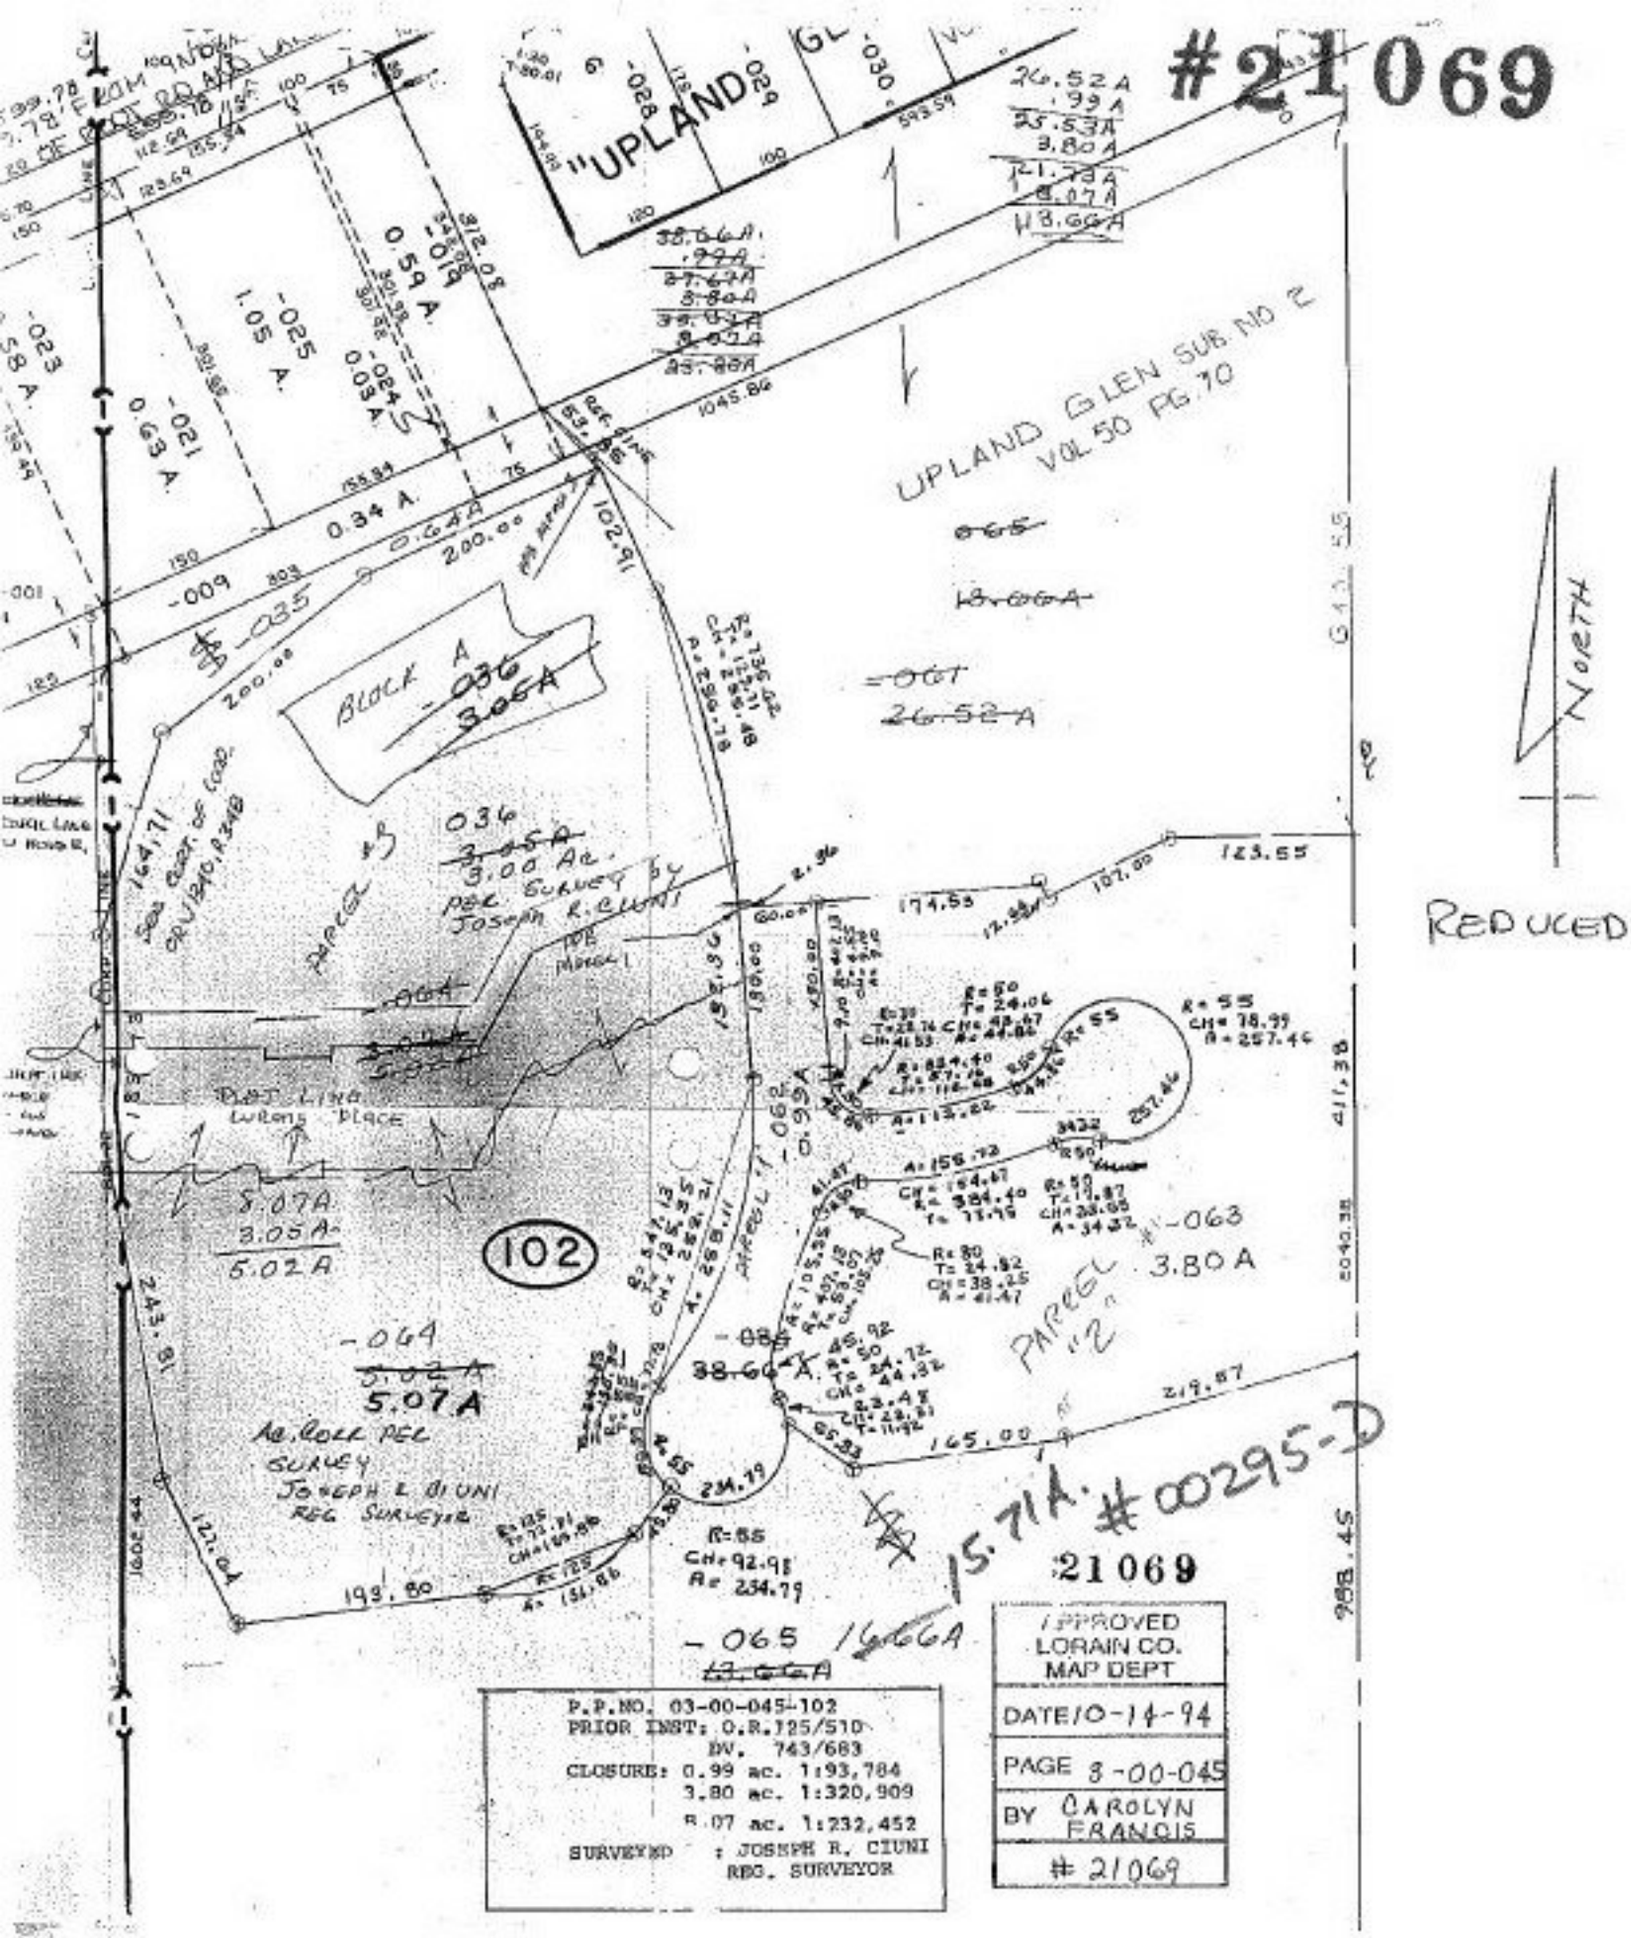
#21069
"UPLAND"
UPLAND GLEN SUB NO 2
VOL 50 PG 70
BLOCK A
-036
3.05A
-035
-061
26.52 A
-064
5.07A
-063
3.80 A
PARCEL "2"
102
15.71A. #00295-D
-065 16.66A
NORTH
REDUCED
21069
P.P.NO. 03-00-045-102
PRIOR INST: O.R.125/510
DV. 743/683
CLOSURE: 0.99 ac. 1:93,784
3.80 ac. 1:320,909
8.07 ac. 1:232,452
SURVEYED : JOSEPH R. CIUNI
REG. SURVEYOR
APPROVED
LORAIN CO.
MAP DEPT
DATE 10-14-94
PAGE 3-00-045
BY CAROLYN FRANCIS
21069