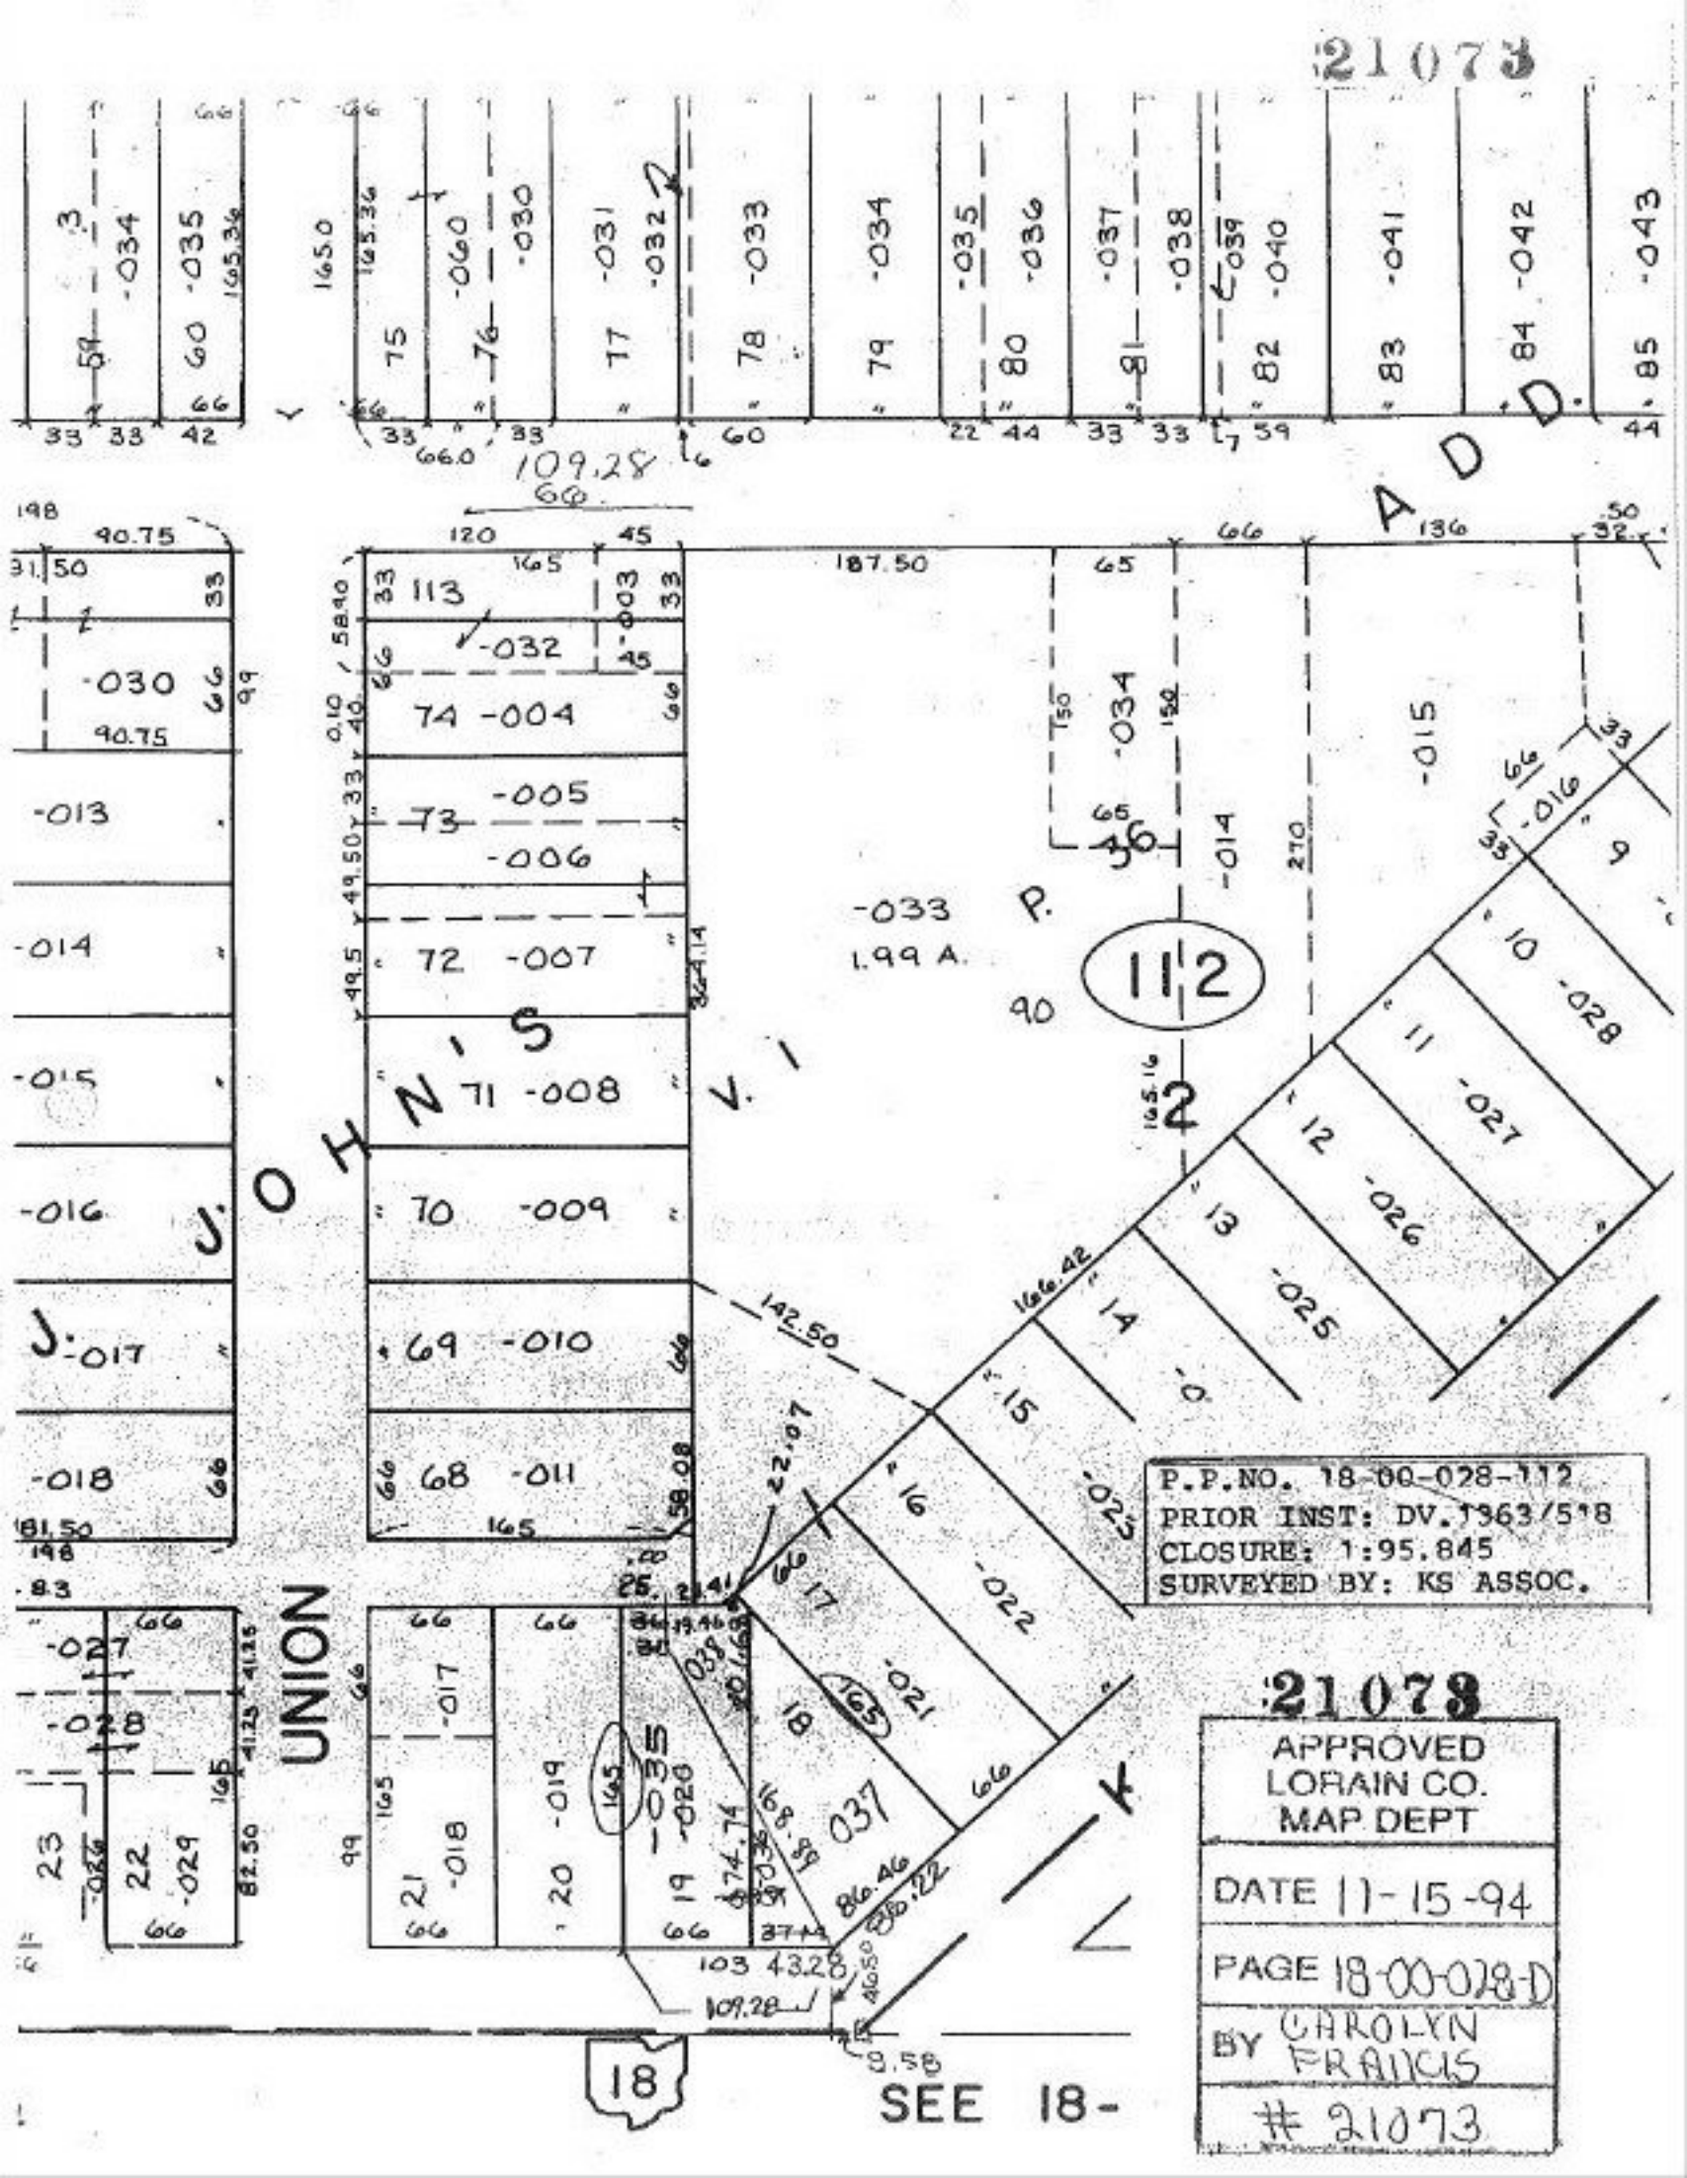
21073
ADD.
J. OHNS
V.
UNION
K
P.
1.99 A.
-033
-034
-035
-036
-037
-038
-039
-040
-041
-042
-043
-030
-031
-032
-013
-014
-015
-016
-017
-018
-027
-028
-029
-004
-005
-006
-007
-008
-009
-010
-011
-012
-021
-022
-025
-026
-003
-002
-001
-035
-020
-019
-017
-018
-023
-024
P.P.NO. 18-00-028-112
PRIOR INST: DV.1363/518
CLOSURE: 1:95,845
SURVEYED BY: KS ASSOC.
21078
APPROVED
LORAIN CO.
MAP DEPT
DATE 11-15-94
PAGE 18-00-028-D
BY CAROLYN FRANCIS
21073
SEE 18-
18