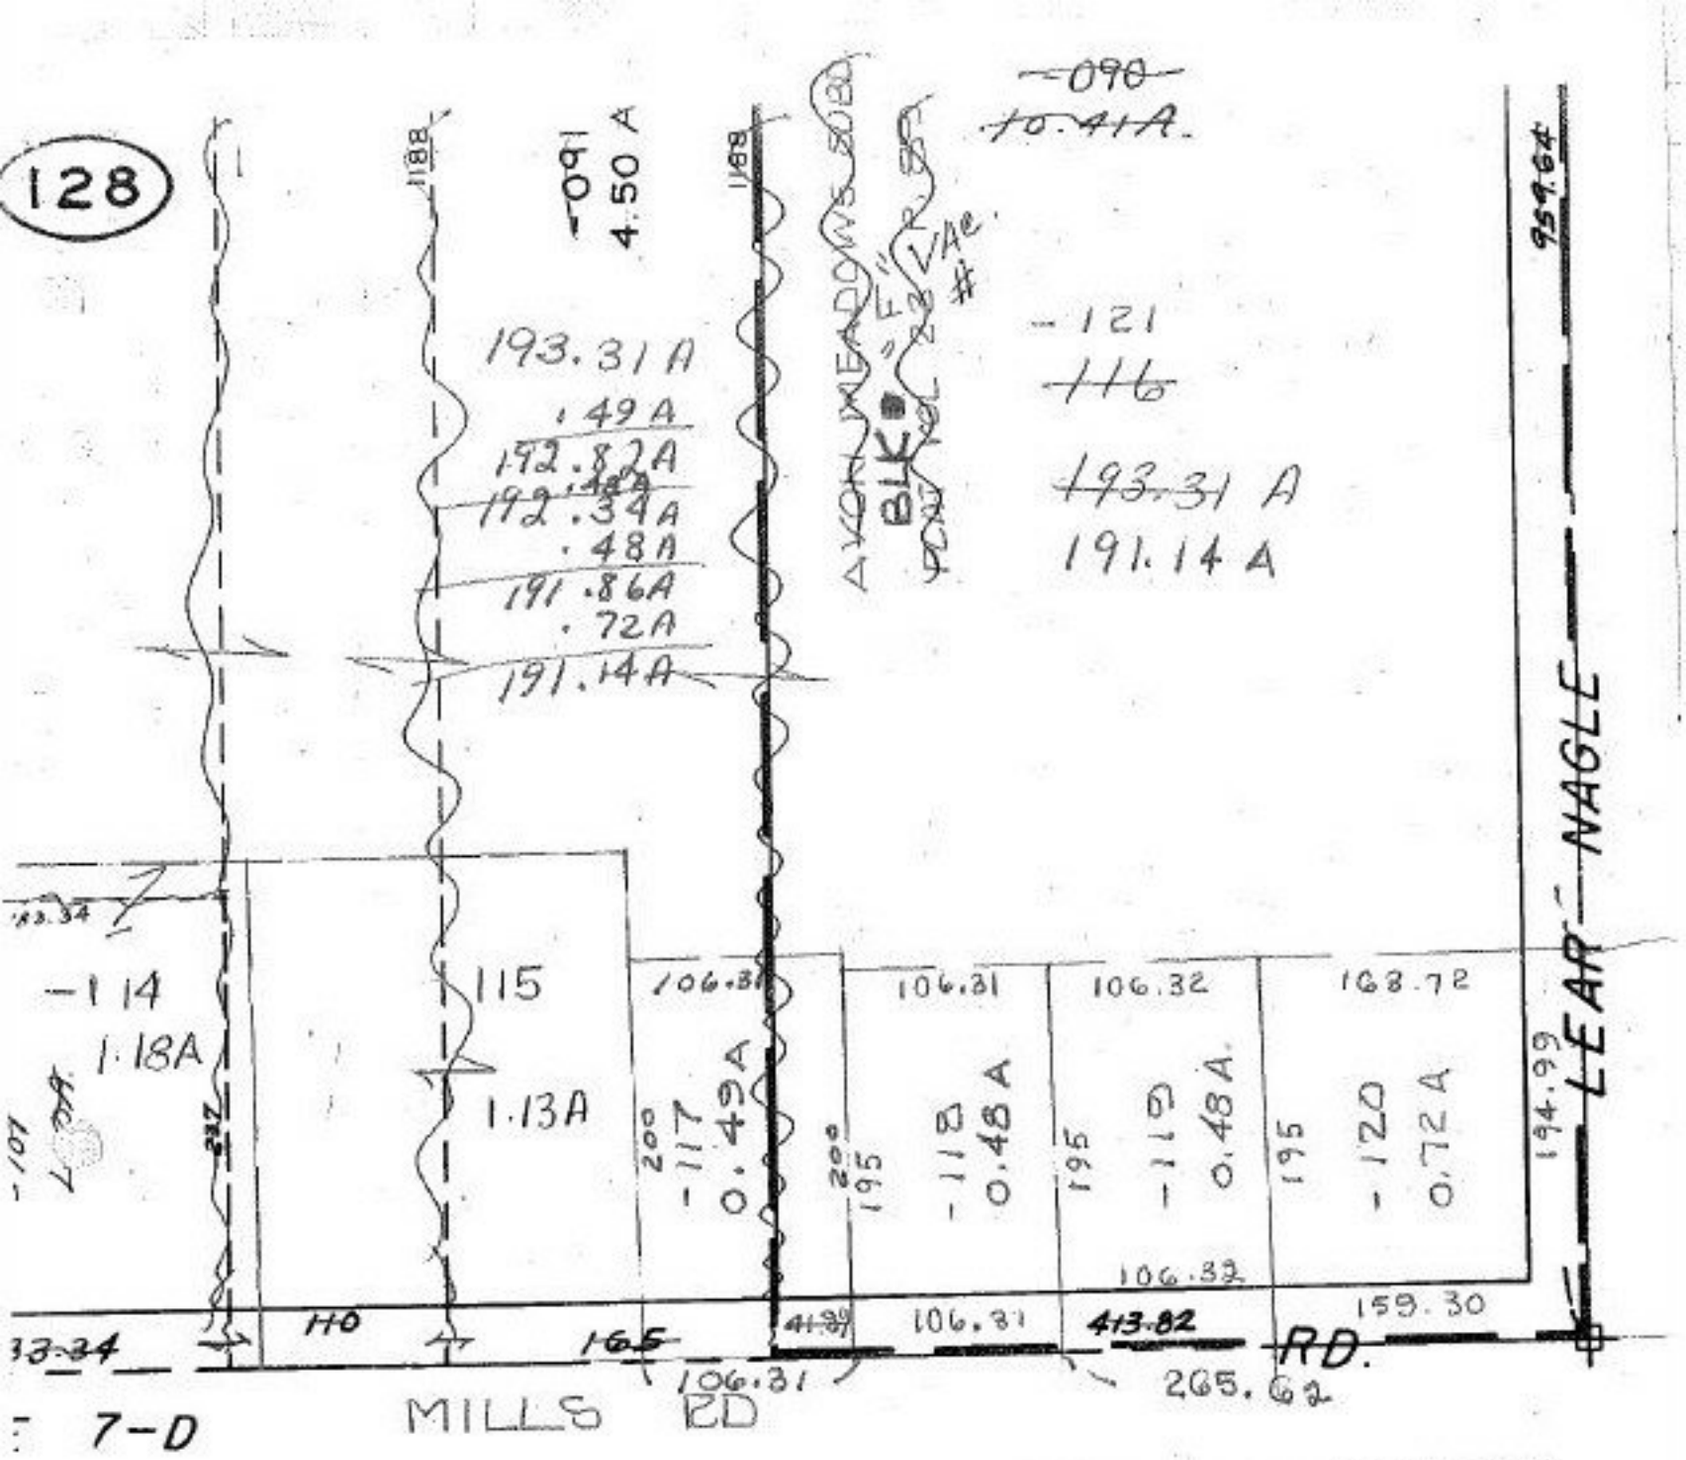

P.P.NO. 04-00-024-128-
PRIOR INST: O.R.911/805
CLOSURE: 1,2,3 1:INF.
0.72 ac. 89.824
SURVEYED BY: JAMES A. FAETANINI-JOHN HANCOCK & ASSOC.

E 1/2 SE 1/4 SEC

21075

4/24/95

APPROVED
LORAIN CO.
MAP DEPT
DATE 10-27-94
PAGE 4-00-024 H
BY CAROLYN FRANCIS
21075