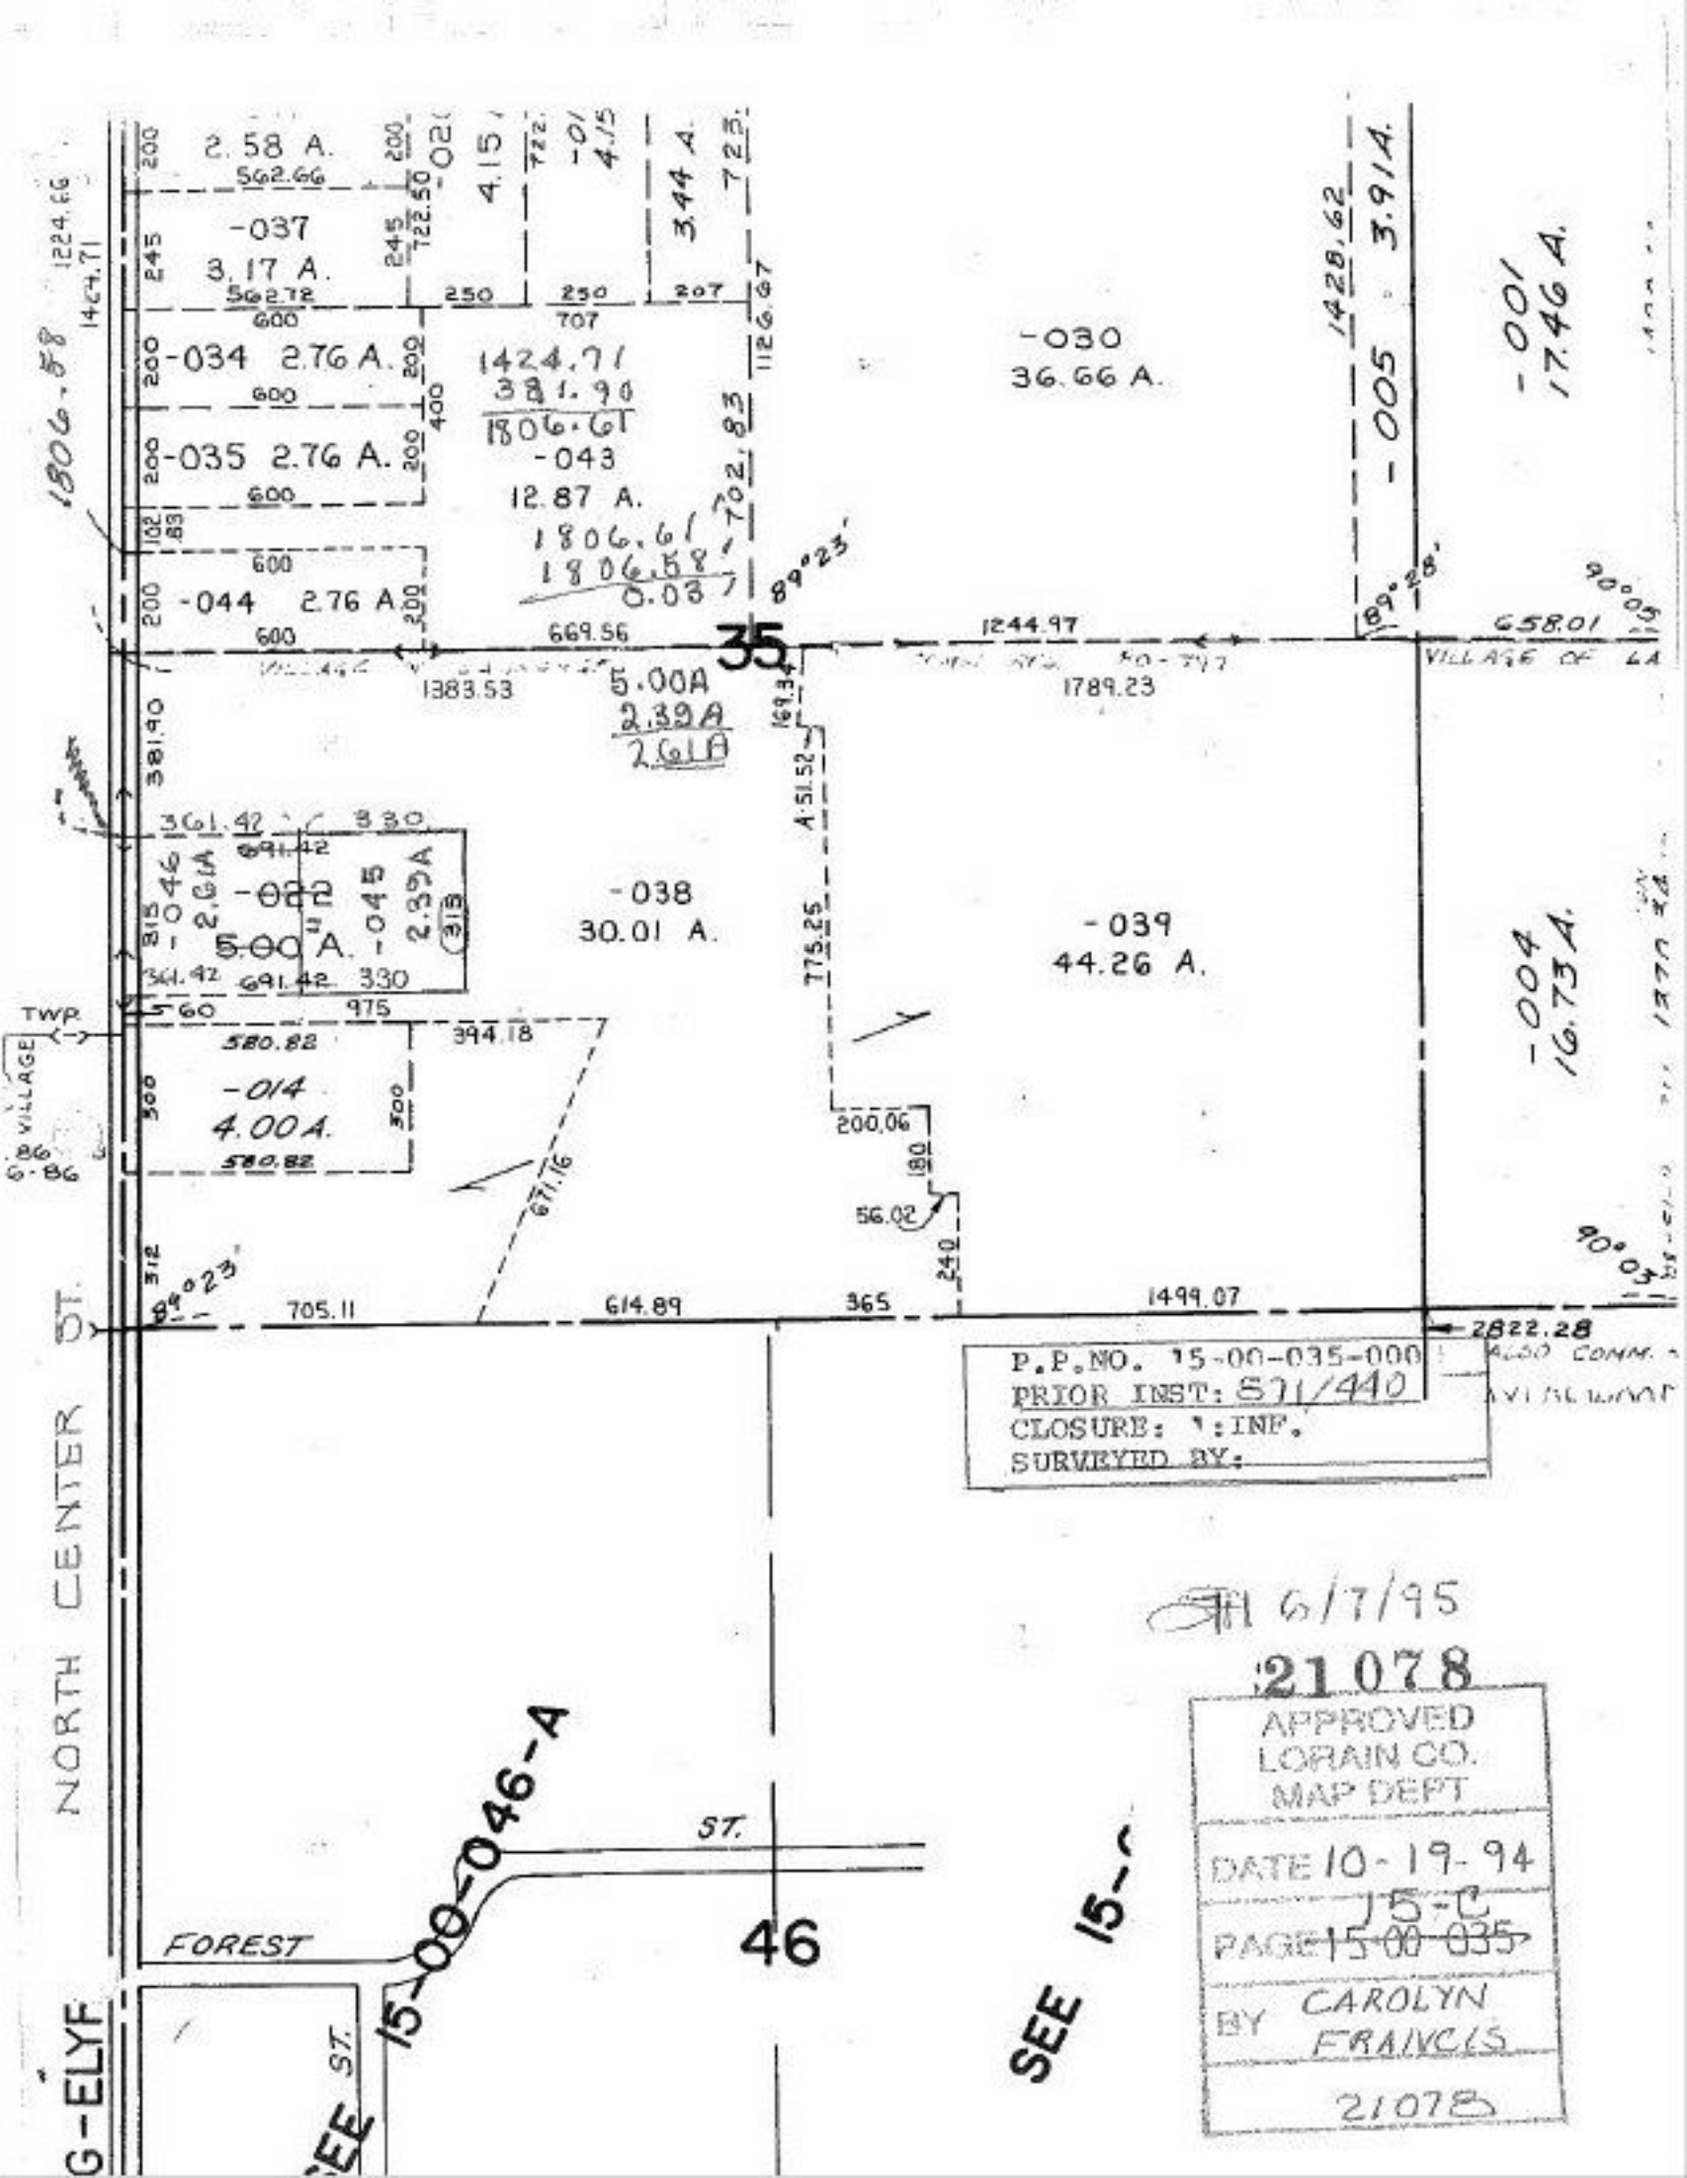

2.58 A.
562.66
-037
3.17 A.
562.72
-034 2.76 A.
-035 2.76 A.
-044 2.76 A.
1424.71
381.90
1806.61
-043
12.87 A.
1806.61
1806.58
0.03
-030
36.66 A.
-005 3.91 A.
-001
17.46 A.
1428.62
669.56
1244.97
658.01
35
1383.53
5.00A
2.39A
2.61A
1789.23
VILLAGE OF LA
-038
30.01 A.
-039
44.26 A.
-004
16.73 A.
-022
5.00 A.
-046
2.61A
-045
2.39A
-014
4.00 A.
580.82
394.18
775.25
200.06
56.02
705.11
614.89
365
1499.07
2822.28
TWP.
VILLAGE
NORTH CENTER ST.
P.P.NO. 15-00-035-000
PRIOR INST: 571/440
CLOSURE: 1:INF.
SURVEYED BY:
6/7/95
21078
APPROVED
LORAIN CO.
MAP DEPT
DATE 10-19-94
15-C
PAGE 15-00-035
BY CAROLYN FRANCIS
21078
ST.
FOREST
46
15-00-046-A
SEE 15-C
G-ELYF