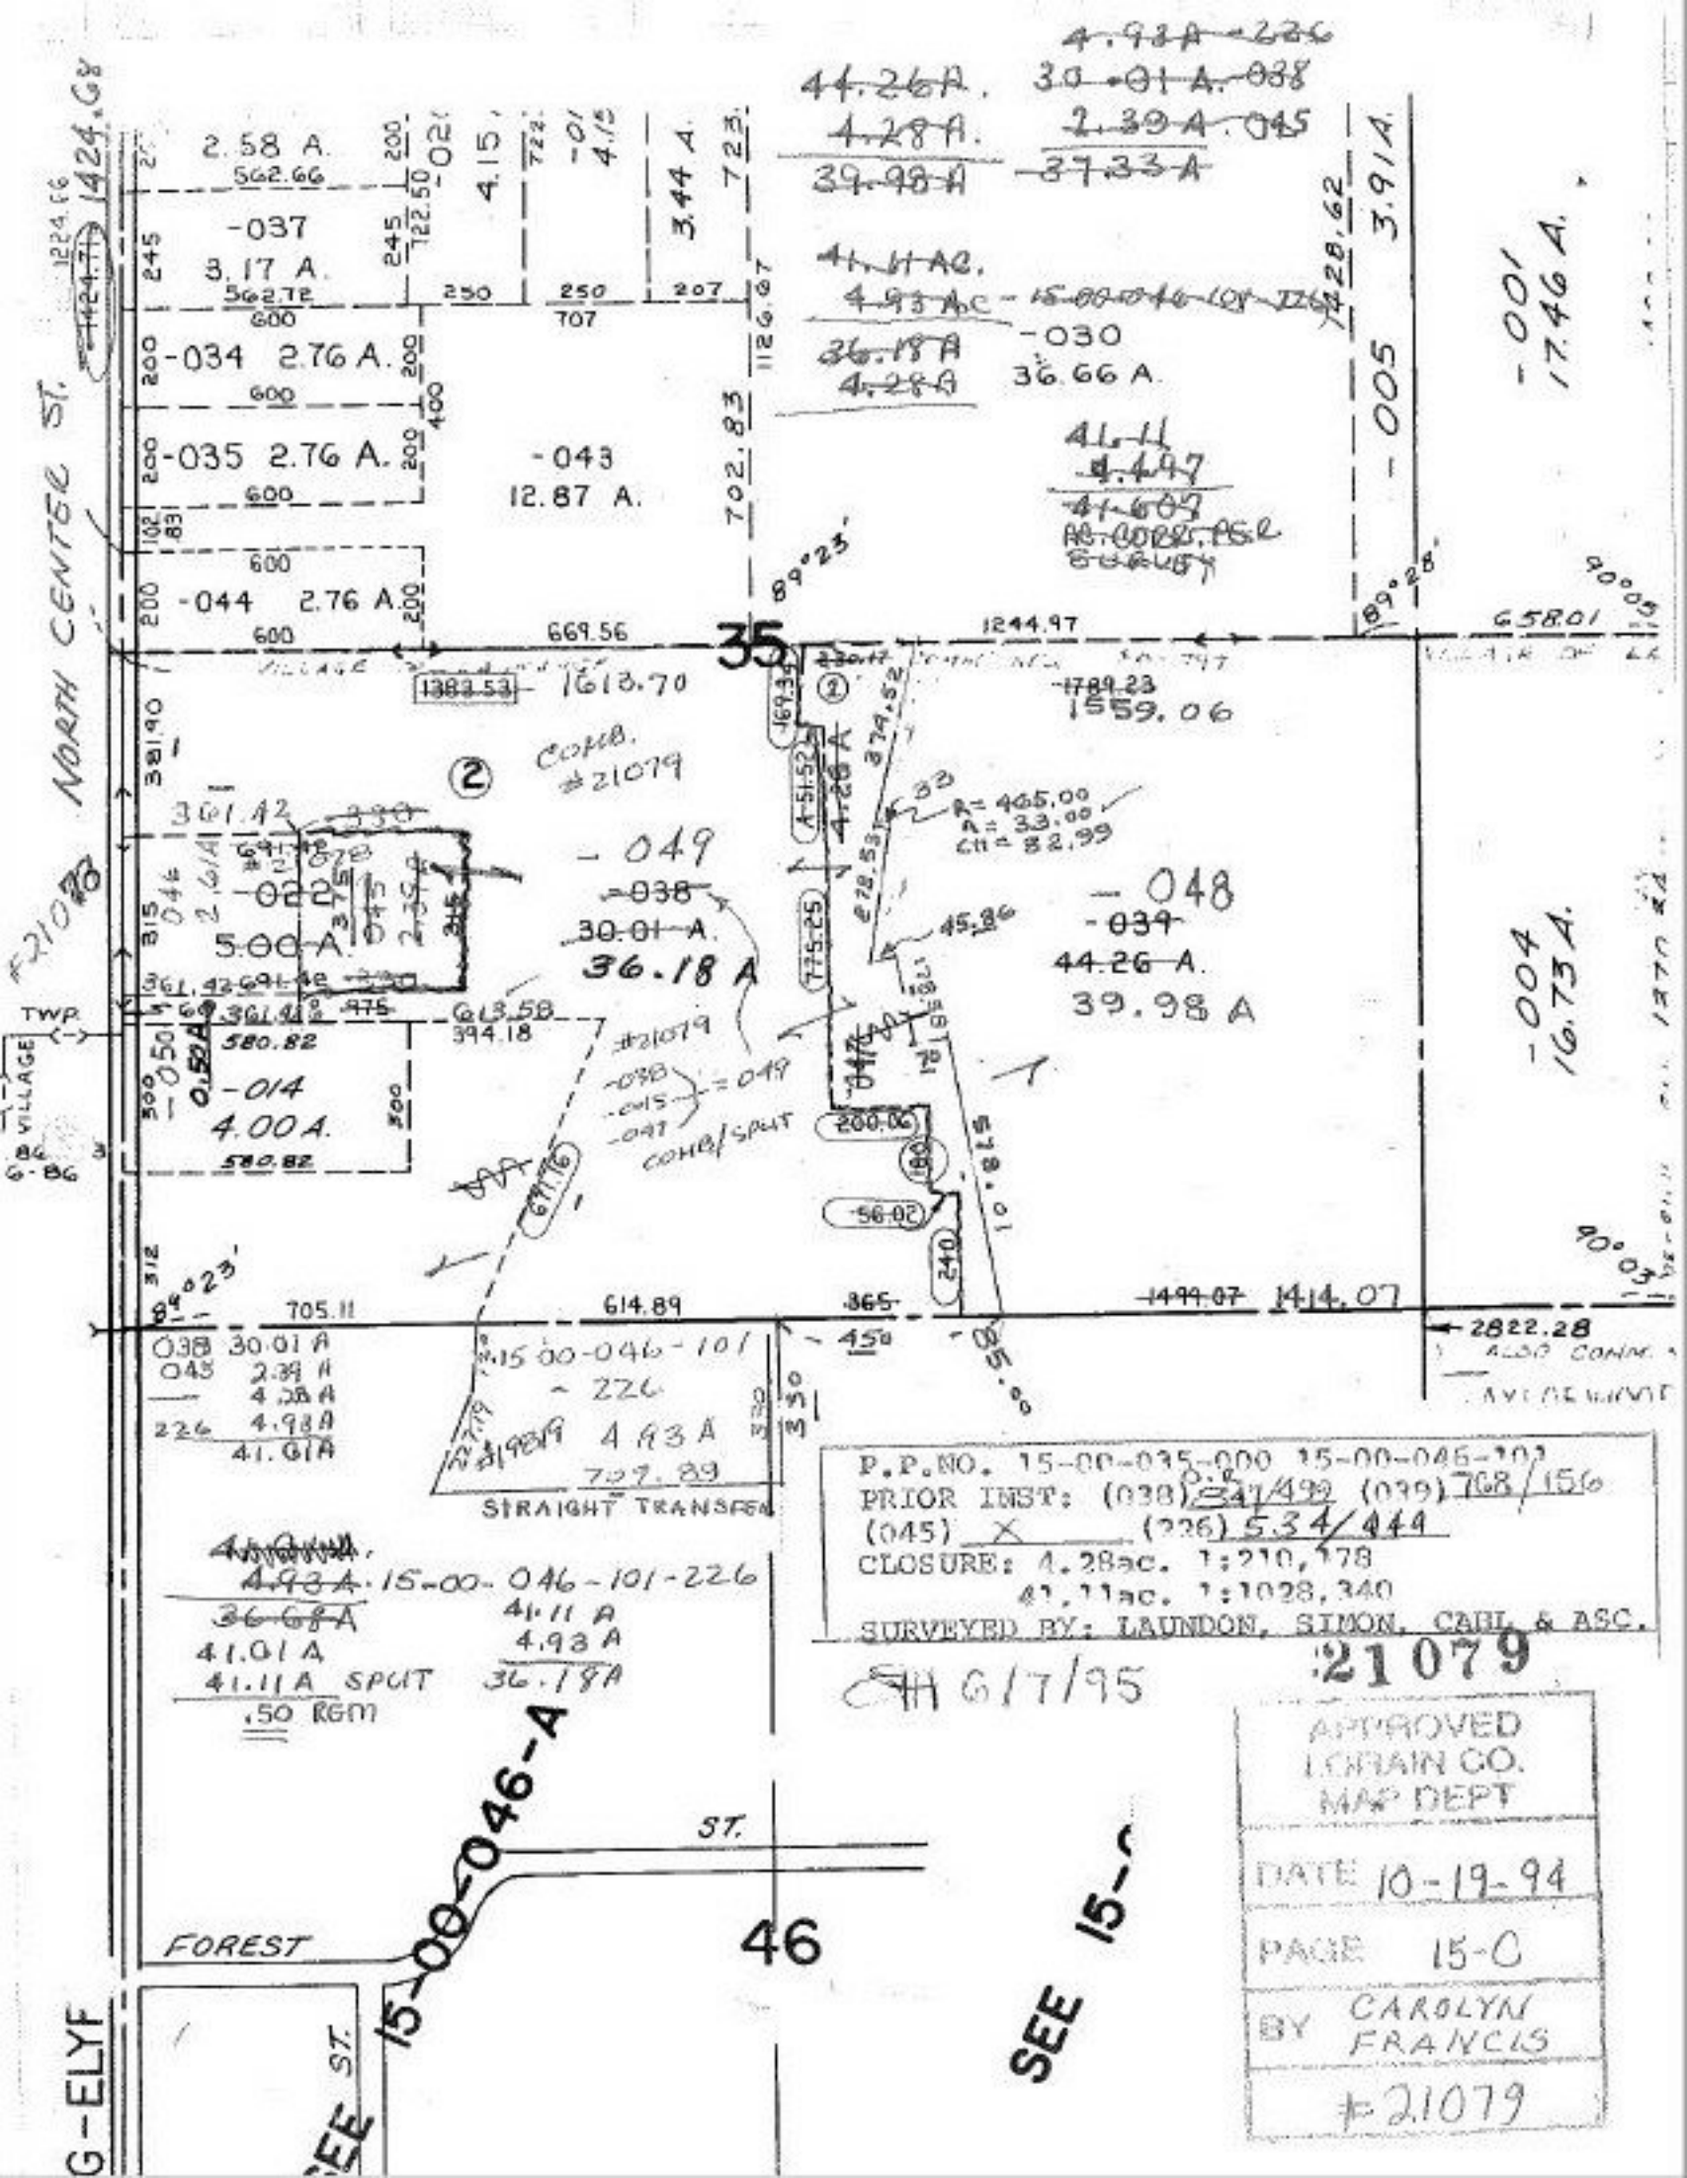
NORTH CENTER ST.
-037
3.17 A.
-034 2.76 A.
-035 2.76 A.
-044 2.76 A.
-043
12.87 A.
2.58 A.
4.15 A.
3.44 A.
-001
17.46 A.
-005
3.91 A.
-004
16.73 A.
-049
-038
30.01 A.
36.18 A
-048
-039
44.26 A.
39.98 A
-022
5.00 A.
-014
4.00 A.
-050
0.50 A.
35
46
TWP.
VILLAGE
669.56
1244.97
1383.53
1618.70
1789.23
1559.06
1424.68
1424.71
1224.06
1370.42
1499.07
1414.07
2822.28
705.11
614.89
707.89
Comb. #21079
#21079
COMB/SPLIT
STRAIGHT TRANSFER
P.P.NO. 15-00-035-000 15-00-046-101
PRIOR INST: (038) 347/492 (039) 768/156
(045) X (226) 534/444
CLOSURE: 4.28sec. 1:210,178
41.11sec. 1:1028,340
SURVEYED BY: LAUNDON, SIMON, CARL & ASC.
6/7/95
#21079
APPROVED
LORAIN CO.
MAP DEPT
DATE 10-19-94
PAGE 15-C
BY CAROLYN FRANCIS
#21079
FOREST ST.
SEE 15-
G-ELYF